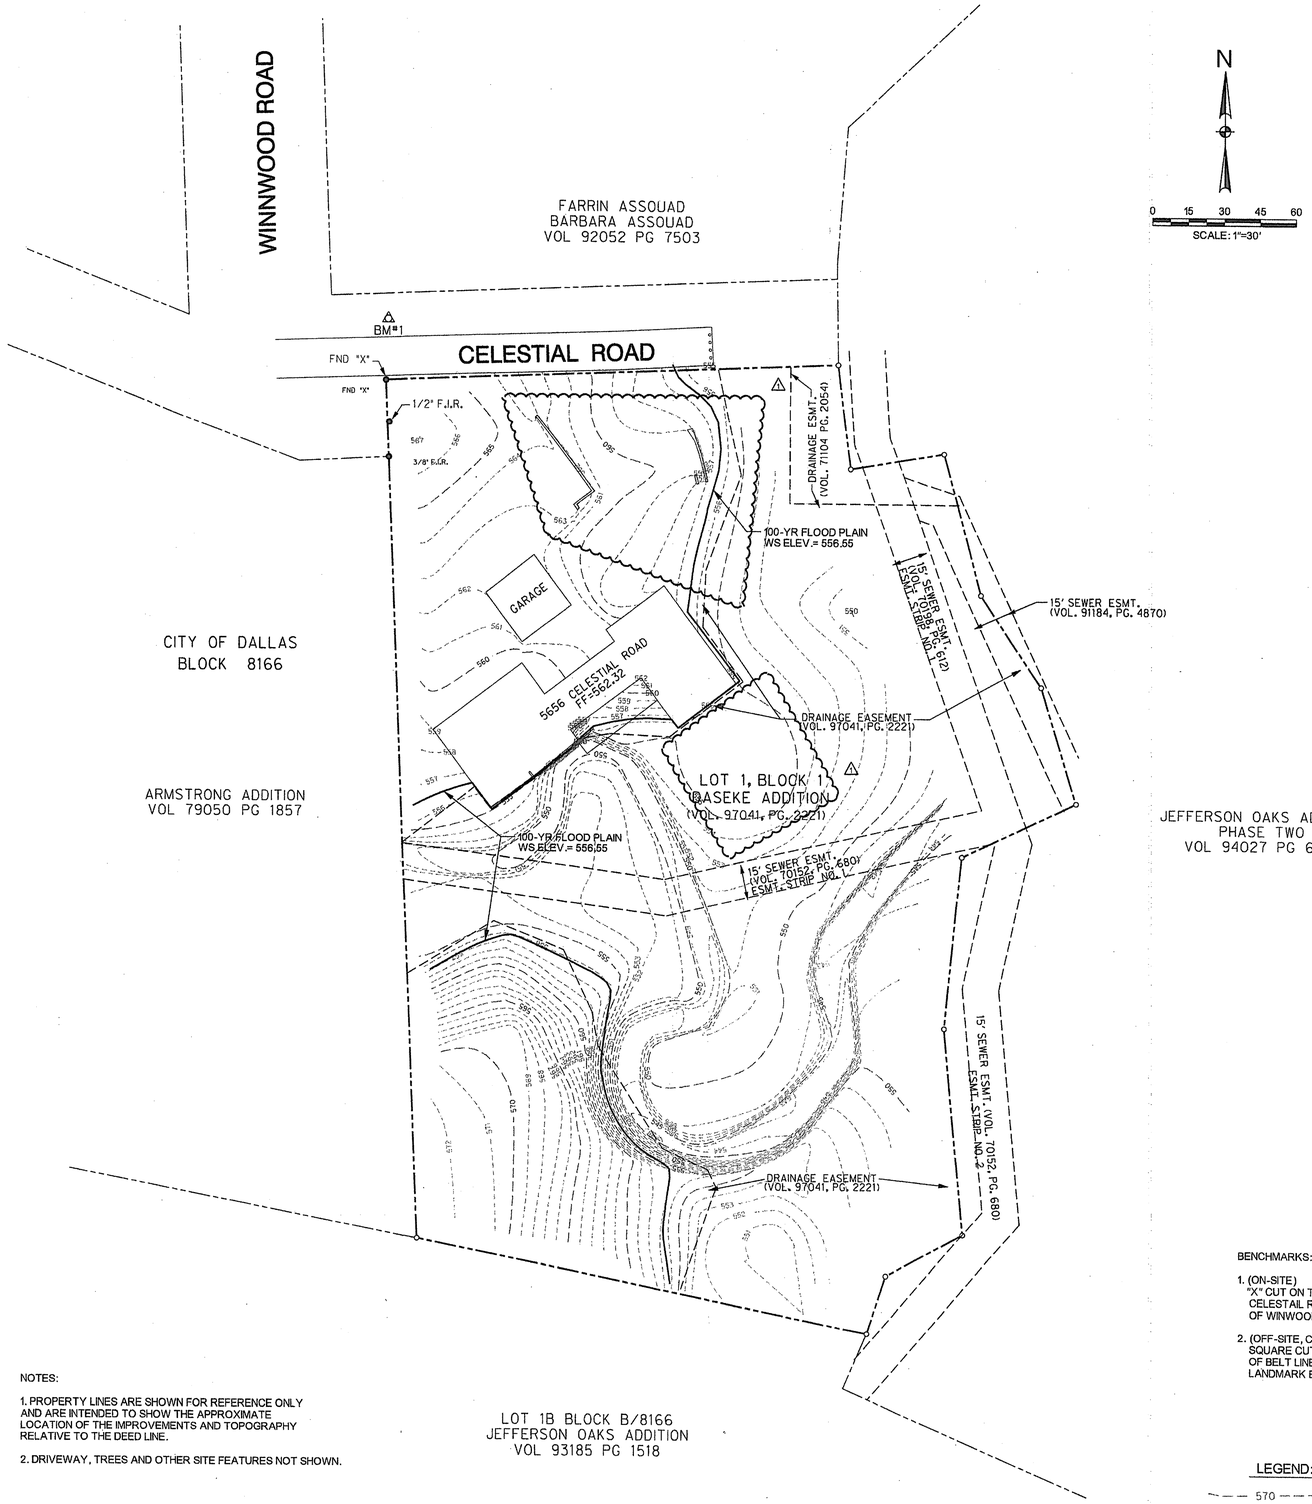

N

0 15 30 45 60
SCALE: 1"=30'

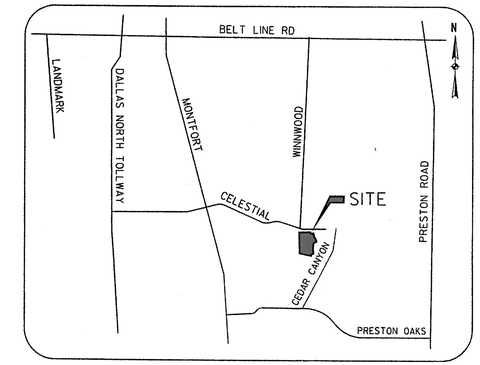

LOCATION MAP
N.T.S.

NOTES:

1. PROPERTY LINES ARE SHOWN FOR REFERENCE ONLY AND ARE INTENDED TO SHOW THE APPROXIMATE LOCATION OF THE IMPROVEMENTS AND TOPOGRAPHY RELATIVE TO THE DEED LINE.

2. DRIVEWAY, TREES AND OTHER SITE FEATURES NOT SHOWN.

BENCHMARKS:

1. (ON-SITE)
"X" CUT ON THE NORTH SIDE OF CELESTAIL ROAD AND EAST SIDE OF WINWOOD RD. ELEV.= 568.70

2. (OFF-SITE, CITY OF ADDISON)
SQUARE CUT ON INLET 400' +/- SOUTH OF BELT LINE ROAD, EAST SIDE OF LANDMARK BLVD. ELEV.= 638.13

LEGEND:

570	EXISTING CONTOUR
	100-YR. WATER SURFACE ELEV.
NG 559.11 +	NATURAL GROUND ELEVATION
WD 562.03 +	WOODEN DECK ELEVATION

1 REVISED FOR PERMIT AND CONSTRUCTION 09-27-2010

TOPOGRAPHIC SURVEY
PART OF
LOT 1, BLOCK 1
DASEKE ADDITION

AN ADDITION TO THE
CITY OF ADDISON, TEXAS

THOMAS GARVIN SURVEY, ABSTRACT NO. 524
DALLAS COUNTY, TEXAS

FOR

DON R. DASEKE
5656 CELESTIAL ROAD, ADDISON, TEXAS 75248

BY

HALFF®
TBPE FIRM #F-312
1201 NORTH BOWSER ROAD
RICHARDSON, TEXAS 75081-2275
TEL (214) 346-6200
FAX (214) 739-0095

OCTOBER 2009 AVO. 27431

i:\27000s\27431\cadd\C001-TM-27431.dgn