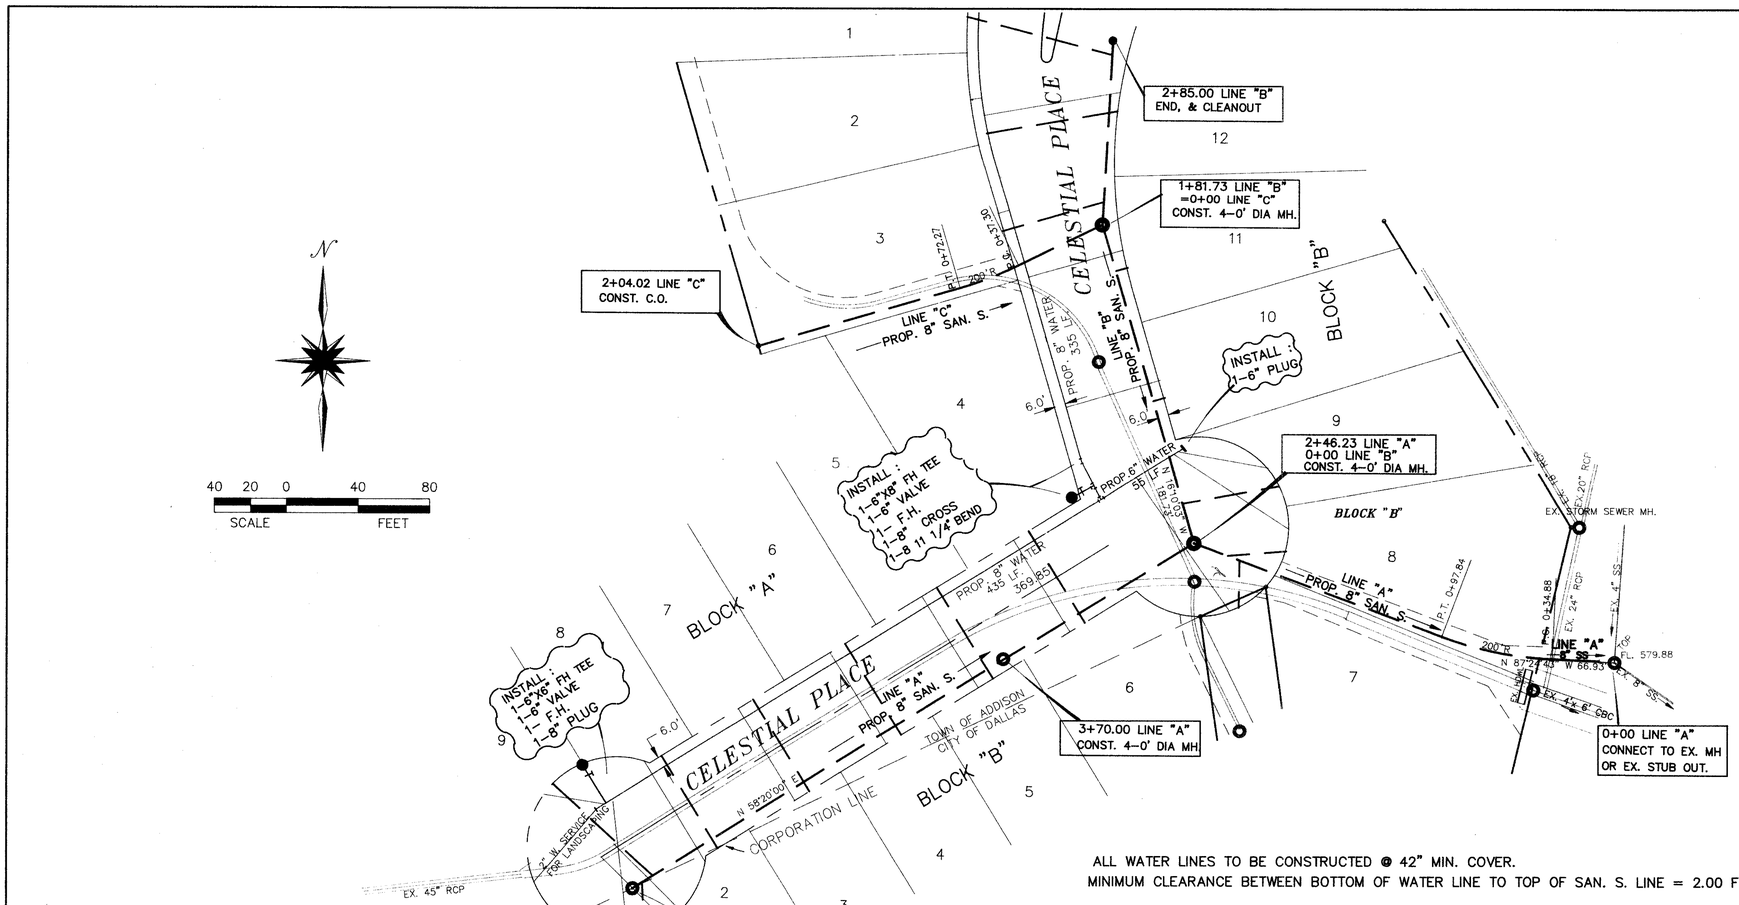

CONTRACTOR TO COMPLY WITH THE TOWN OF ADDISON STANDARD DETIALS AND SPECIFICATIONS FOR CONSTRUCTION OF WATER AND SANITARY SEWER

SEE DETAILS AND SPECS. SHEETS ATTACHED.

BENCH MARK:
CITY OF DALLAS WATER UTILITIES, SQUARE CUT ON CONCRETE BASE OF 6 FOOT BRICK WALL AT NORTHEAST CORNER OF CELESTIAL DRIVE AND MONTFORT , ELEVATION 626.81 FEET .

The engineer accepts no responsibility for the location, vertical or horizontal, of manholes, inlets, fire hydrants, cleanouts or valve boxes, unless inspected by the engineer prior to final placement. It shall be the responsibility of the contractor to notify the engineer when ready for inspection.

ALL WATER LINES TO BE CONSTRUCTED @ 42" MIN. COVER.
MINIMUM CLEARANCE BETWEEN BOTTOM OF WATER LINE TO TOP OF SAN. S. LINE = 2.00 FT. MIN.

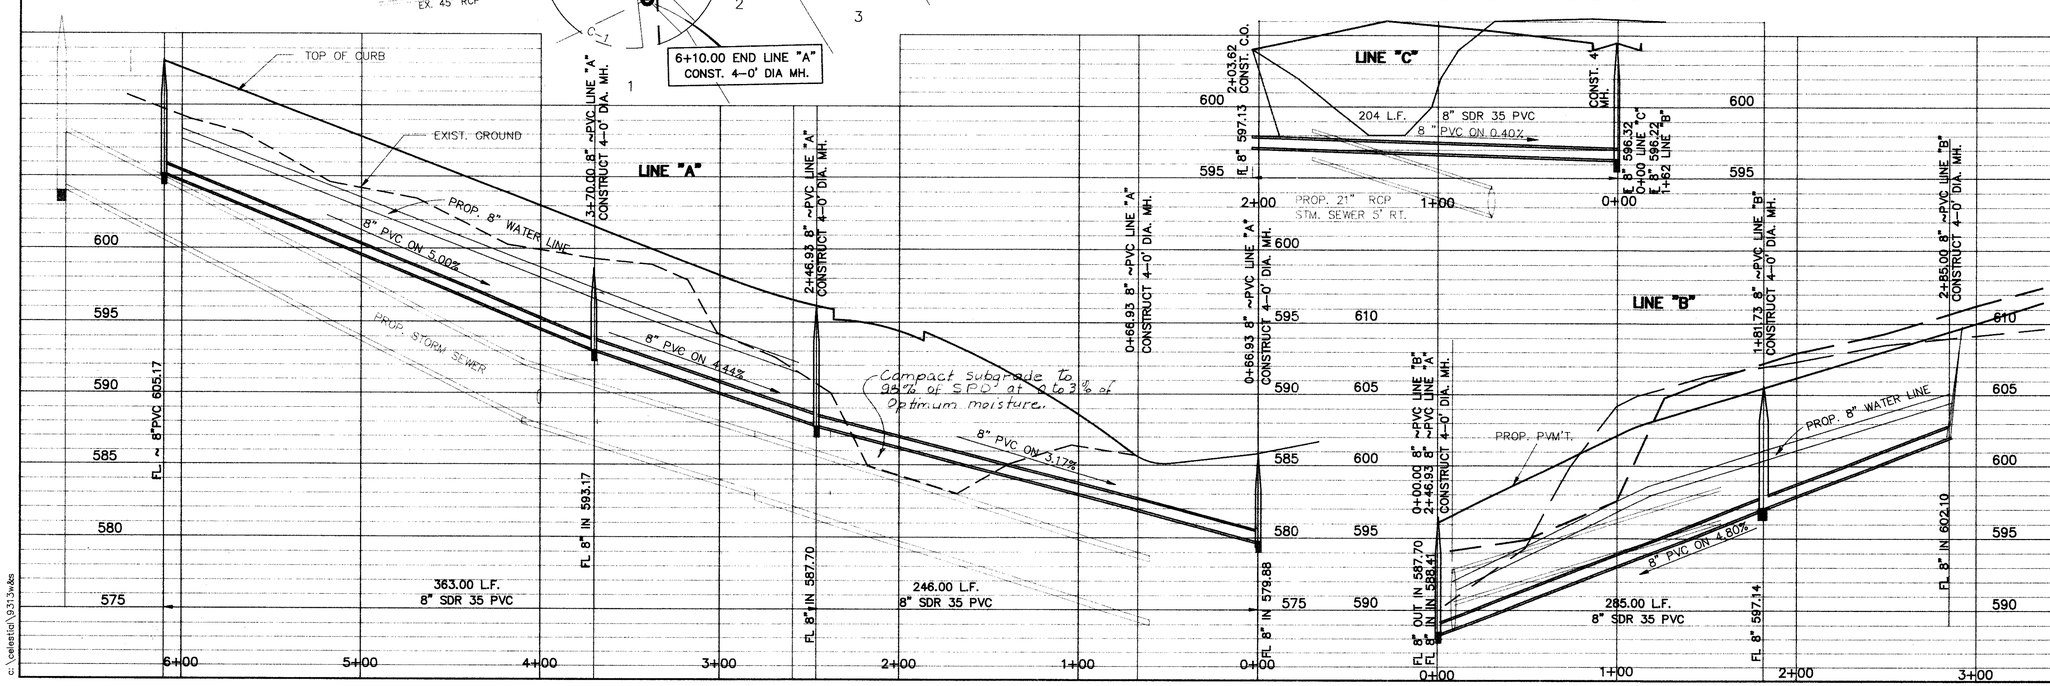

CELESTIAL PLACE					
ADDISON/DALLAS, TEXAS					
WATER & SAN. SEWER PROFILE					
ALLEGIANCE GROUP, INC.					
DAL-TECH ENGINEERING INC.					
1020 AUDELIA RD. SUITE C207, DALLAS, TEXAS PH. 553-5500					
DESIGN	DRAWN	DATE	SCALE	NOTES	SHEET
DAL-TECH	DAL-TECH	JANUARY 1994	H 1"=40' V 1"=5'	JOB NO. 9313 9313	7/13

c:\celestial\9313w.dgn