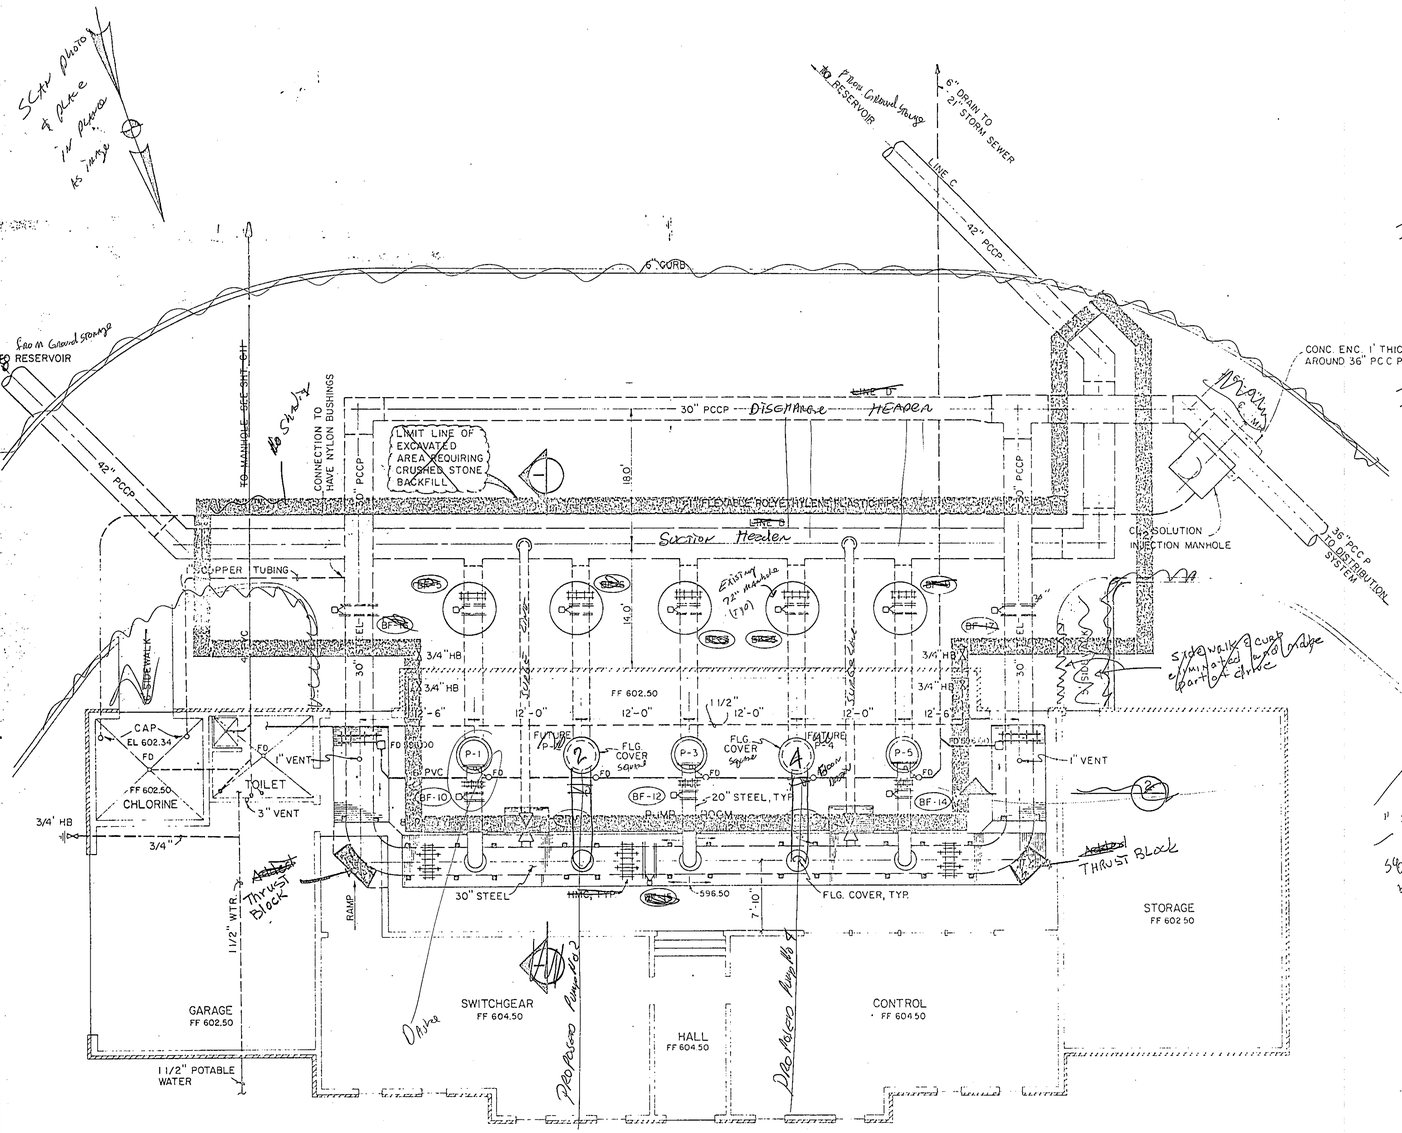

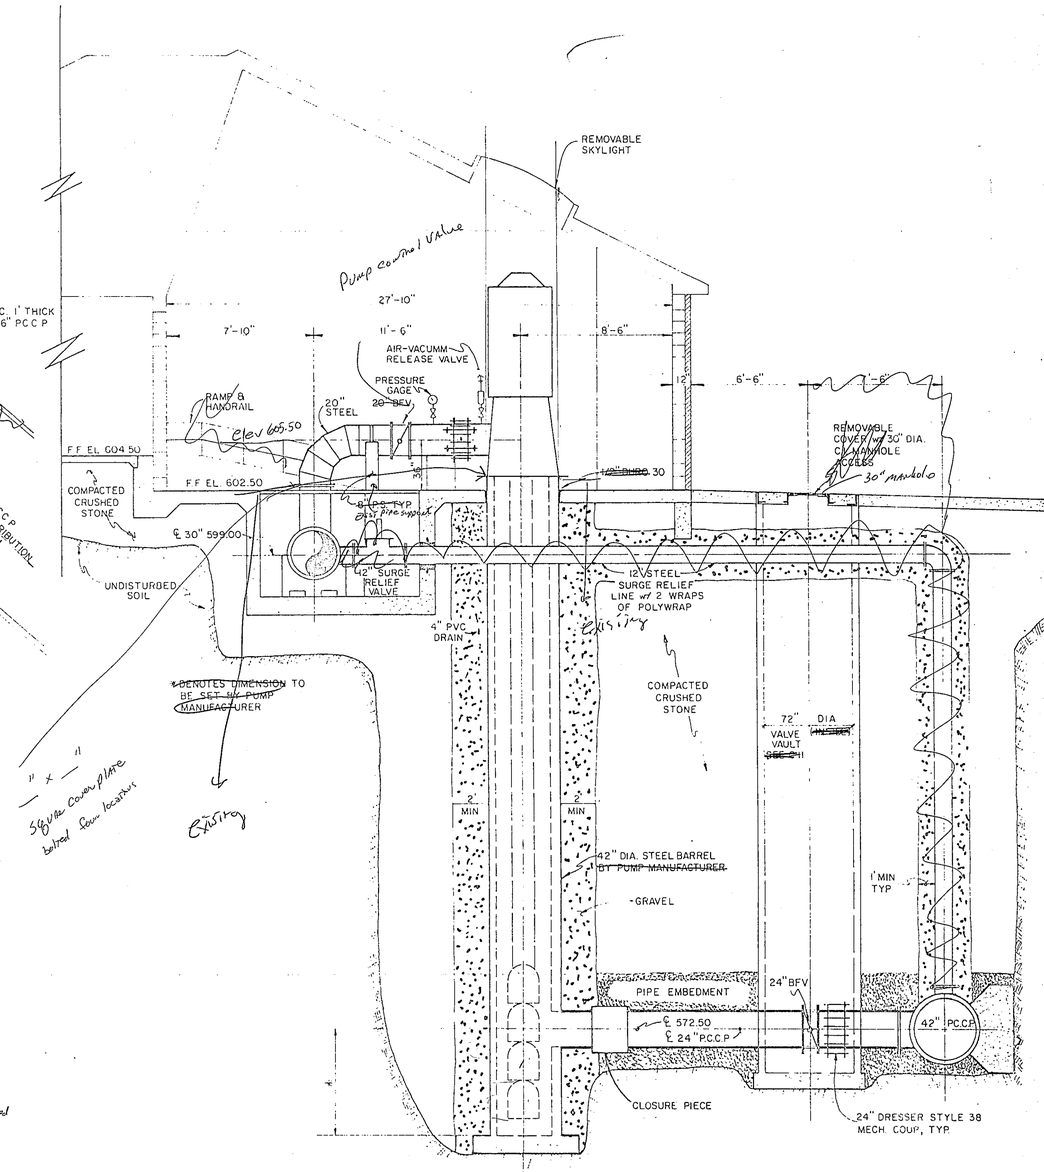

Typical Pump SECTION
1/4"=1'-0"

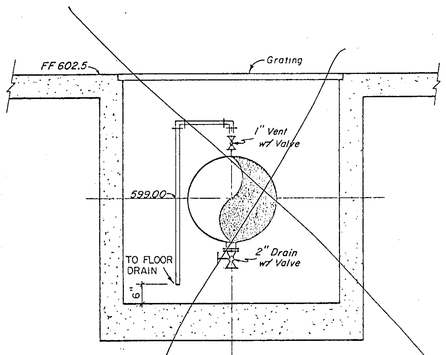

2 SECTION
1/2"=1'-0"

PIPING PLAN
1/8"=1'-0"

NOTE:
1. FOR STRUCTURAL DETAILS OF PIPE CHANNEL SEE SHT. S-5
2. PS DENOTES PIPE SUPPORT
3. SEE A-1 FOR BUILDING DIMENSIONS
4. CHLORINE ROOM SHALL BE PIPED FOR FUTURE CHLORINE EQUIPMENT. EXTEND PIPE MIN. 2' ABOVE FLOOR

1. Contractor shall run pump drains into floor drains. Pump drains shall be 2 inch schedule 40 PVC.

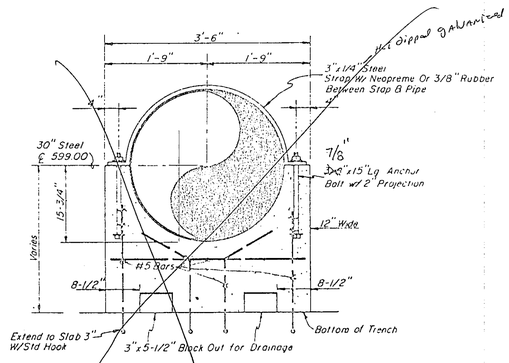

PIPE SUPPORT - 30" PIPE
NTS

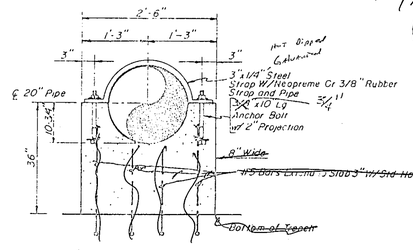

PIPE SUPPORT - 20" PIPE
NTS

No	Revision	By	Date

TOWN OF ADDISON
DALLAS COUNTY, TEXAS

CELESTIAL ROAD PUMP STATION

PIPING PLAN

GINN, INC.
Consulting Engineers Dallas, Texas

Designed - RCH	Drawn - GAF	Date - JAN., 1987	Job No. - 217
Approved - HWG	Checked - GAF	Scale - AS SHOWN	Sheet C-6 Of

Randall C. Hall
2-19-87