


36"ϕ INLET PIPE DETAIL




PLAN - CONCRETE EXTENSION

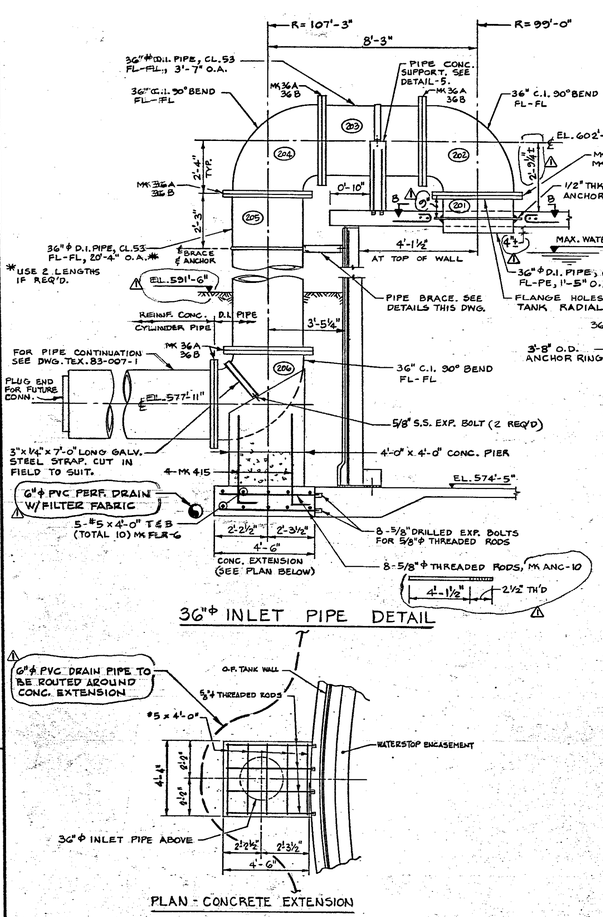


DETAIL - 5
(PIPE CONC. SUPPORT ON ROOF)




SECTION B-B

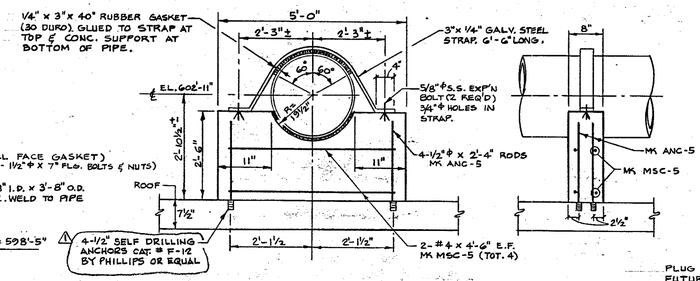


SONIC LEVEL TRANSMITTER DETAIL

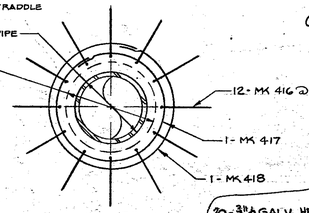


DETAIL - G

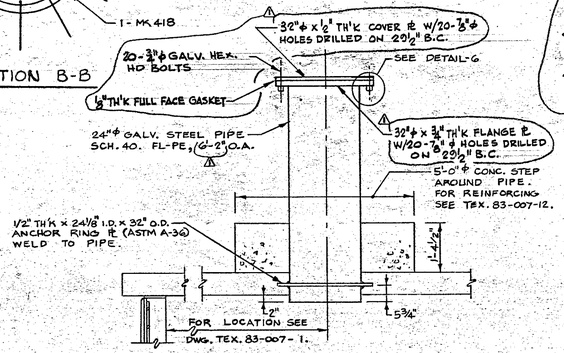


42"ϕ OUTLET PIPE DETAIL
(2 - REQUIRED)

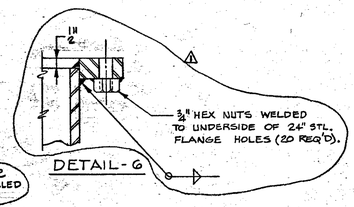


SECTION C-C

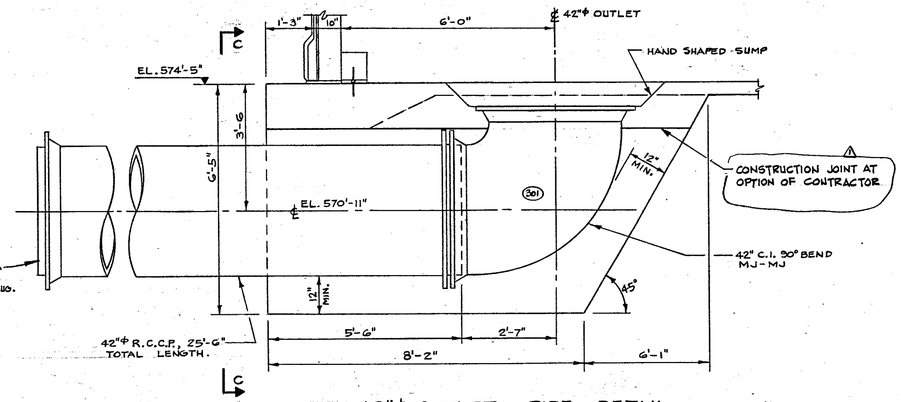


PLAN

MATERIAL
1. BRACES: STEEL SHOP GALV. AFTER FABRICATION
2. HARDWARE: STAINLESS STEEL

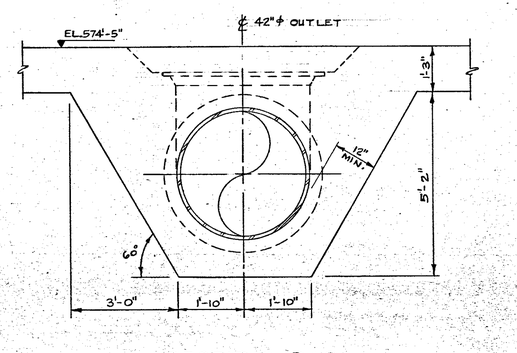


DETAIL 4
(2 REQ'D)

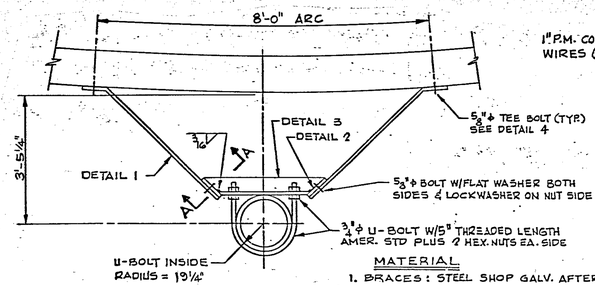


SECTION A-A

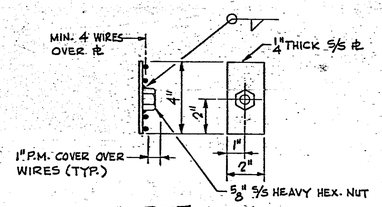


DETAIL 2
(2 REQ'D)

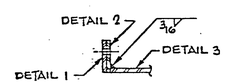


DETAIL 1
(2 REQ'D)
1- AS SHOWN
1- OPP. HAND

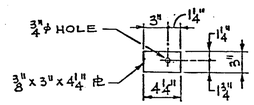


DETAIL 3
(1-REQ'D CUT AS SHOWN)

THE DETAILS SHOWN ON THIS DRAWING SHALL BE PRODUCED WITHIN THE GUIDELINES AND REQUIREMENTS SPECIFIED IN PRELOAD CO. "CONSTRUCTION SPECIFICATIONS & PROCEDURES" -NO. "CS-203".
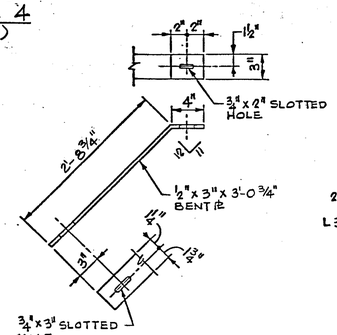
| REVISIONS | | | | |
|---|---|---|---|---|
| NO. | DATE | DESCRIPTION | BY | CKD |
| 1 | 5/13/86 | REV. INLET PIPE DET., SONIC LEVEL TRANS. DET., PLAN-CONC. EXT., DET'S 3, 5 & 6 | EE | RAO |

PRELOAD
839 STEWART AVENUE, GARDEN CITY, NEW YORK, 11530

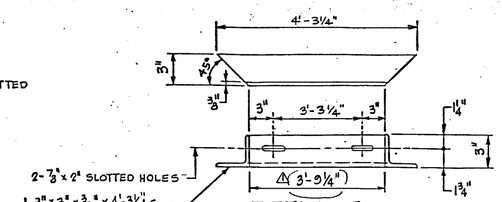THIS DRAWING IS THE PROPERTY OF THE PRELOAD COMPANY, INC.© AND/OR PRELOAD TECHNOLOGY, INC.© AND IS SUBJECT TO RETURN ON DEMAND. IT CONTAINS FEATURES OF DESIGN WHICH ARE FULLY COVERED BY PATENTS AND, PATENTS PENDING AND COPYRIGHTS. IT IS SUBMITTED FOR USE ONLY IN CONNECTION WITH PROPOSALS OR CONTRACTS OF PRELOAD OR ITS LICENSEES, UPON THE EXPRESS CONDITION THAT IT MAY NOT BE USED ON ANY OTHER DIFFERENT PROJECTS WITHOUT PRIOR APPROVAL OF PRELOAD.

ONE 6.0 M.G. WATER STORAGE TANK
ADDISON, TEXAS

INLET & OUTLET PIPE DETAILS

| | | | |
|---|---|---|---|
| DRAWN: JD | SCALE: NONE | CONTRACT NUMBER: | 86 PE 004 |
| DESIGNED: FD | APPROVED: | | |
| CHECKED: RAO | DATE: 4-24-86 | DRAWING NUMBER: | TEX. 83-007-6 |

DRAWINGS ISSUED
5/14/86 CAR
FOR CONSTRUCTION