


NOTE:
 COLUMNS A-3, A-5, A-7, C-1, C-9, E-1, E-9;
 G-1, G-9 & J-3, J-5 & J-7 ARE OFFSET FROM
 COLUMN LINES SHOWN ABOVE.

ROOF SLAB GRID SCHEDULE (LAYER NO.1)										
BUNDLE MK	REIN. PER BUNDLE NO.	SIZE	LENGTH	NO. OF BUNDLES	TOTAL NO. BARS	BAR WEIGHT			LOCATION	SKETCH
						#5	#4	#3		
MB1	533	#4	40'-0"	1	533	540	14429		CONTINUOUS GRID	
MB2	525	#4	30'-0"	1	525	535	10721		CONTINUOUS GRID	
MB3	2	#4	19'-11"	4	8	8	106		MID STRIPS E-D & E-F IN END BAYS	
MB4	3	#4	17'-9"	4	12	13	154		MID STRIPS C-B & F-G IN END BAYS	
MB5	3	#4	30'-0"/22'-9"	4	12	13	229		MID STRIPS C-B & G-H IN END BAYS	
MB6	3	#4	36'-0"/26'-6"	4	12	13	271		MID STRIPS B-A & H-J IN END BAYS	
CB1	9	#4	19'-11"	2	18	20	266		END BAYS COL. LINE E	
CB2	6	#4	16'-0"	24	144	150	1603		INTERIOR BAYS	
CB3	9	#4	19'-9"	4	36	38	502		END BAYS COLUMN LINE D & F	
CB4	7	#4	16'-0"	8	56	60	641		INTERIOR BAYS LINES 2-3 & 7-8	
CB5	6	#4	22'-8"/15'-6"	4	24	27	346		END BAYS LINES B & H	
CB6	4	#4	16'-0"	28	112	120	1283		INTERIOR BAYS	
CB7	8	#4	26'-3"/13'-6"	4	32	34	451		END BAYS LINES A & J	
CB8A	4	#4	22'-9"	10	40	42	638		MID STRIP E-D ONLY	
TOTAL WEIGHT							31640			

PART ROOF FRAMING PLAN
 SCALE: 3/32" = 1'-0"

- NOTES:**
- REINFORCING STEEL TO CONFORM TO ASTM A615, GRADE 60.
 - FOR HATCH, VENT & SONIC LEVEL TRANSMITTER DETAILS & APPL. REINF. SEE DWG TEX. 83-007-12
 - FOR INLET PIPE SEE DWG TEX. 83-007-6
 - FOR TYP. MIDDLE STRIP & COLUMN STRIP SECTIONS SEE DWG TEX. 83-007-12
 - REINFORCING BARS DETAILED ON THIS DWG ARE FOR LAYER NO.1 (SEE REBAR LAYOUT, THIS DWG)
 - FOR OTHER LAYERS SEE DWGS TEX. 83-007-9, -10 & -11
 - REINF. MARKED WITH SUFFIX 'A' TO BE PLACED NEAR THE COLUMN.
 - BARS MARKED THIS * TO BE CUT IN EQUAL INCREMENTS AND BAR WEIGHTS LISTED ARE FOR AVERAGE LENGTHS
 - SEE DWG TEX. 83-007-3 & -5 FOR MK ANC-3 AT OVERFLOW PIPES

- FORMWORK NOTES:**
- FORMWORK DESIGN AND RESHORING SHALL BE IN ACCORDANCE WITH ACI 347, LATEST EDITION.
 - FORMS TO REMAIN UNTIL SLAB REACHES DESIGN STRENGTH BUT NOT LESS THAN 7 DAYS UNLESS RESHORING IS USED.
 - SLAB BETWEEN CONSTRUCTION JOINT AND COLUMNS IS NOT DESIGNED FOR CANTILEVER ACTION. FORMWORK IN THIS AREA MUST REMAIN UNTIL ADJACENT SLAB IS CAST AND HAS ACHIEVED FULL STRENGTH.

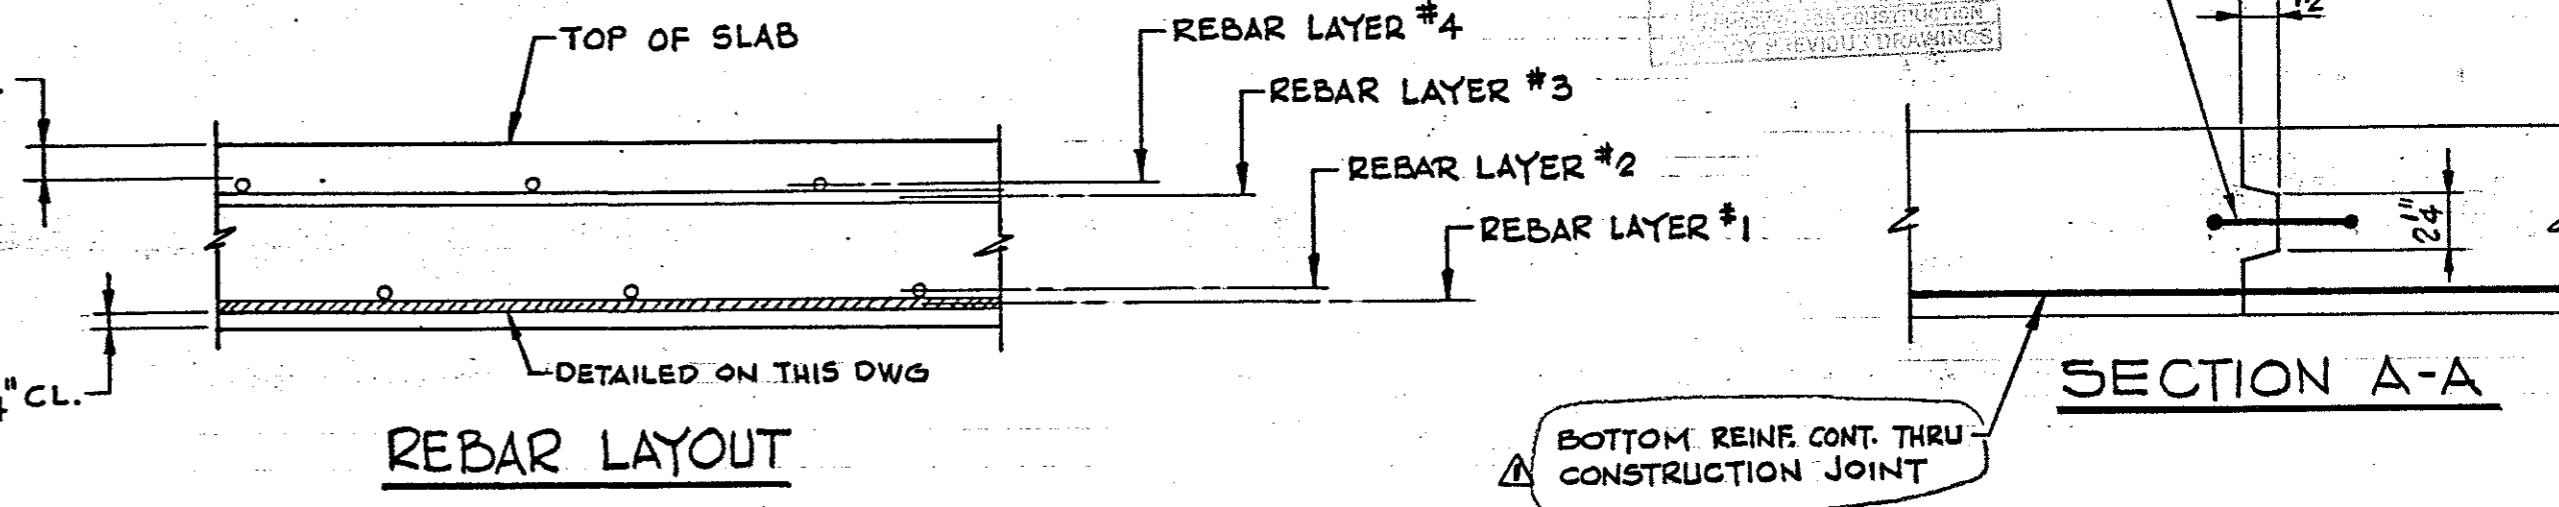

REVISIONS			
NO.	DATE	DESCRIPTION	BY
1	5/13/86	REVISED SECTION A-A	E RAO

PRELOAD
 839 STEWART AVENUE, GARDEN CITY, NEW YORK, 11530

THIS DRAWING IS THE PROPERTY OF THE PRELOAD COMPANY, INC. AND/OR PRELOAD TECHNOLOGY, INC. AND IS SUBJECT TO RETURN ON DEMAND. IT CONTAINS FEATURES OF DESIGN WHICH ARE FULLY COVERED BY PATENTS AND PATENTS PENDING AND COPYRIGHTS. IT IS SUBMITTED FOR USE ONLY IN CONNECTION WITH PROPOSALS OR CONTRACTS OF PRELOAD OR ITS LICENSEES, UPON THE EXPRESS CONDITION THAT IT MAY NOT BE USED ON ANY OTHER DIFFERENT PROJECTS WITHOUT PRIOR APPROVAL OF PRELOAD.

WORKING DRAWING

ONE 6.0 M.G. GROUND STORAGE RESERVOIR
 ADDISON, TEXAS
 ROOF SLAB REINFORCING
 LAYER NO.1

DRAWN: E
 DESIGNED: RAO
 CHECKED: FD

SCALE:
 APPROVED:
 DATE: 4-24-86

CONTRACT NUMBER: 86 PE 004
 DRAWING NUMBER: 83-007-B