
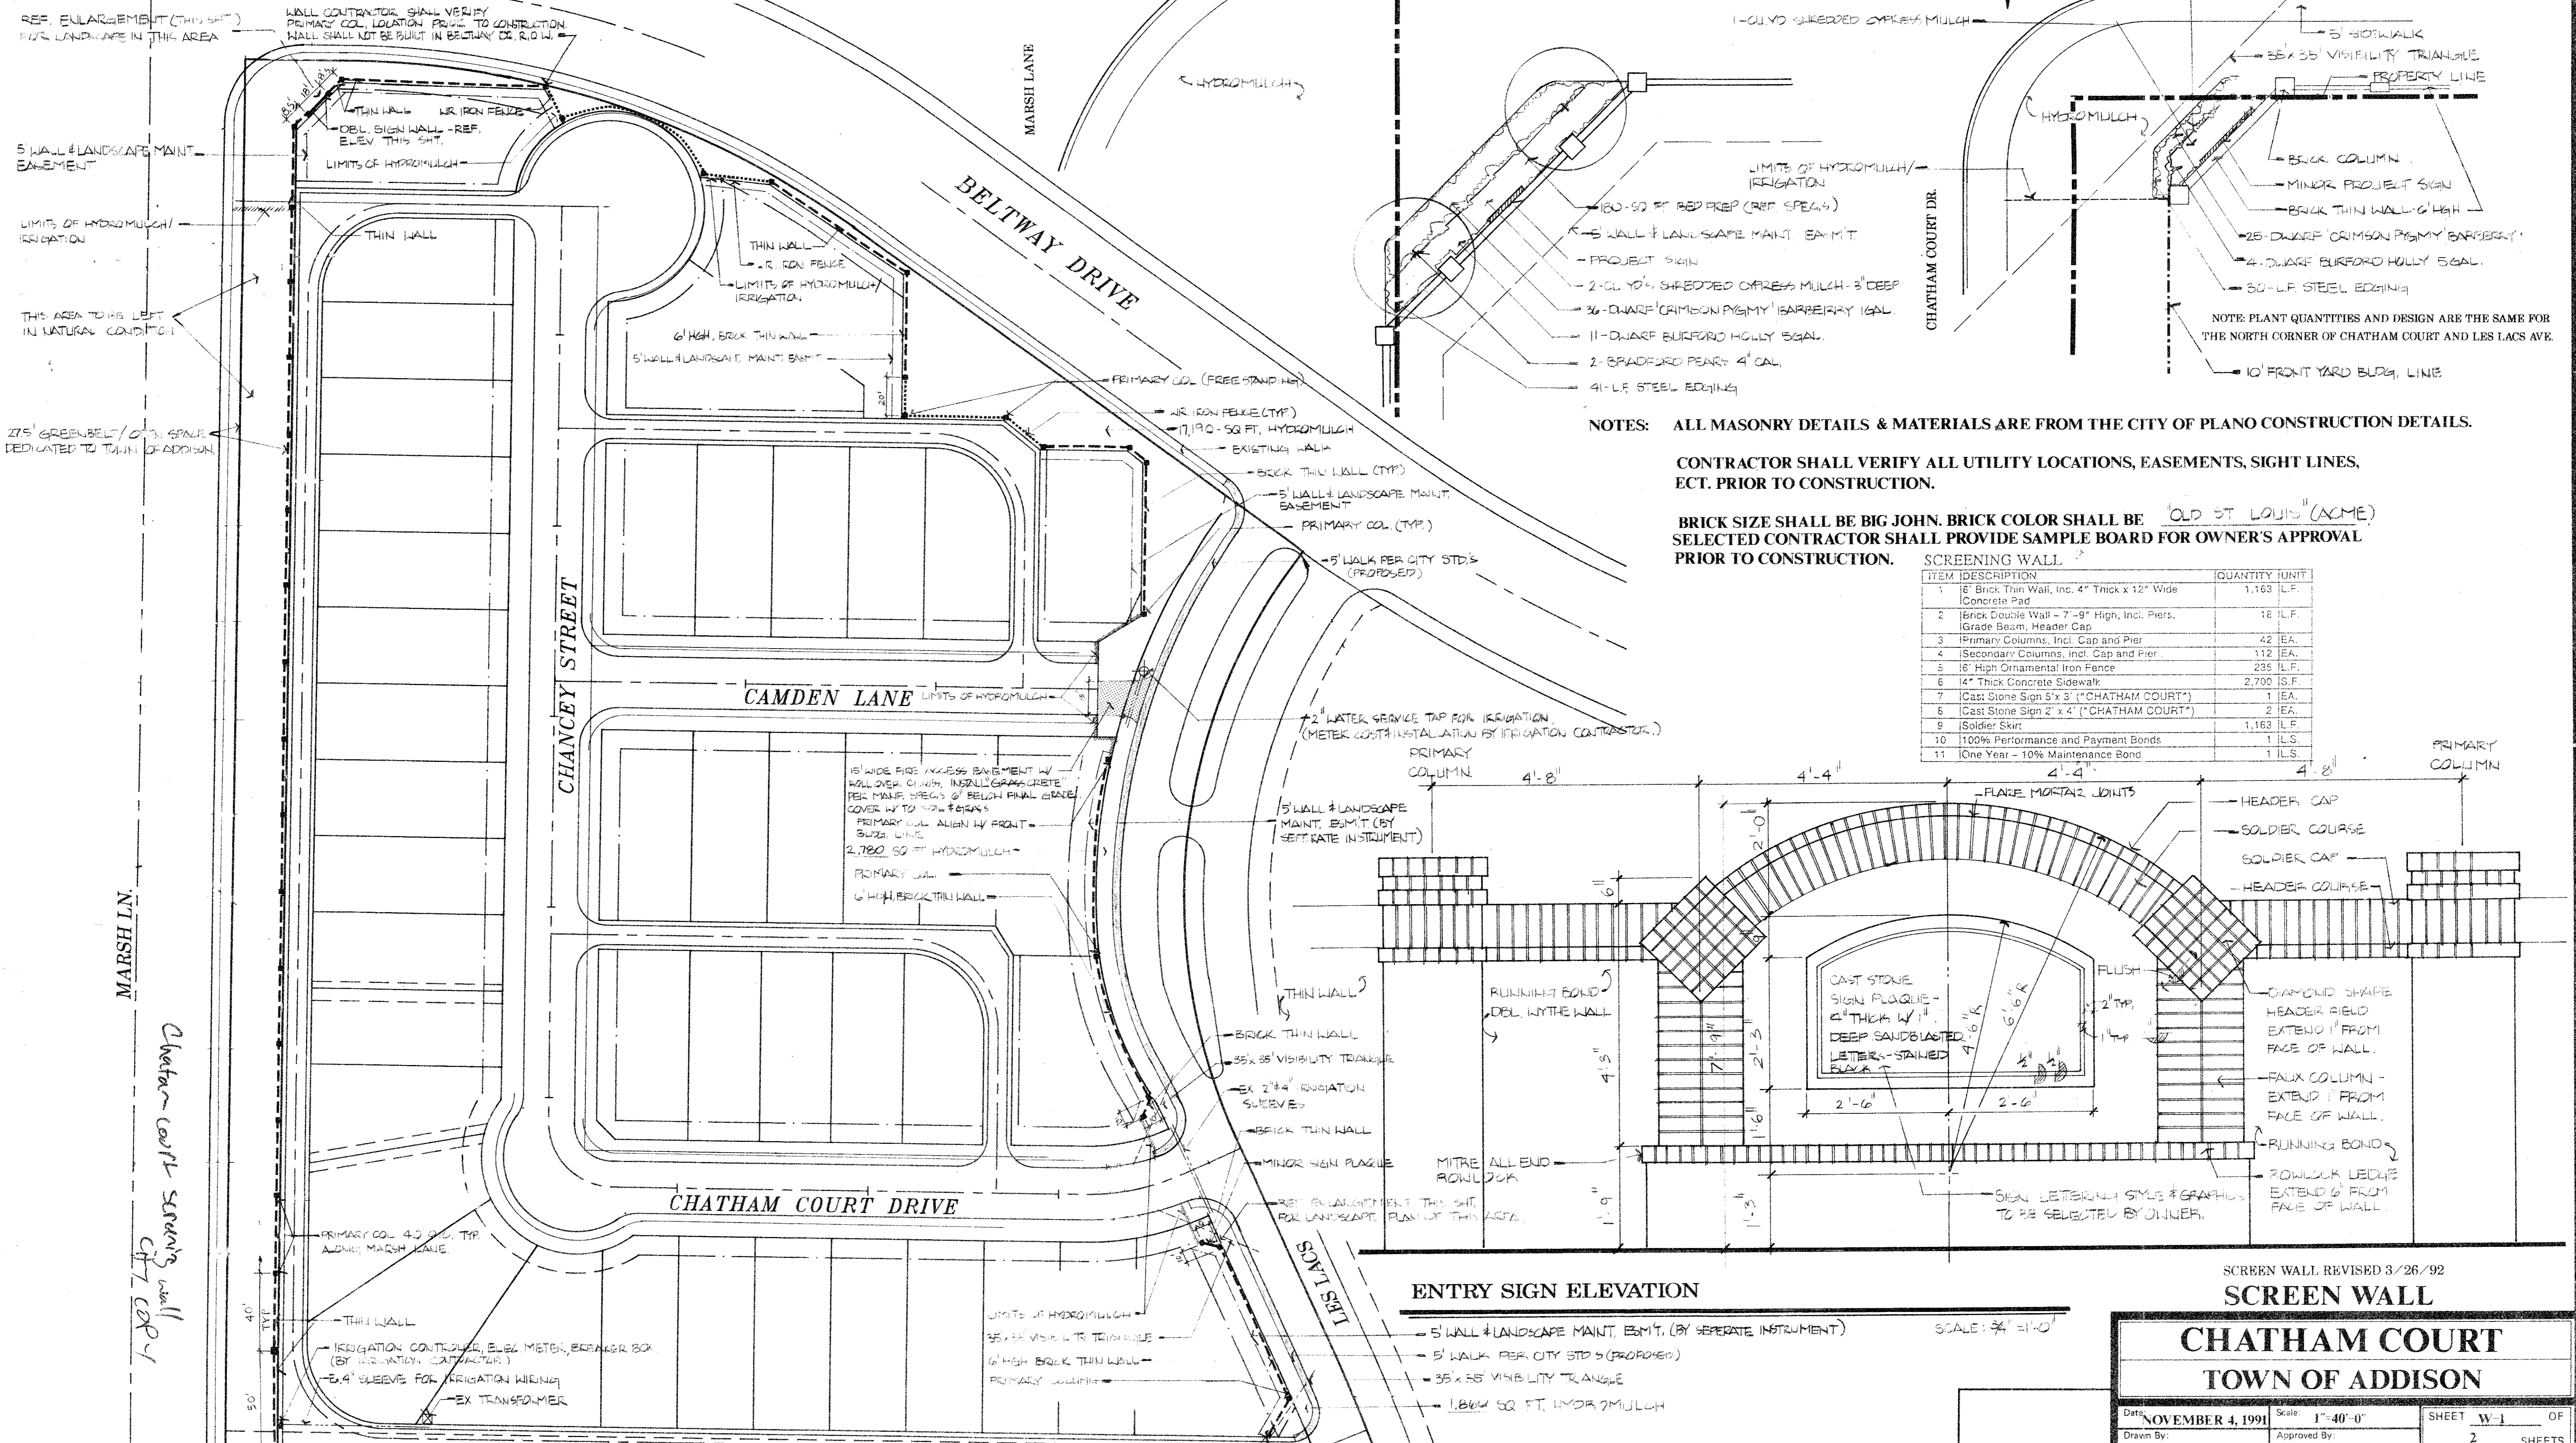


- NOTES:
1. LAWNS AND LANDSCAPE SPECIFICATIONS (SEC. 02930 & 02950) ARE INTEGRAL WITH THESE LANDSCAPE PLANS.
 2. WINNING IRRIGATION CONTRACTOR SHALL PROVIDE PLANS AND SPECIFICATIONS TO ARCHITECT AND TOWN OF ADDISON FOR APPROVAL. IRRIGATION PLAN SHALL MEET ALL TOWN OF ADDISON REQUIREMENTS.
 3. IRRIGATION BID SHALL INCLUDE COST FOR FURNISHING POWER TO CONTROLLER, ANY RELATED PERMITS AND FEES, AND METER PRICE AND INSTALLATION.

PLANT LIST
CHATHAM COURT

QUANTITY	COMMON NAME	BOTANICAL NAME	SIZE	MINIMUM HIGHT/SPD
2	BRADFORD PEAR	PYRUS CALLERYANA 'BRADFORD'	4" CA	12/6'
100	PHOTINIA	PHOTINIA FRASERI	5 GAL	30"/24"
100	BURFORD HOLLY	ILEX CORNUTA 'BURFORDII'	5 GAL	30"/24"
19	DWARF BURFORD HOLLY	ILEX CORNUTA 'BURFORDII' NANA	5 GAL	30"/18"
86	DWARF CRIMSON PYGMY BARBERRY	BERBERIS THUNBERGII 'CRIMSON PYGMY'	1 GAL	9"/9"
101	L.F. STEEL EDGING			1/8"x4"
401	SQ. FT. BED PREP	REF. SPEC.S		
21	CU. FT. SHREDDED CYPRESS MULCH			
21,830	SQ. FT. BERMUDA HYDROMULCH	REF. SPEC.S		

Revisions	Date	Description	Drawn By	Checked By
	2/5/92	PLANTING & WALL	J	

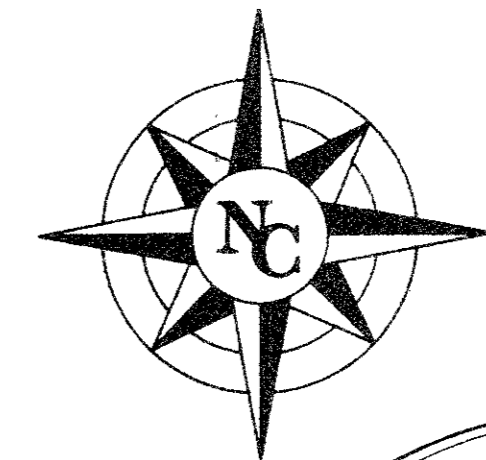


NOTES: ALL MASONRY DETAILS & MATERIALS ARE FROM THE CITY OF PLANO CONSTRUCTION DETAILS.
 CONTRACTOR SHALL VERIFY ALL UTILITY LOCATIONS, EASEMENTS, SIGHT LINES, ECT. PRIOR TO CONSTRUCTION.
 BRICK SIZE SHALL BE BIG JOHN. BRICK COLOR SHALL BE OLD ST LOUIS (ACME)
 SELECTED CONTRACTOR SHALL PROVIDE SAMPLE BOARD FOR OWNER'S APPROVAL PRIOR TO CONSTRUCTION.

SCREENING WALL

ITEM	DESCRIPTION	QUANTITY	UNIT
1	16" Brick Thin Wall, Inc. 4" Thick x 12" Wide Concrete Pad	1,163	L.F.
2	Brick Double Wall - 7'-9" High, Incl. Piers, Grade Beam, Header Cap	16	L.F.
3	Primary Columns, Incl. Cap and Pier	42	EA.
4	Secondary Columns, Incl. Cap and Pier	112	EA.
5	16" High Ornamental Iron Fence	235	L.F.
6	4" Thick Concrete Sidewalk	2,700	S.F.
7	Cast Stone Sign 5' x 3' ("CHATHAM COURT")	1	EA.
8	Cast Stone Sign 2' x 4' ("CHATHAM COURT")	2	EA.
9	Soldier Skirt	1,163	L.F.
10	100% Performance and Payment Bonds	1	ILS.
11	One Year - 10% Maintenance Bond	1	ILS.

ENTRY SIGN ELEVATION

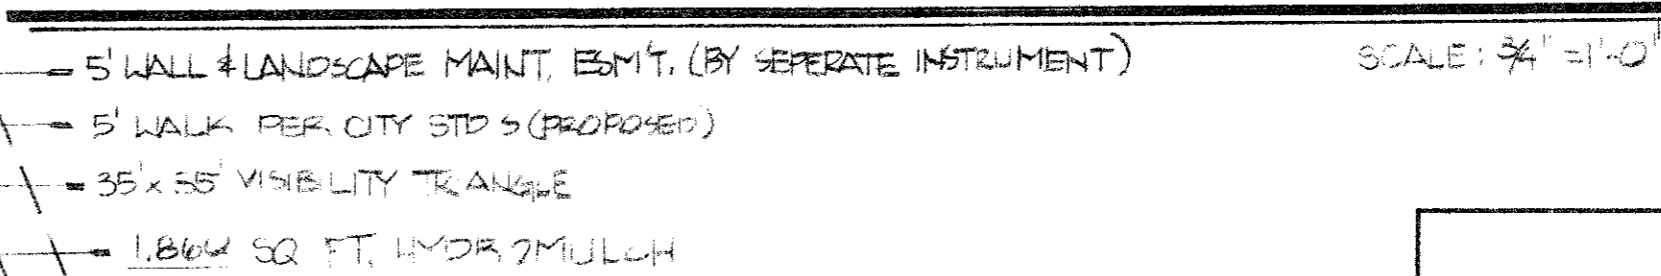

SCREEN WALL REVISED 3/26/92
SCREEN WALL


CHATHAM COURT
TOWN OF ADDISON

Date: **NOVEMBER 4, 1991** Scale: **1"=40'-0"** SHEET **W-1** OF **2** SHEETS

Drawn By: [Signature] Approved By: [Signature]


THE NELSON CORPORATION
LAND PLANNING • ENGINEERING • SURVEYING
5999 SUMMERSIDE DRIVE • SUITE 202 • DALLAS, TEXAS 75252 • (214) 380-3805

Revisions	Date	Description	Drawn By	Checked By

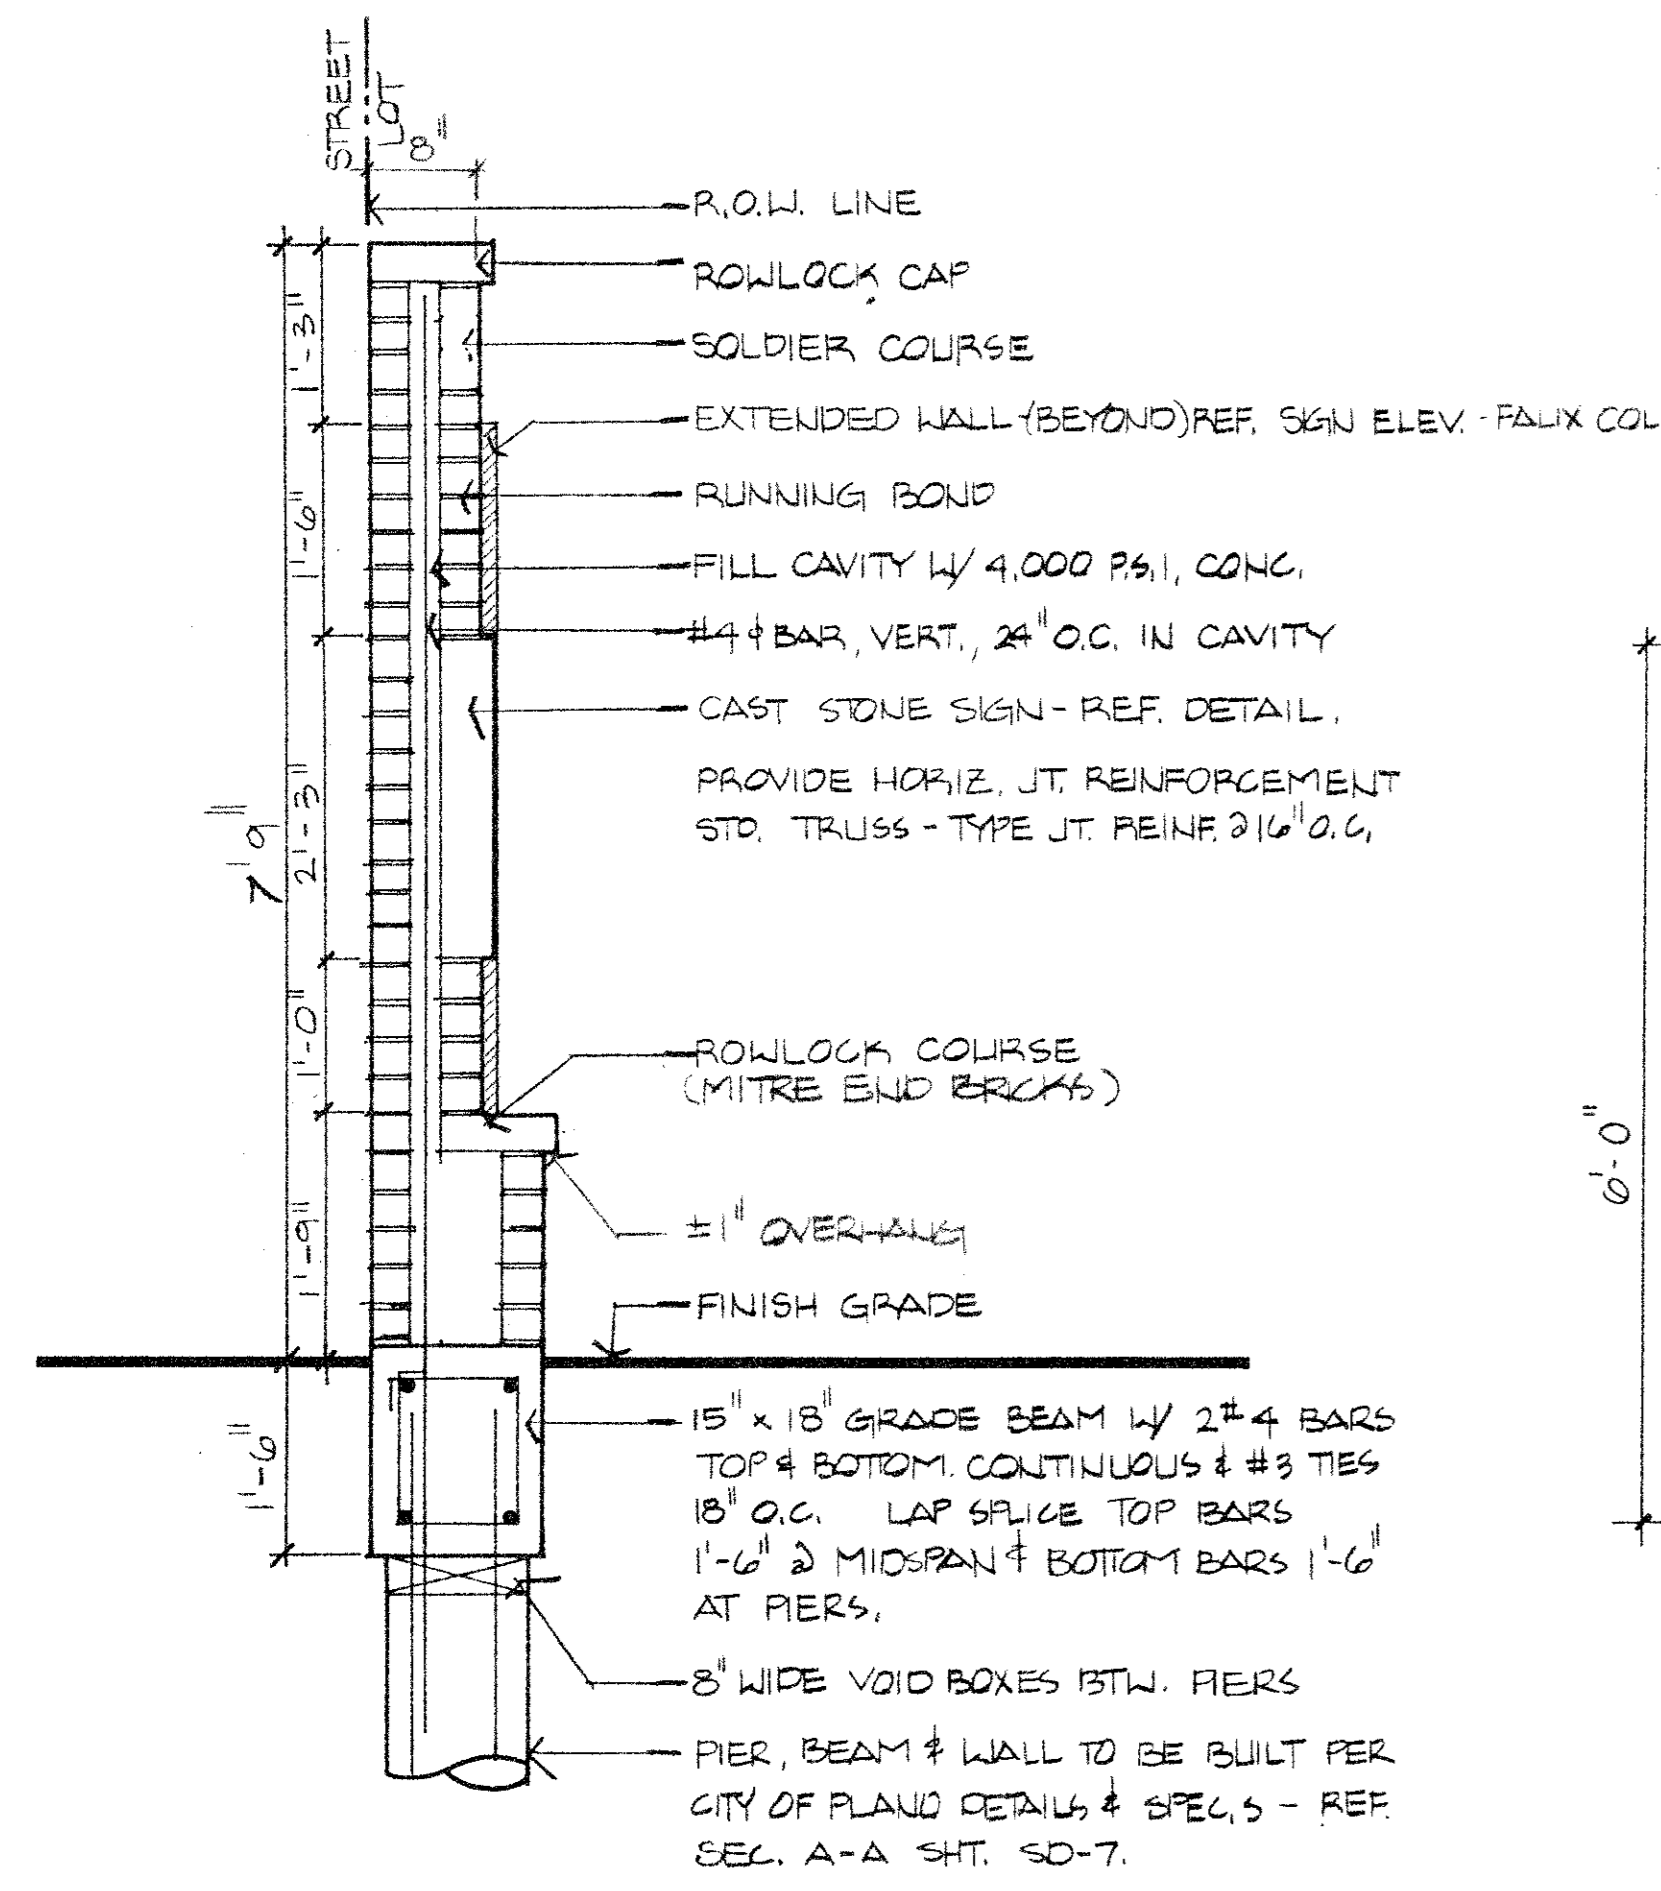


A SECTION - BRICK WALL AT SIGN

SCALE: 3/4" = 1'-0"

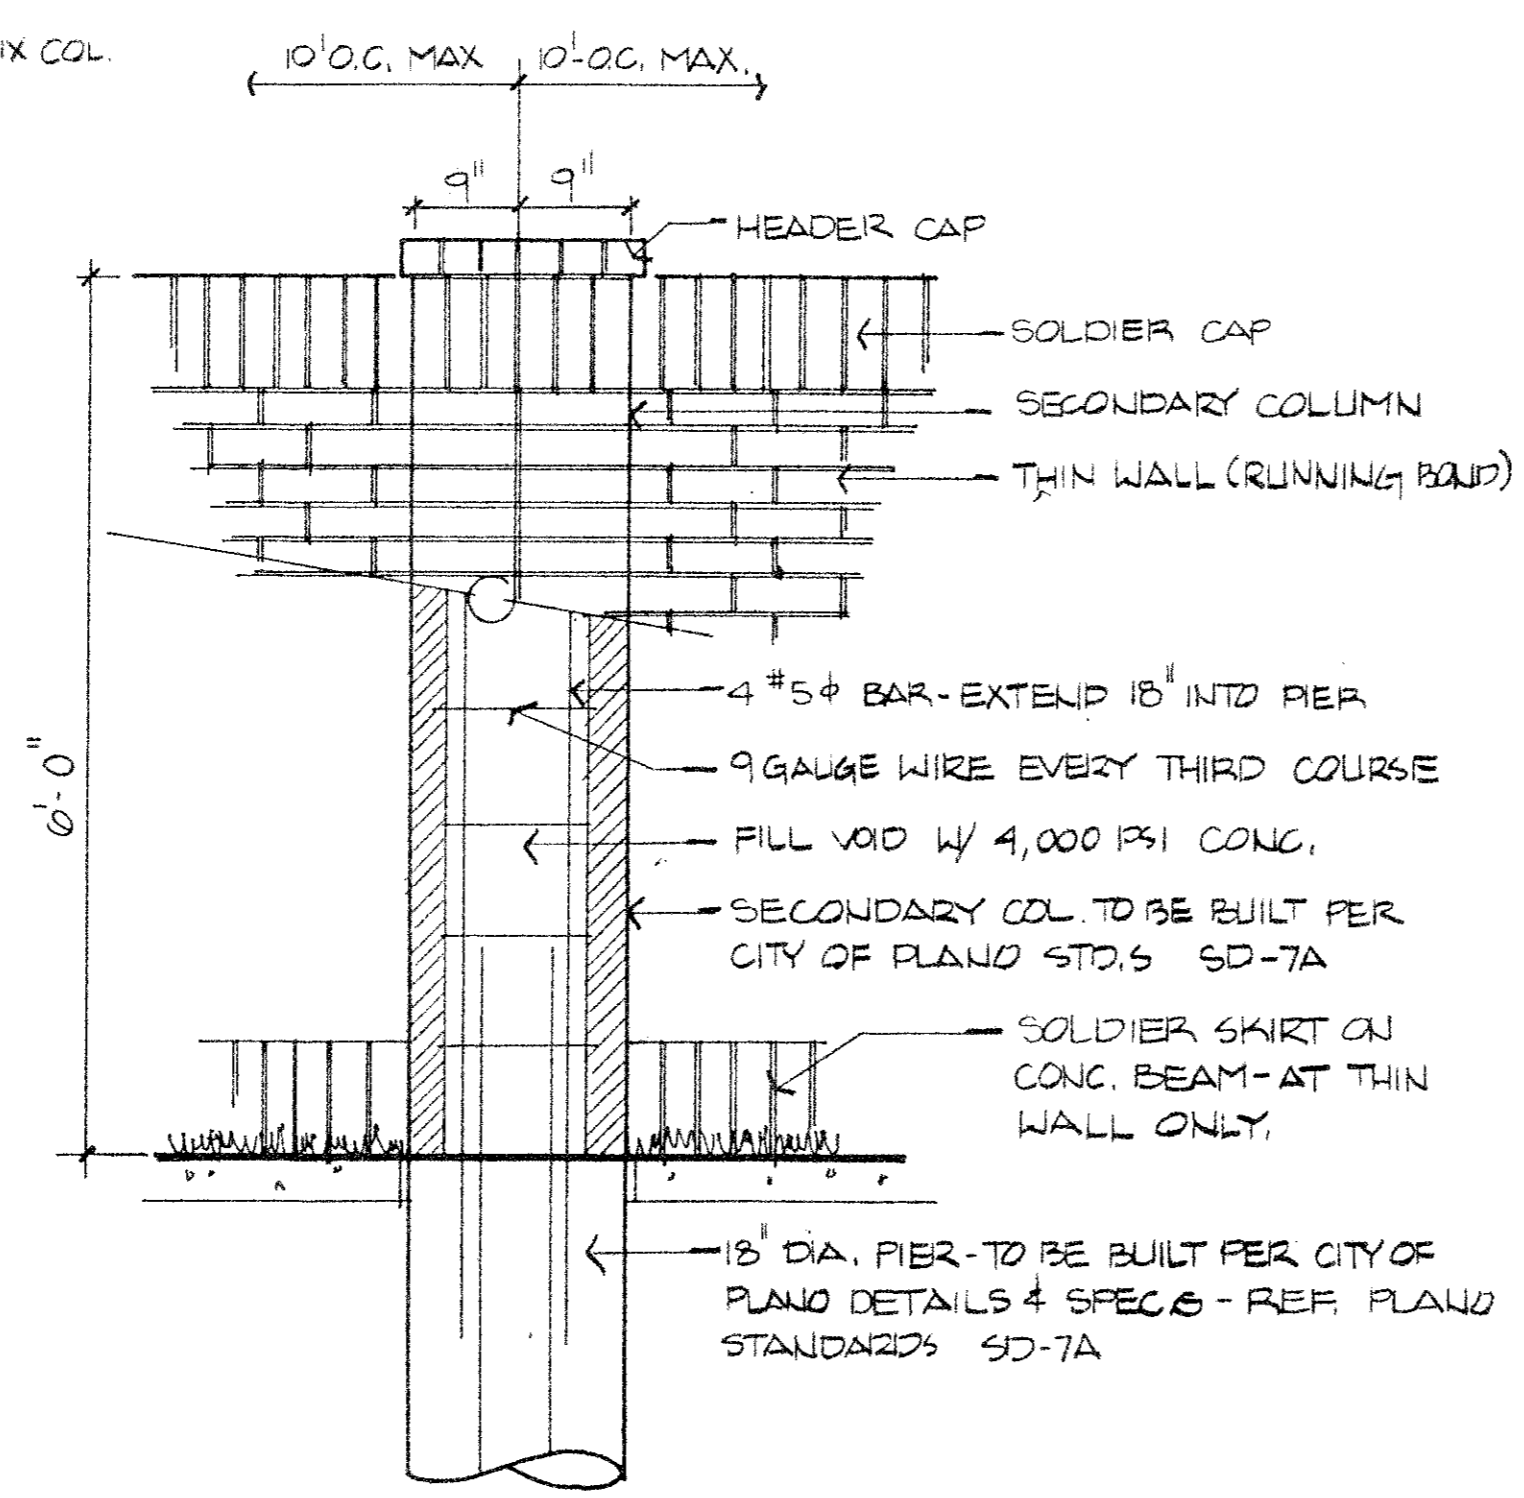


B SECONDARY COLUMN

SCALE: 3/4" = 1'-0"

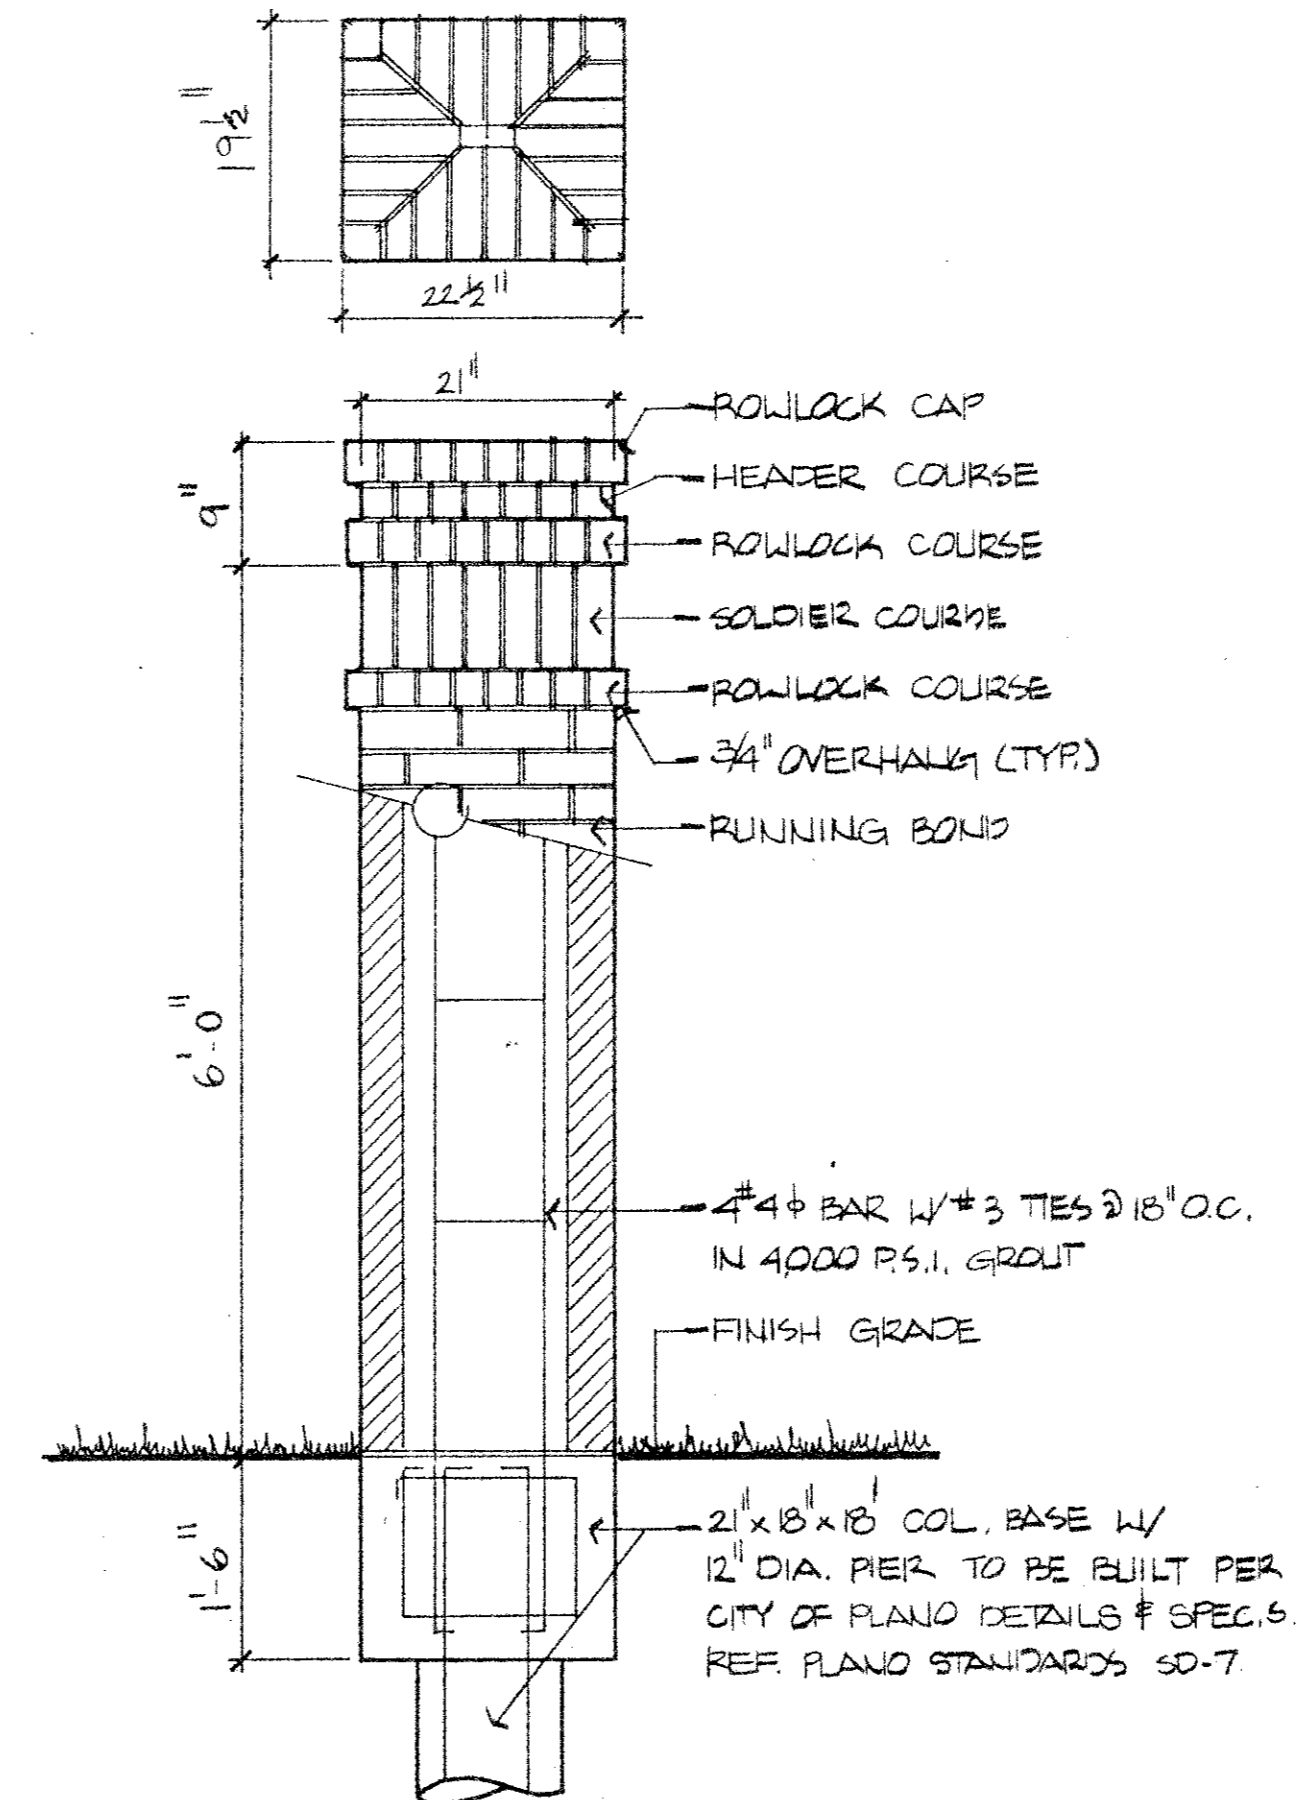



C PRIMARY COLUMN

SCALE: 3/4" = 1'-0"

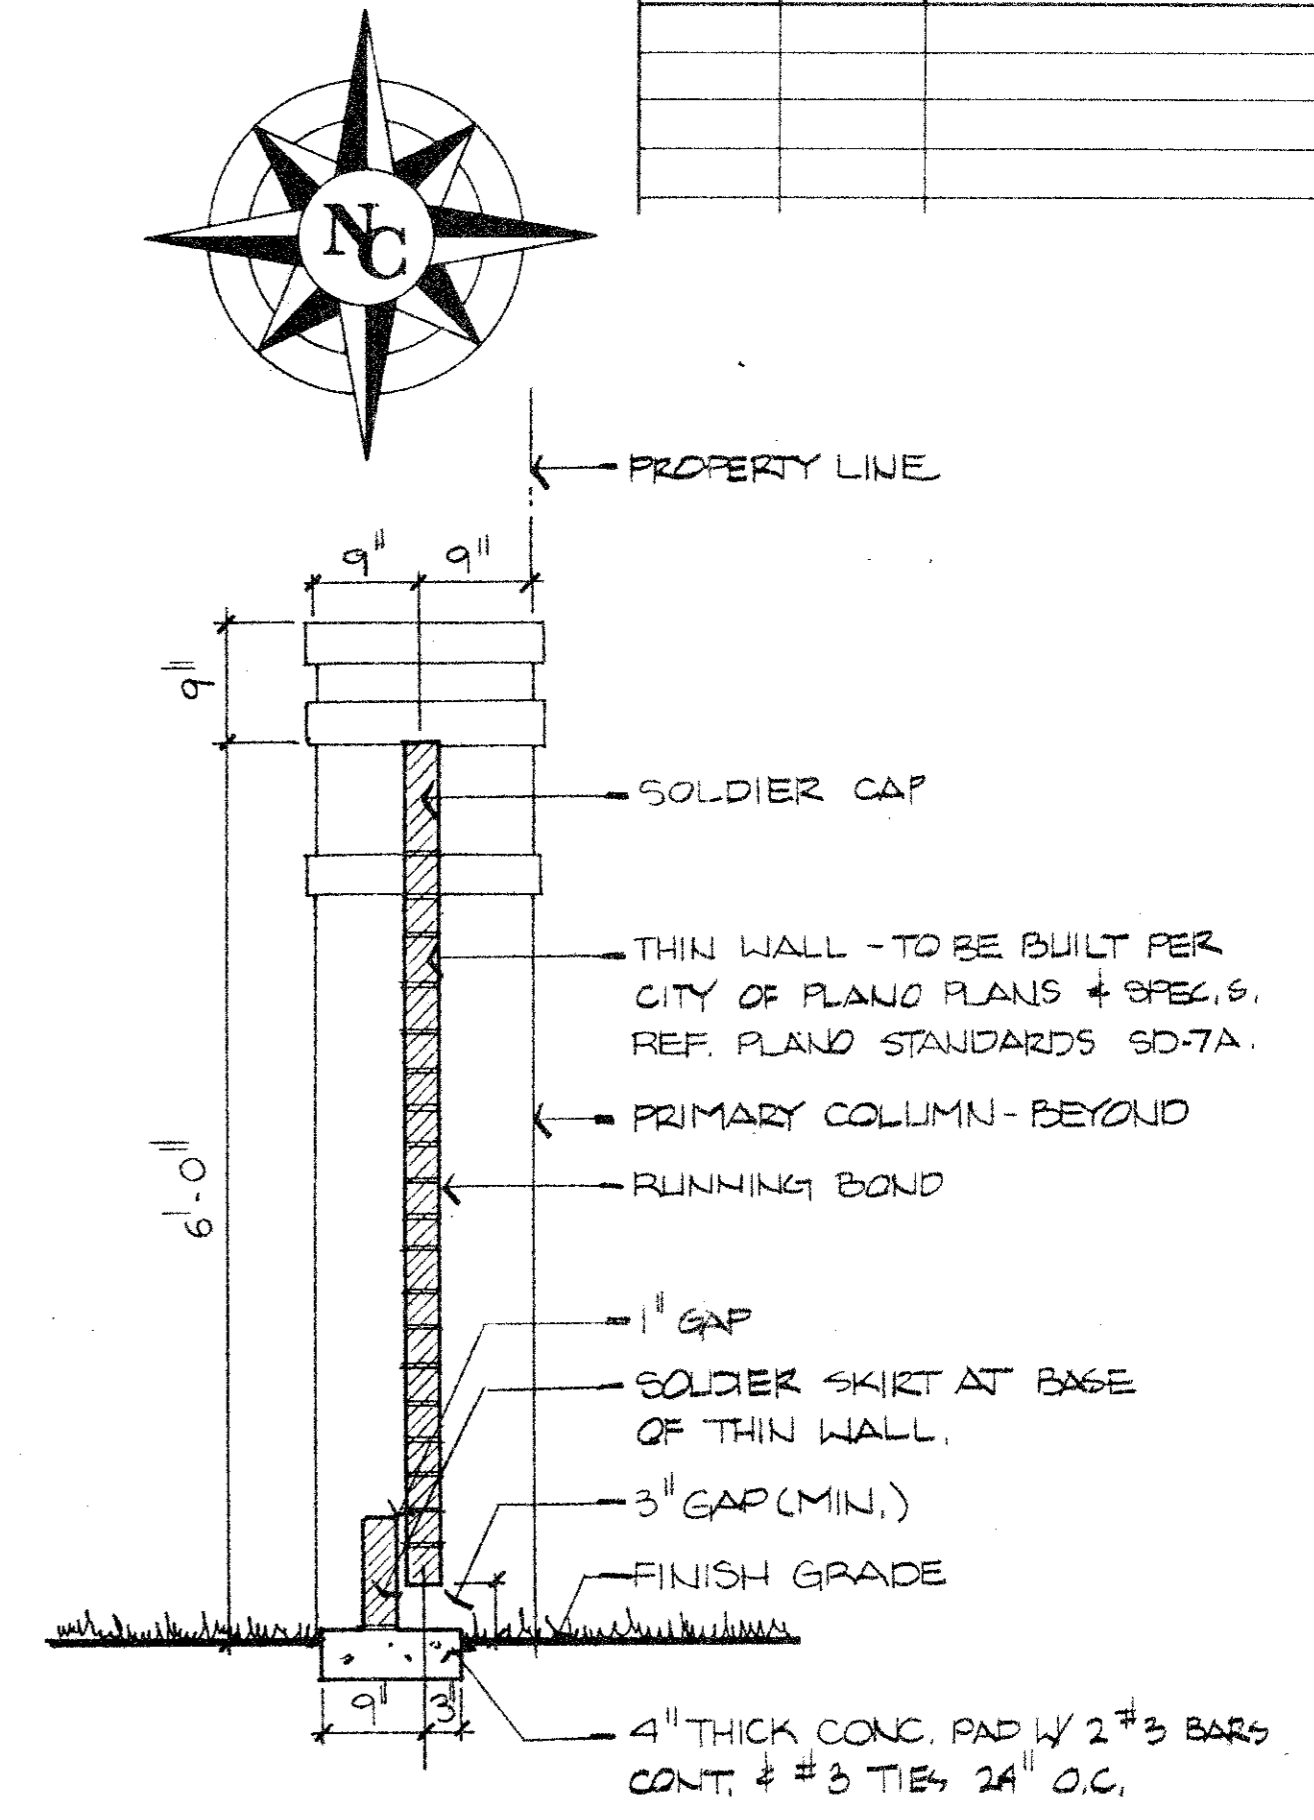


D SECTION - BRICK THIN WALL

SCALE: 3/4" = 1'-0"

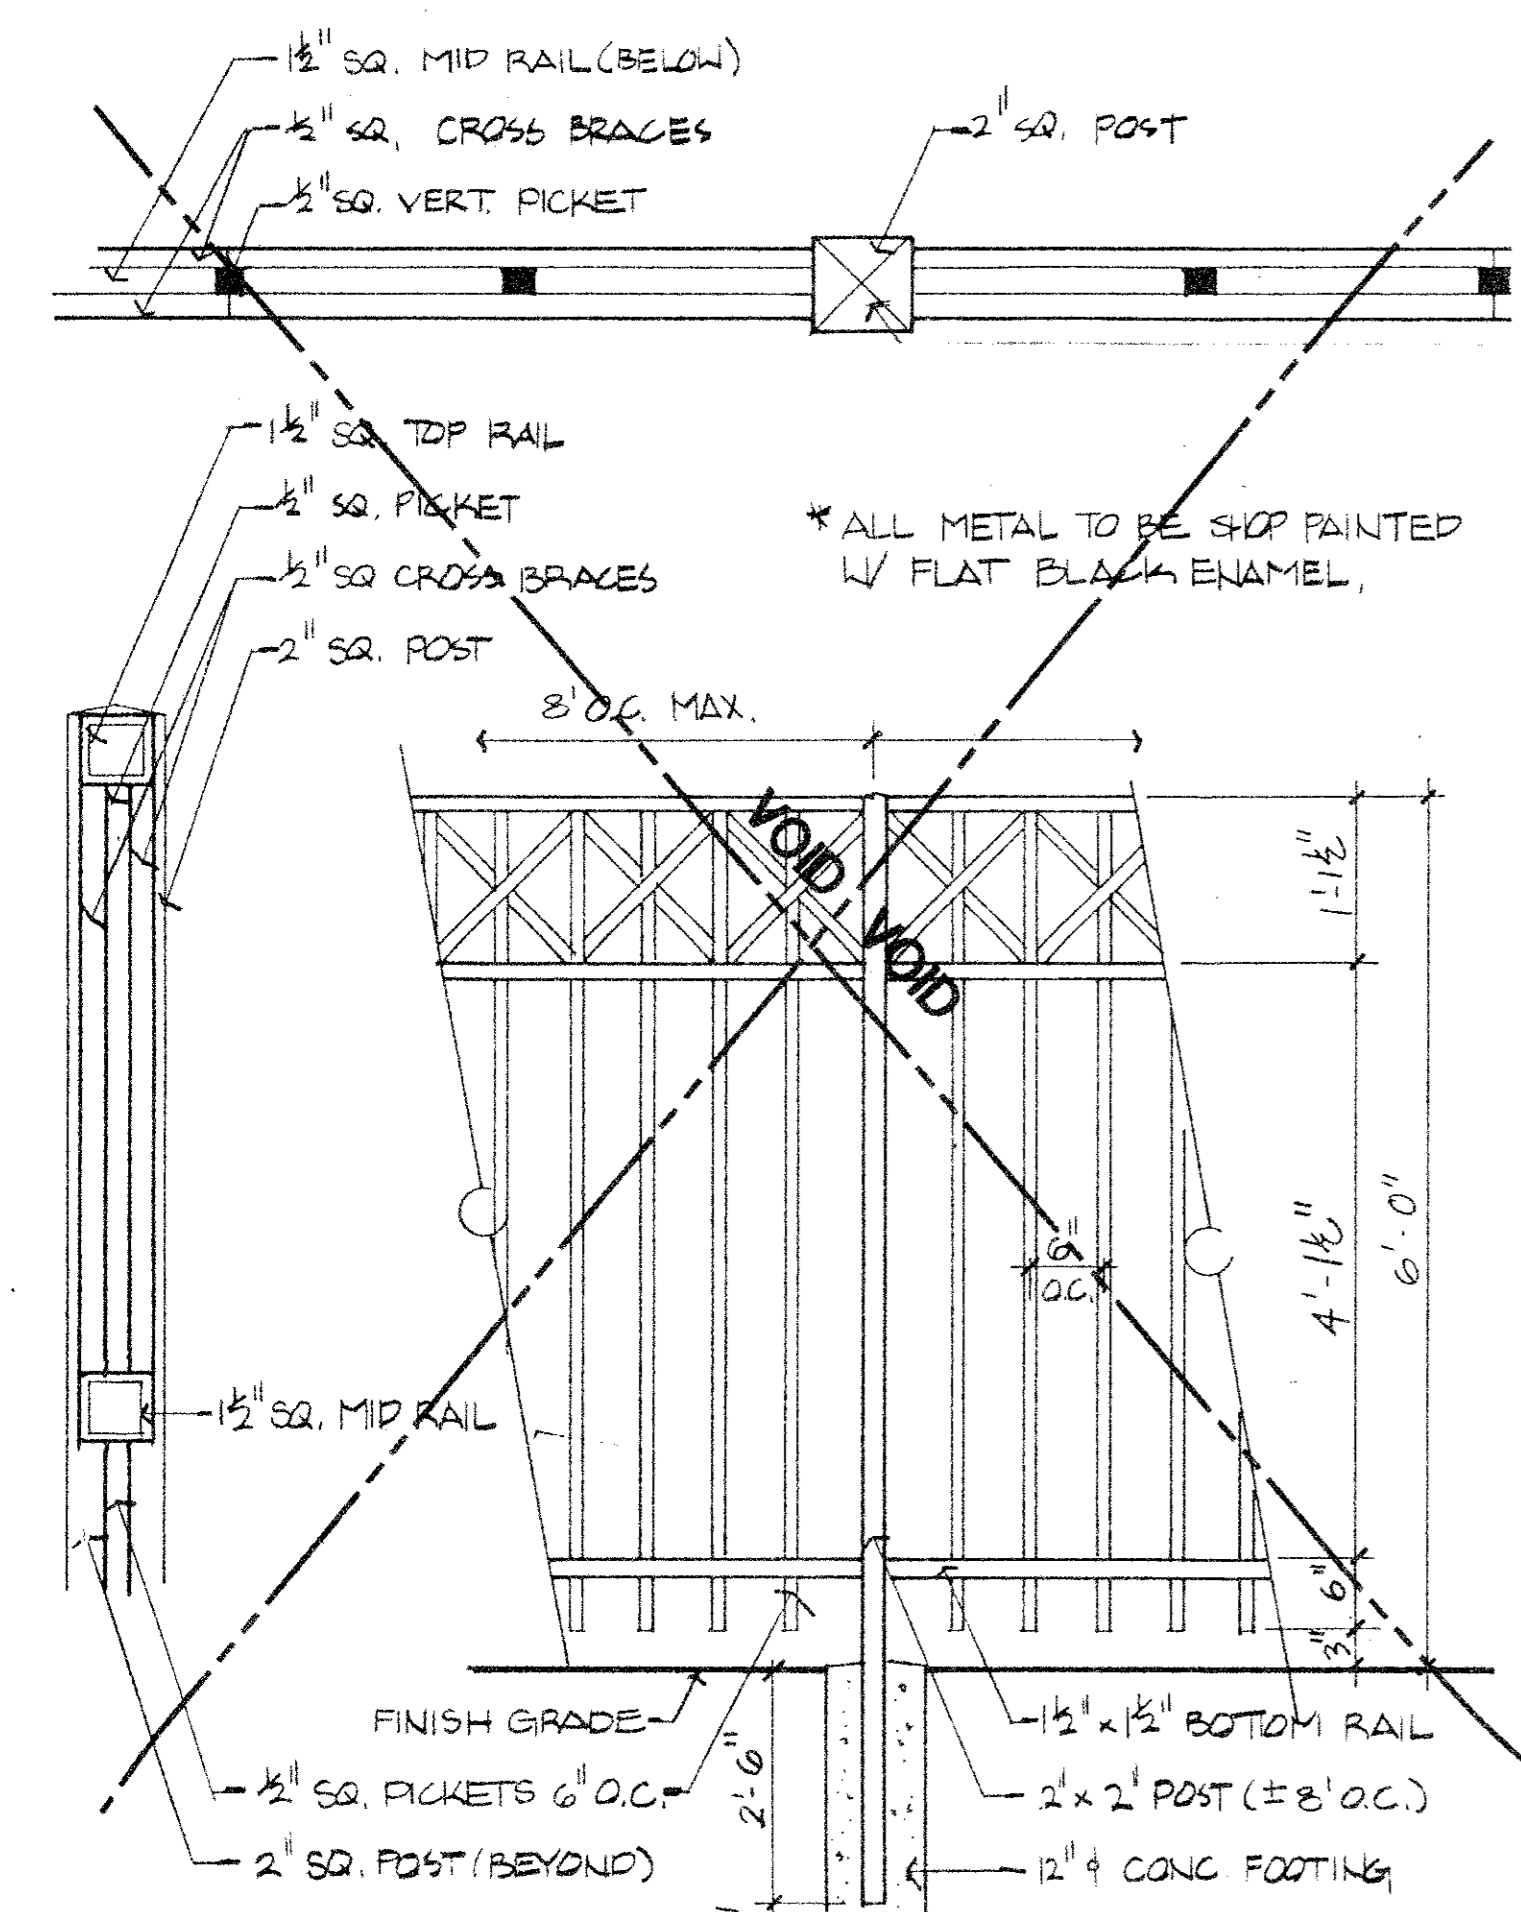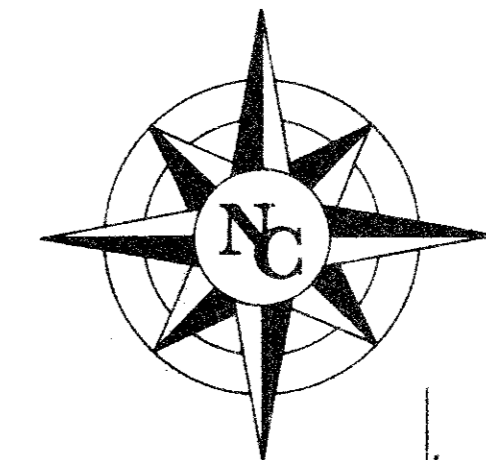


E ORNAMENTAL IRON FENCE

SCALE: 3/4" = 1'-0"

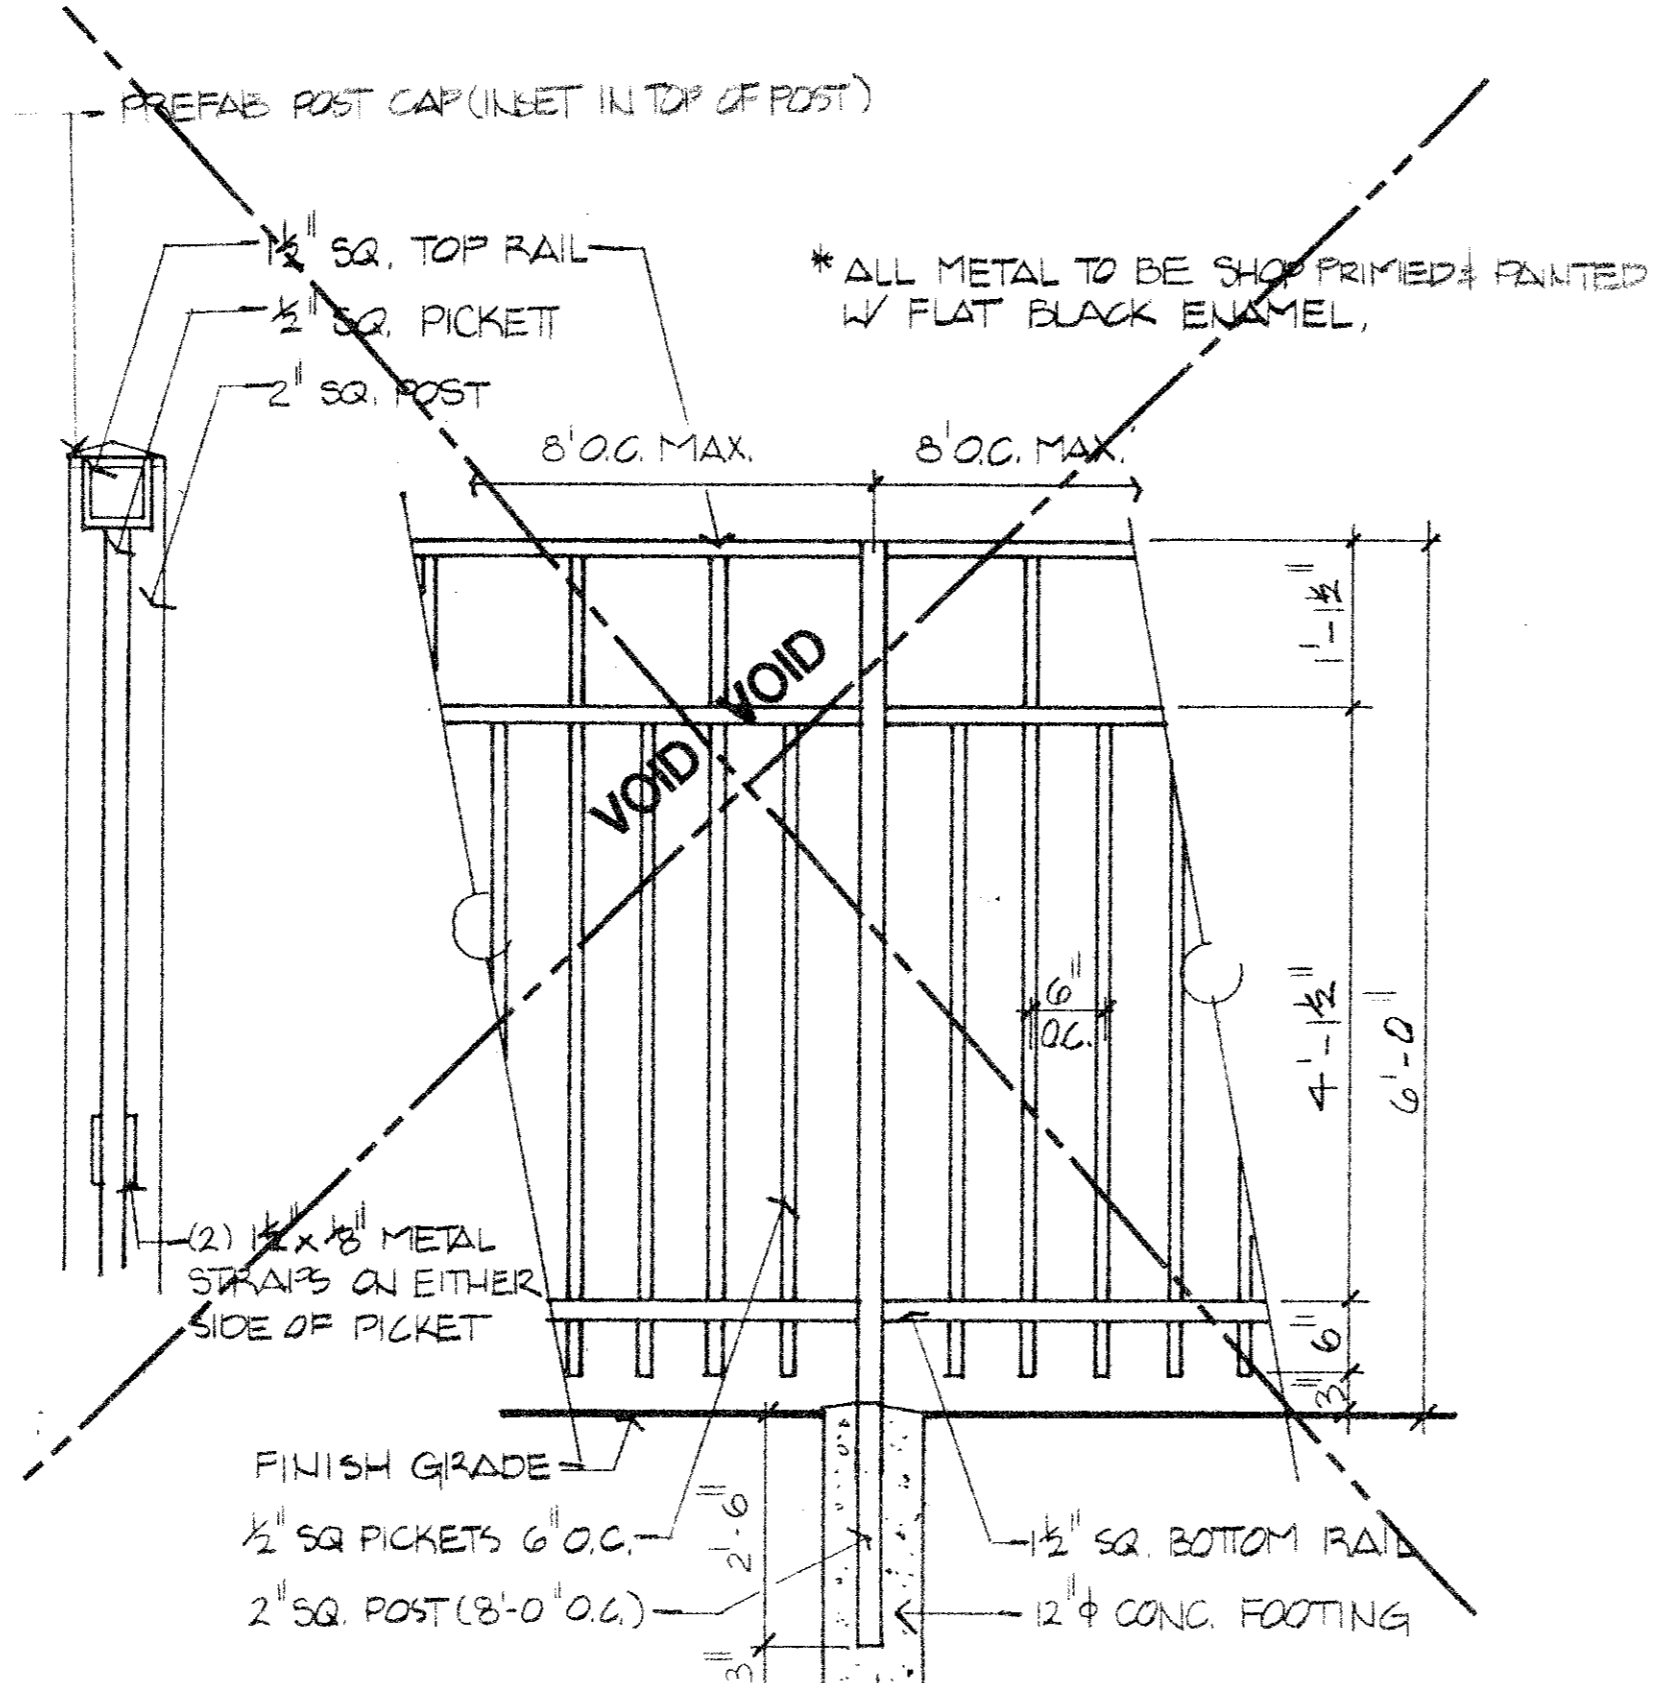

F ORNAMENTAL IRON FENCE

BID AS ALTERNATE "A" SCALE: 3/4" = 1'-0"

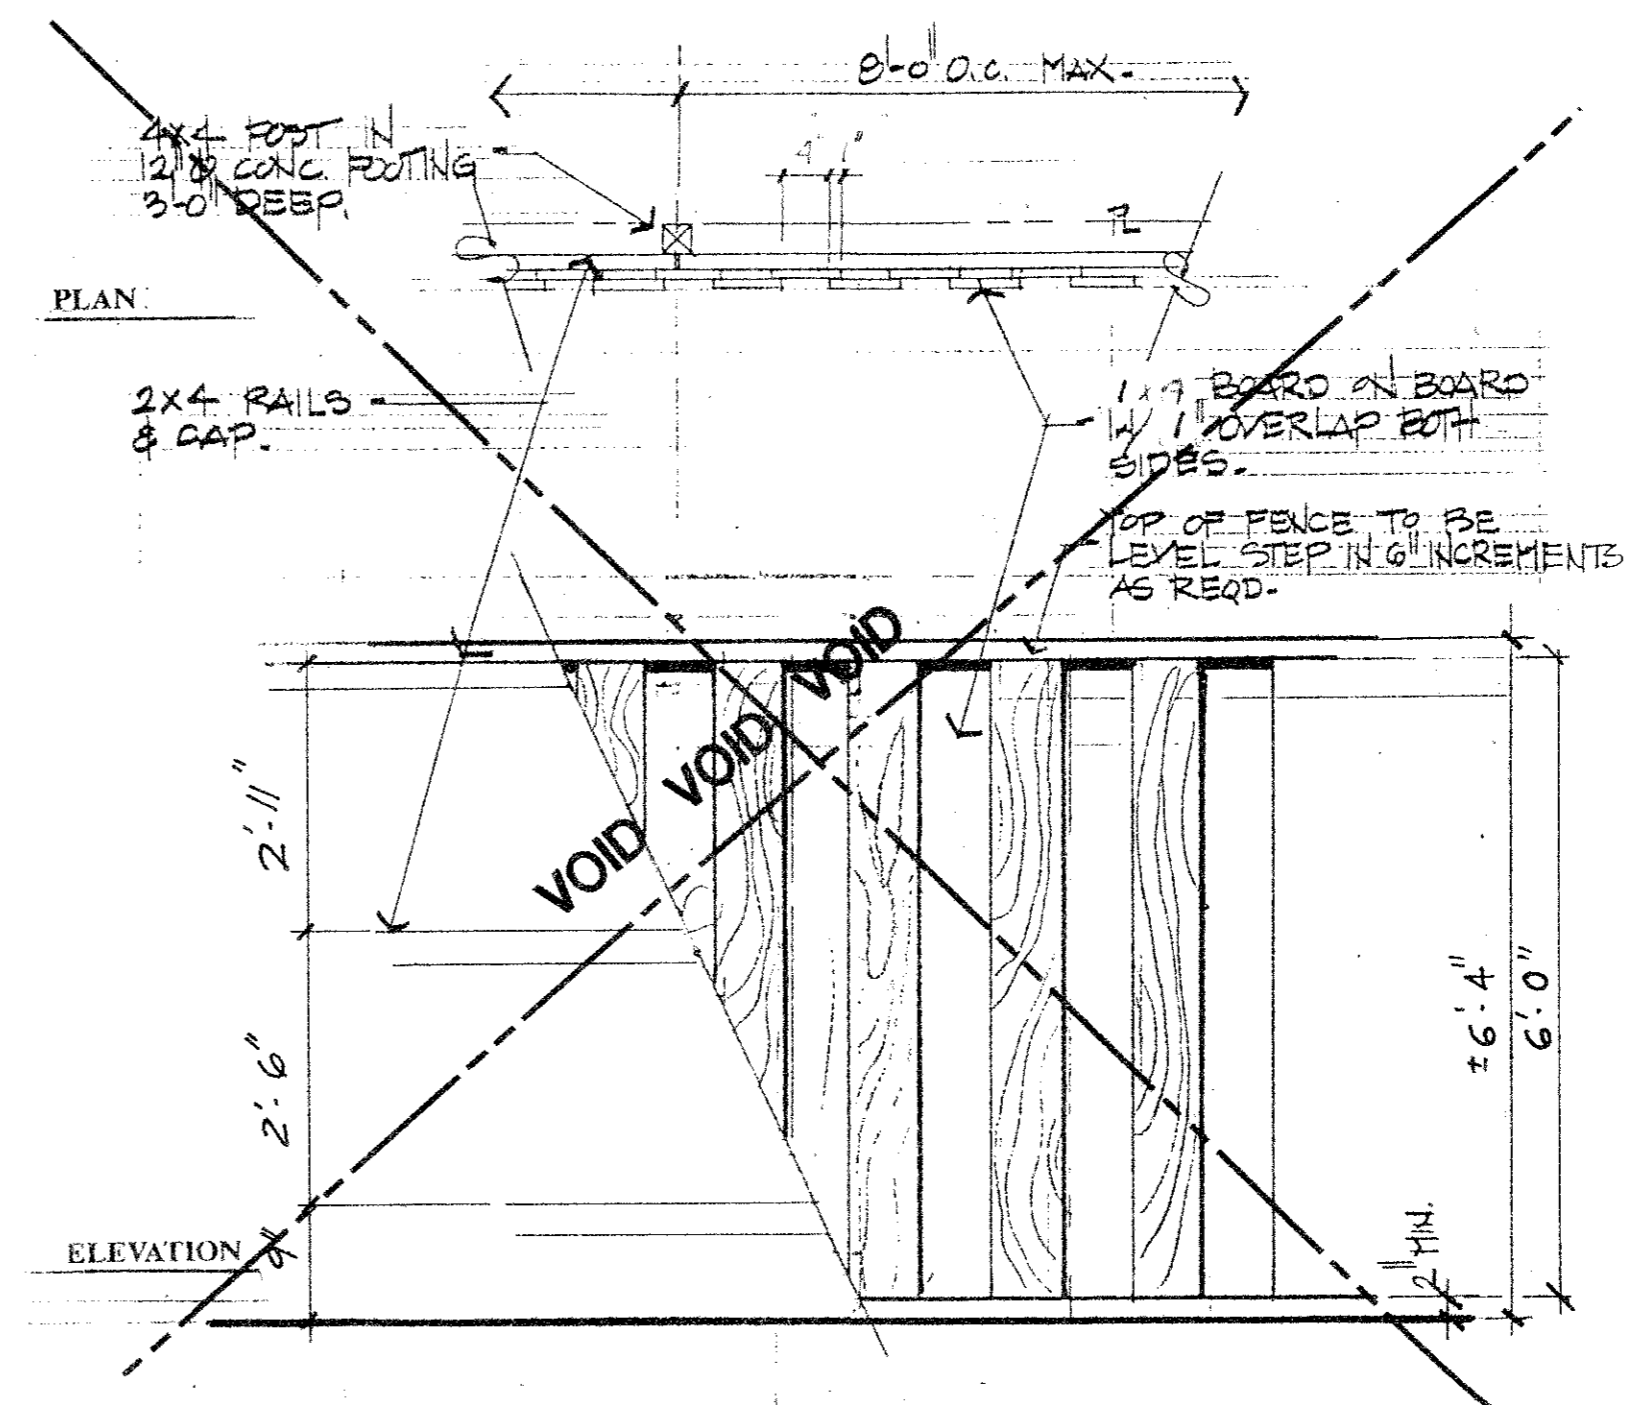

G WOOD SCREEN FENCE

N.T.S.

SCREEN WALL
CHATHAM COURT
TOWN OF ADDISON

Date: NOVEMBER 4, 1991	Scale: 1"=40'-0"	SHEET: W-2
Drawn By:	Approved By:	2 SHE

THE NELSON CORPORATION
LAND PLANNING • ENGINEERING • SURVEYING
5989 SUMMERSIDE DRIVE • SUITE 202 • DALLAS, TEXAS 75252 • (214) 380-2605