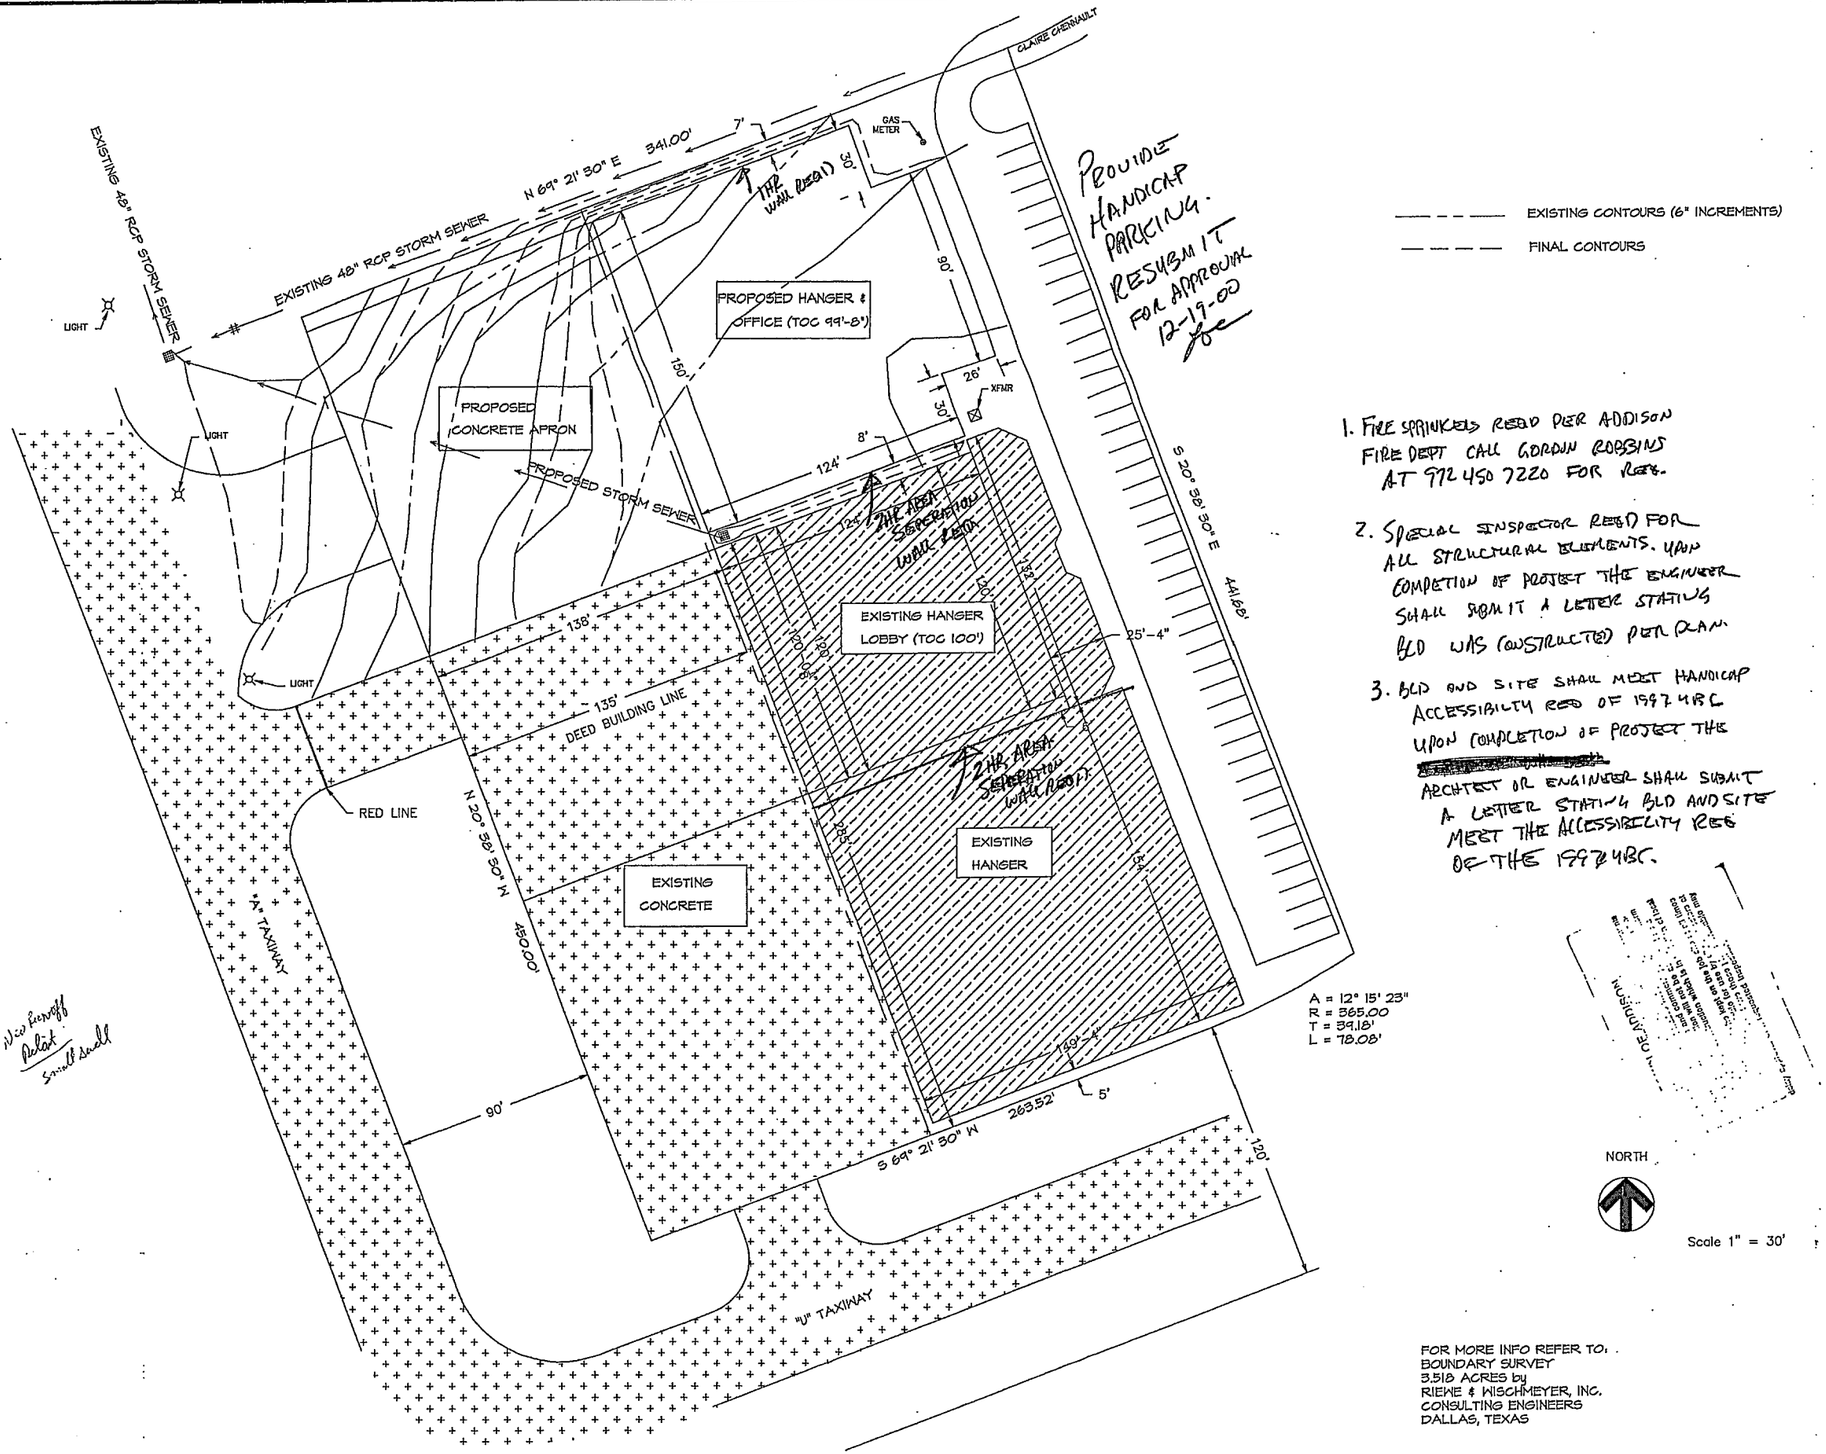

Provide Handicap parking. Resubmit for approval 12-19-00

1. Fire sprinklers reqd per Addison Fire Dept call Gordon Robbins at 972 450 7220 for req.
2. Special inspector reqd for all structural elements. Upon completion of project the engineer shall submit a letter stating bld was constructed per plan.
3. Bld and site shall meet handicap accessibility req of 1997 UBC. Upon completion of project the architect or engineer shall submit a letter stating bld and site meet the accessibility req of the 1997 UBC.

Detention New Runoff Relief small small

FOR MORE INFO REFER TO:
BOUNDARY SURVEY
3.518 ACRES by
RIEWE & WISCHMEYER, INC.
CONSULTING ENGINEERS
DALLAS, TEXAS

ADDISON EXPRESS HANGER ADDITION
4500 Claire Chennault
Addison, Texas

PLAN VIEW
CONTOURS & DRAINAGE PLAN

WECO ENGINEERING CO
406 Erle Street
Cleburne, Texas 76031
(817) 645-1160

REV.	DATE	DESCRIPTION

DWG NO. addison2

G-2

DATE: 05-27-00