As Builts

Gas Line 2"
water Line 2"
Gas Line 1½"

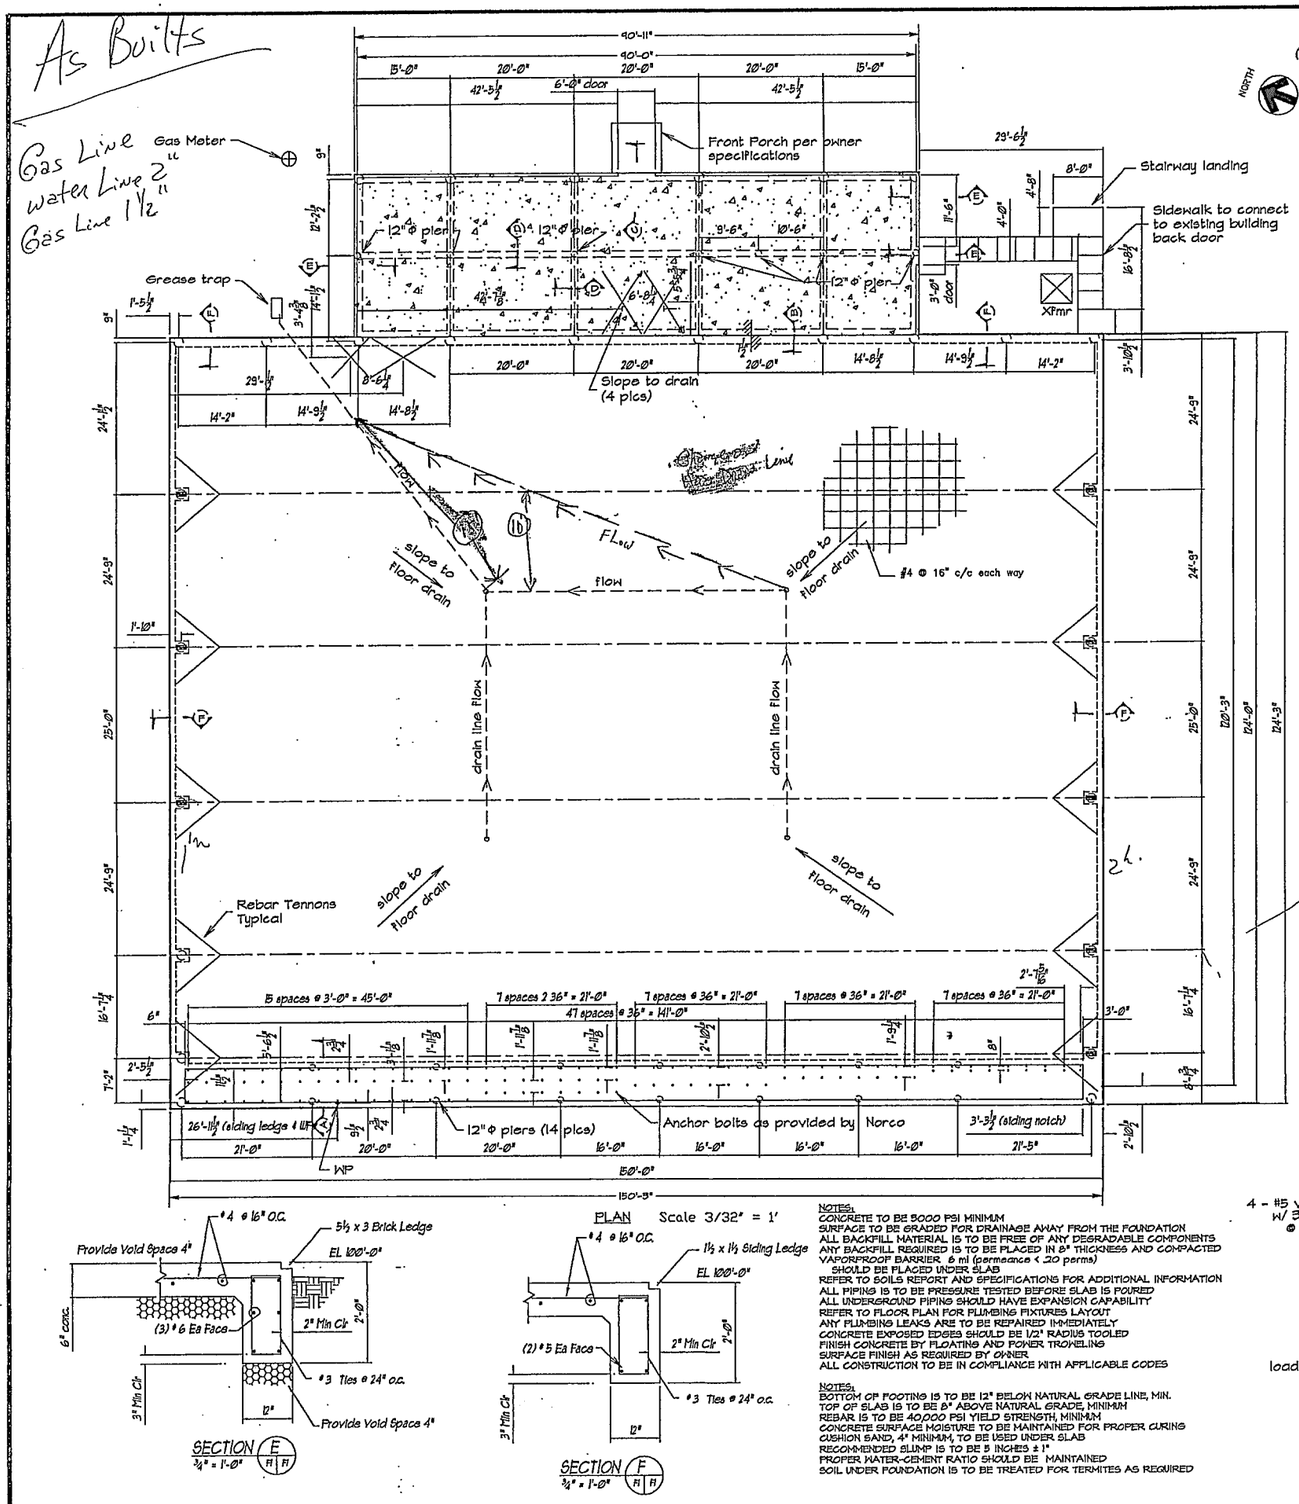

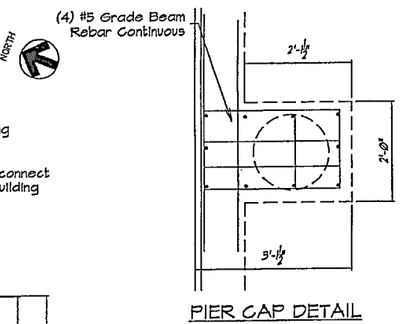

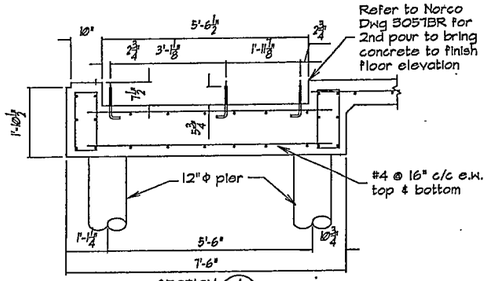

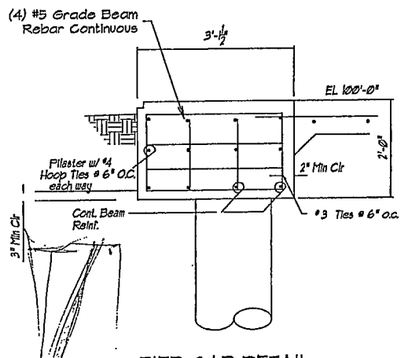

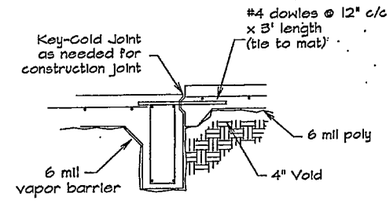

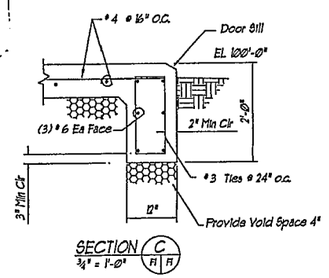

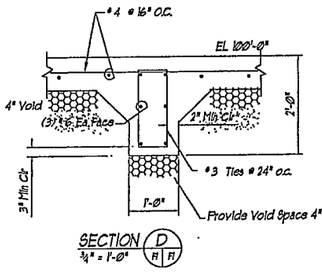

NOTES:
CONCRETE TO BE 5000 PSI MINIMUM
SURFACE TO BE GRADED FOR DRAINAGE AWAY FROM THE FOUNDATION
ALL BACKFILL MATERIAL IS TO BE FREE OF ANY DEGRADABLE COMPONENTS
ANY BACKFILL REQUIRED IS TO BE PLACED IN 8" THICKNESS AND COMPACTED
VAPORPROOF BARRIER 6 mil (permeance < .20 perms) SHOULD BE PLACED UNDER SLAB
REFER TO SOILS REPORT AND SPECIFICATIONS FOR ADDITIONAL INFORMATION
ALL PIPING IS TO BE PRESSURE TESTED BEFORE SLAB IS POURED
ALL UNDERGROUND PIPING SHOULD HAVE EXPANSION CAPABILITY
REFER TO FLOOR PLAN FOR PLUMBING FIXTURES LAYOUT
ANY PLUMBING LEAKS ARE TO BE REPAIRED IMMEDIATELY
CONCRETE EXPOSED EDGES SHOULD BE 1/2" RADIUS TOOLED
FINISH CONCRETE BY FLOATING AND POWER TROWELING
SURFACE FINISH AS REQUIRED BY OWNER
ALL CONSTRUCTION TO BE IN COMPLIANCE WITH APPLICABLE CODES

NOTES:
BOTTOM OF FOOTING IS TO BE 12" BELOW NATURAL GRADE LINE, MIN.
TOP OF SLAB IS TO BE 8" ABOVE NATURAL GRADE, MINIMUM
REBAR IS TO BE 40,000 PSI YIELD STRENGTH, MINIMUM
CONCRETE SURFACE MOISTURE TO BE MAINTAINED FOR PROPER CURING
CUSHION SAND, 4" MINIMUM, TO BE USED UNDER SLAB
RECOMMENDED SLUMP IS TO BE 5 INCHES ± 1"
PROPER WATER-CEMENT RATIO SHOULD BE MAINTAINED
SOIL UNDER FOUNDATION IS TO BE TREATED FOR TERMITES AS REQUIRED

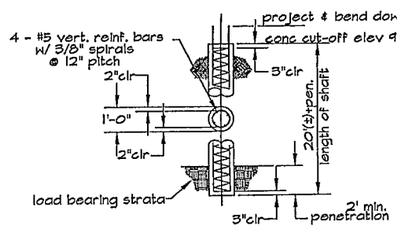

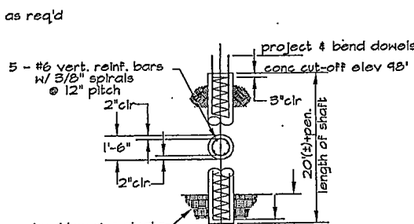

NOTE FINISH FLOOR 100' IS A NOMINAL ELEV.
REFER TO SITE PLAN FOR ACTUAL ELEV.

ADDISON EXPRESS HANGER ADDITION
4500 Claire Chennault
Addison, Texas

PLAN VIEW
BUILDING FOUNDATION

WECO ENGINEERING CO
406 Erie Street
Cleburne, Texas 76031
(817) 645-1160

REV.	DATE	DESCRIPTION

DWG NO. addison5

F-1

DATE: 07-27-00