


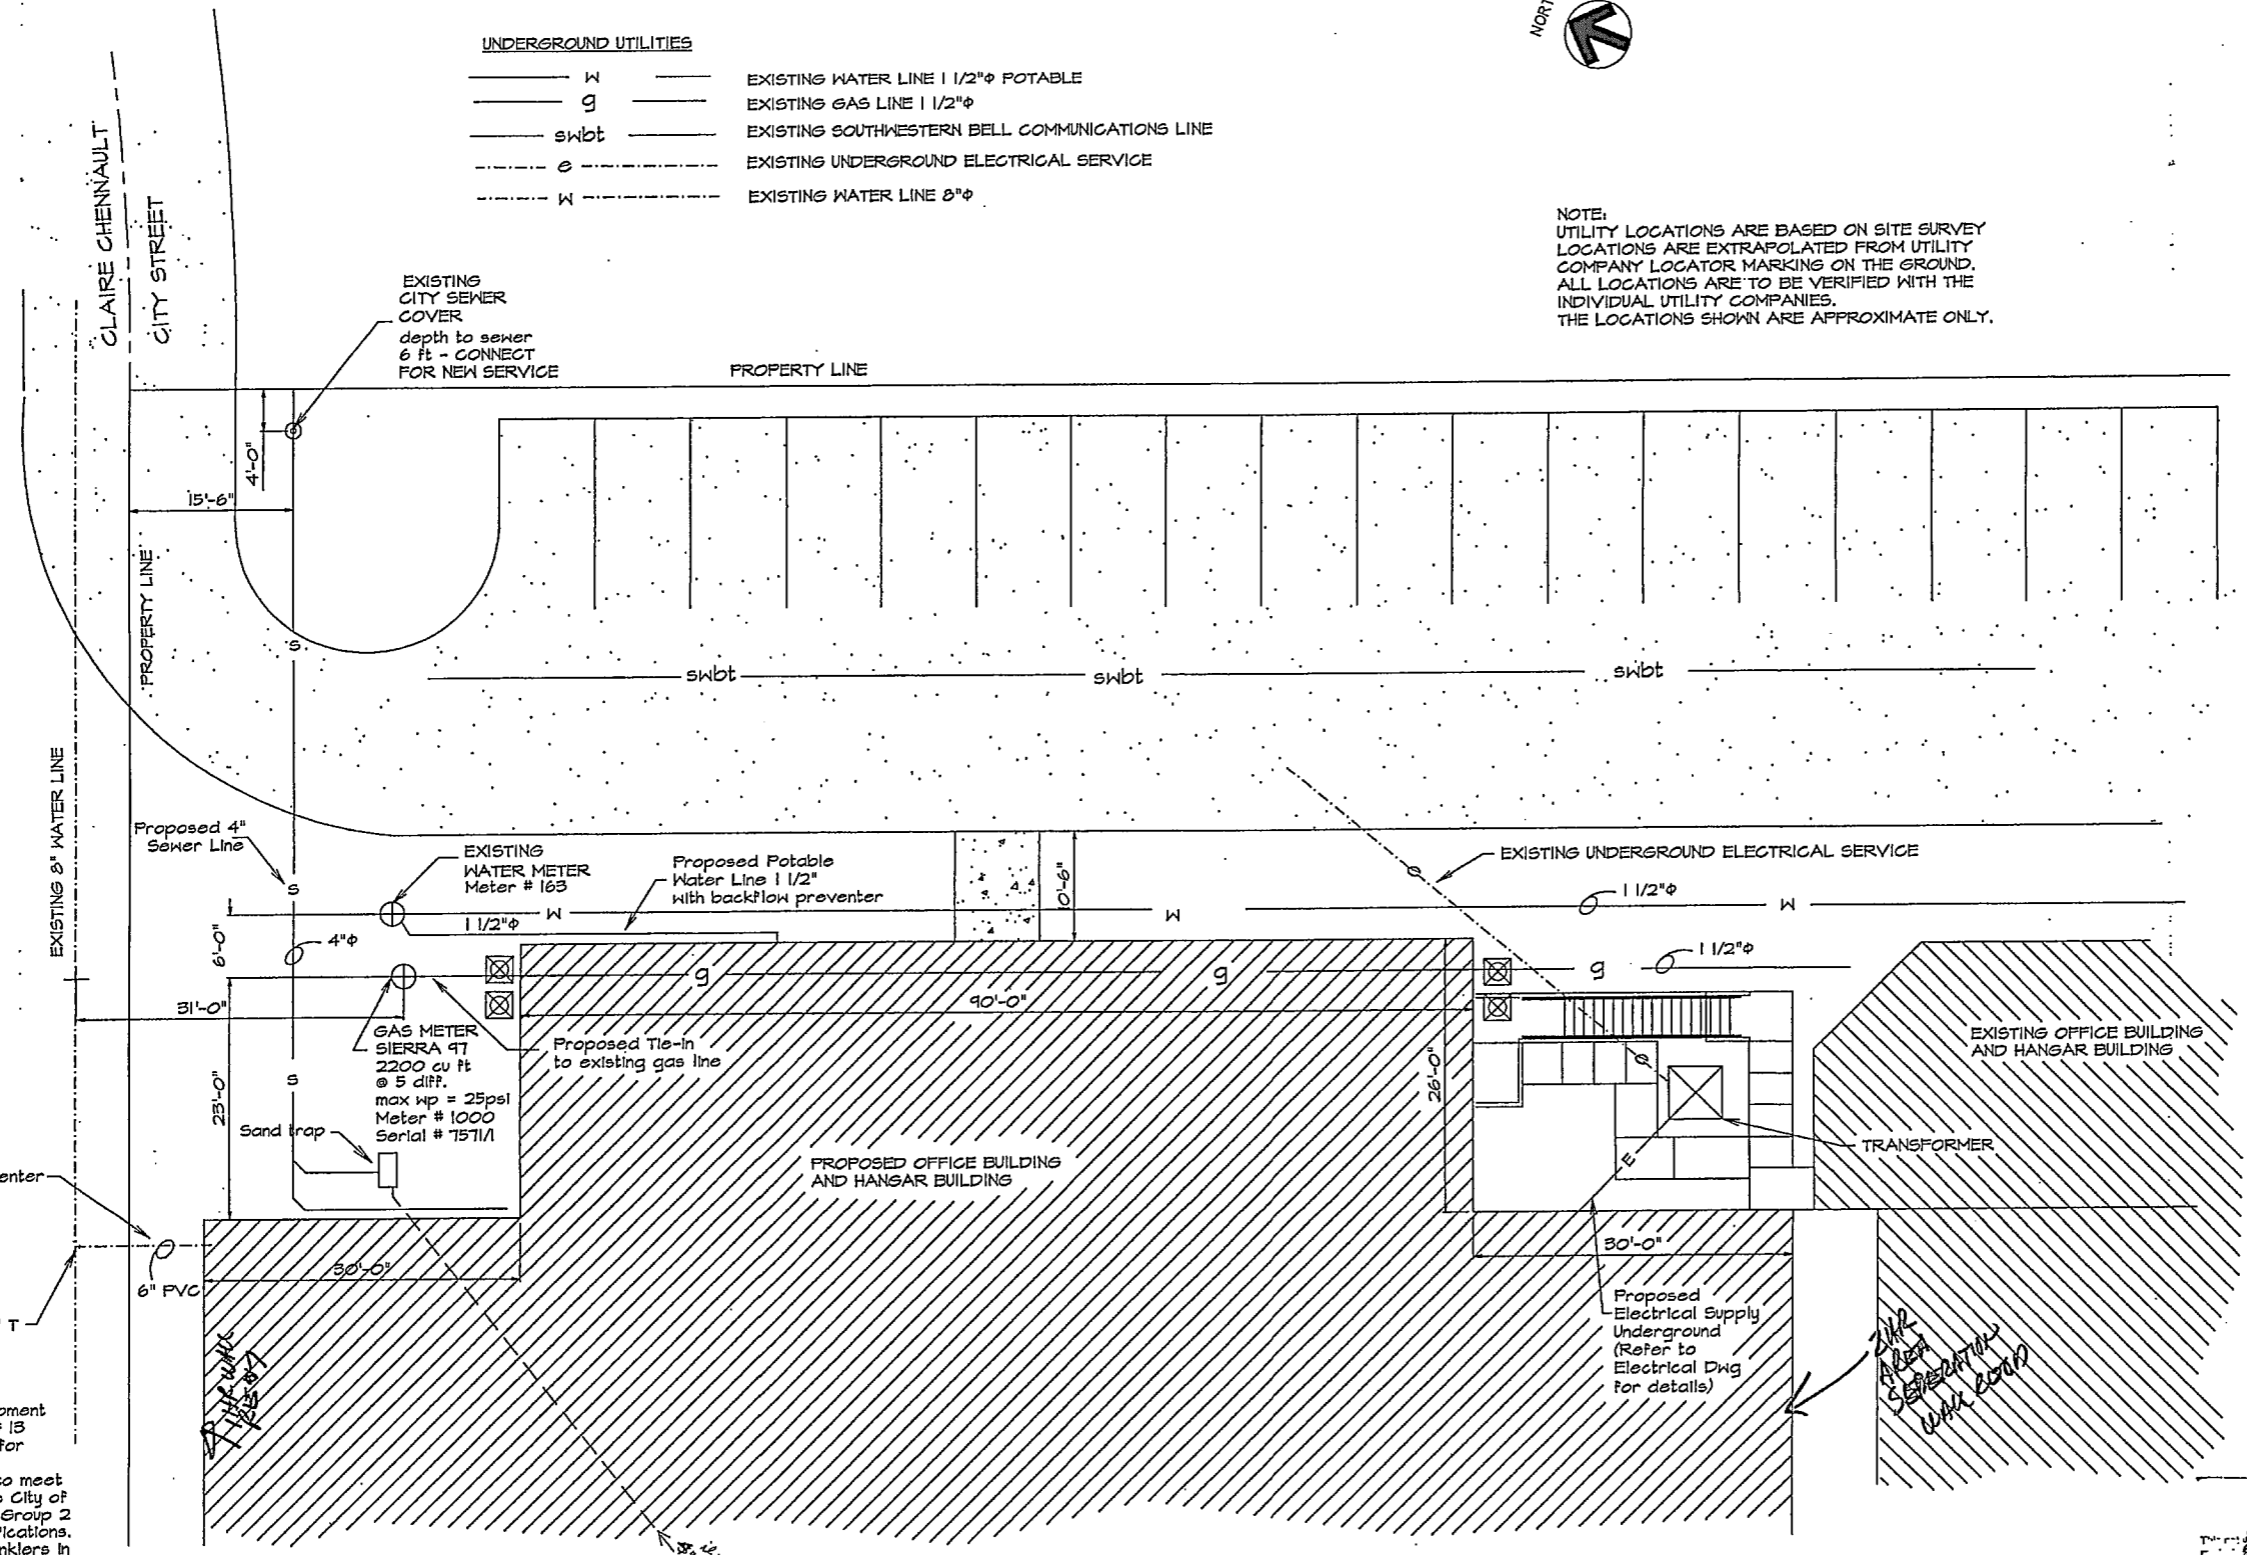

- UNDERGROUND UTILITIES**
- W — EXISTING WATER LINE 1 1/2"φ POTABLE
 - G — EXISTING GAS LINE 1 1/2"φ
 - swbt — EXISTING SOUTHWESTERN BELL COMMUNICATIONS LINE
 - - - e - - - EXISTING UNDERGROUND ELECTRICAL SERVICE
 - - - W - - - EXISTING WATER LINE 8"φ


NOTE:
 UTILITY LOCATIONS ARE BASED ON SITE SURVEY
 LOCATIONS ARE EXTRAPOLATED FROM UTILITY
 COMPANY LOCATOR MARKING ON THE GROUND.
 ALL LOCATIONS ARE TO BE VERIFIED WITH THE
 INDIVIDUAL UTILITY COMPANIES.
 THE LOCATIONS SHOWN ARE APPROXIMATE ONLY.



PLAN

NOTE:
 All materials and equipment
 will conform to NFPA # 13
 and will be approved for
 fire protection.
 All work will be done to meet
 NFPA # 404.16 and the City of
 Addison approval for Group 2
 Aircraft Hangar specifications.
 Brass upright fire sprinklers in
 all exposed areas and chrome
 pendent sprinklers with two piece
 chrome escutcheons in areas with
 suspended ceilings will be provided.
 All work will be done by qualified
 craftsmen in a safe manner.
 All work will be guaranteed for one
 year and all parts will be new and
 approved.

ADDISON EXPRESS
 HANGER ADDITION
 4500 Claire Chennault
 Addison, Texas

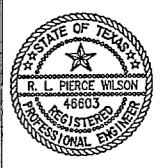

OFFICE AREA
 UTILITY LOCATIONS
 Scale 1/8" = 1'-0"

MECO ENGINEERING CO
 406 Erie Street
 Cleburne, Texas 76031
 (817) 645-1160

DATE	DESCRIPTION

DWG NO. addisonP
 P-2

DATE: 11-10-00

