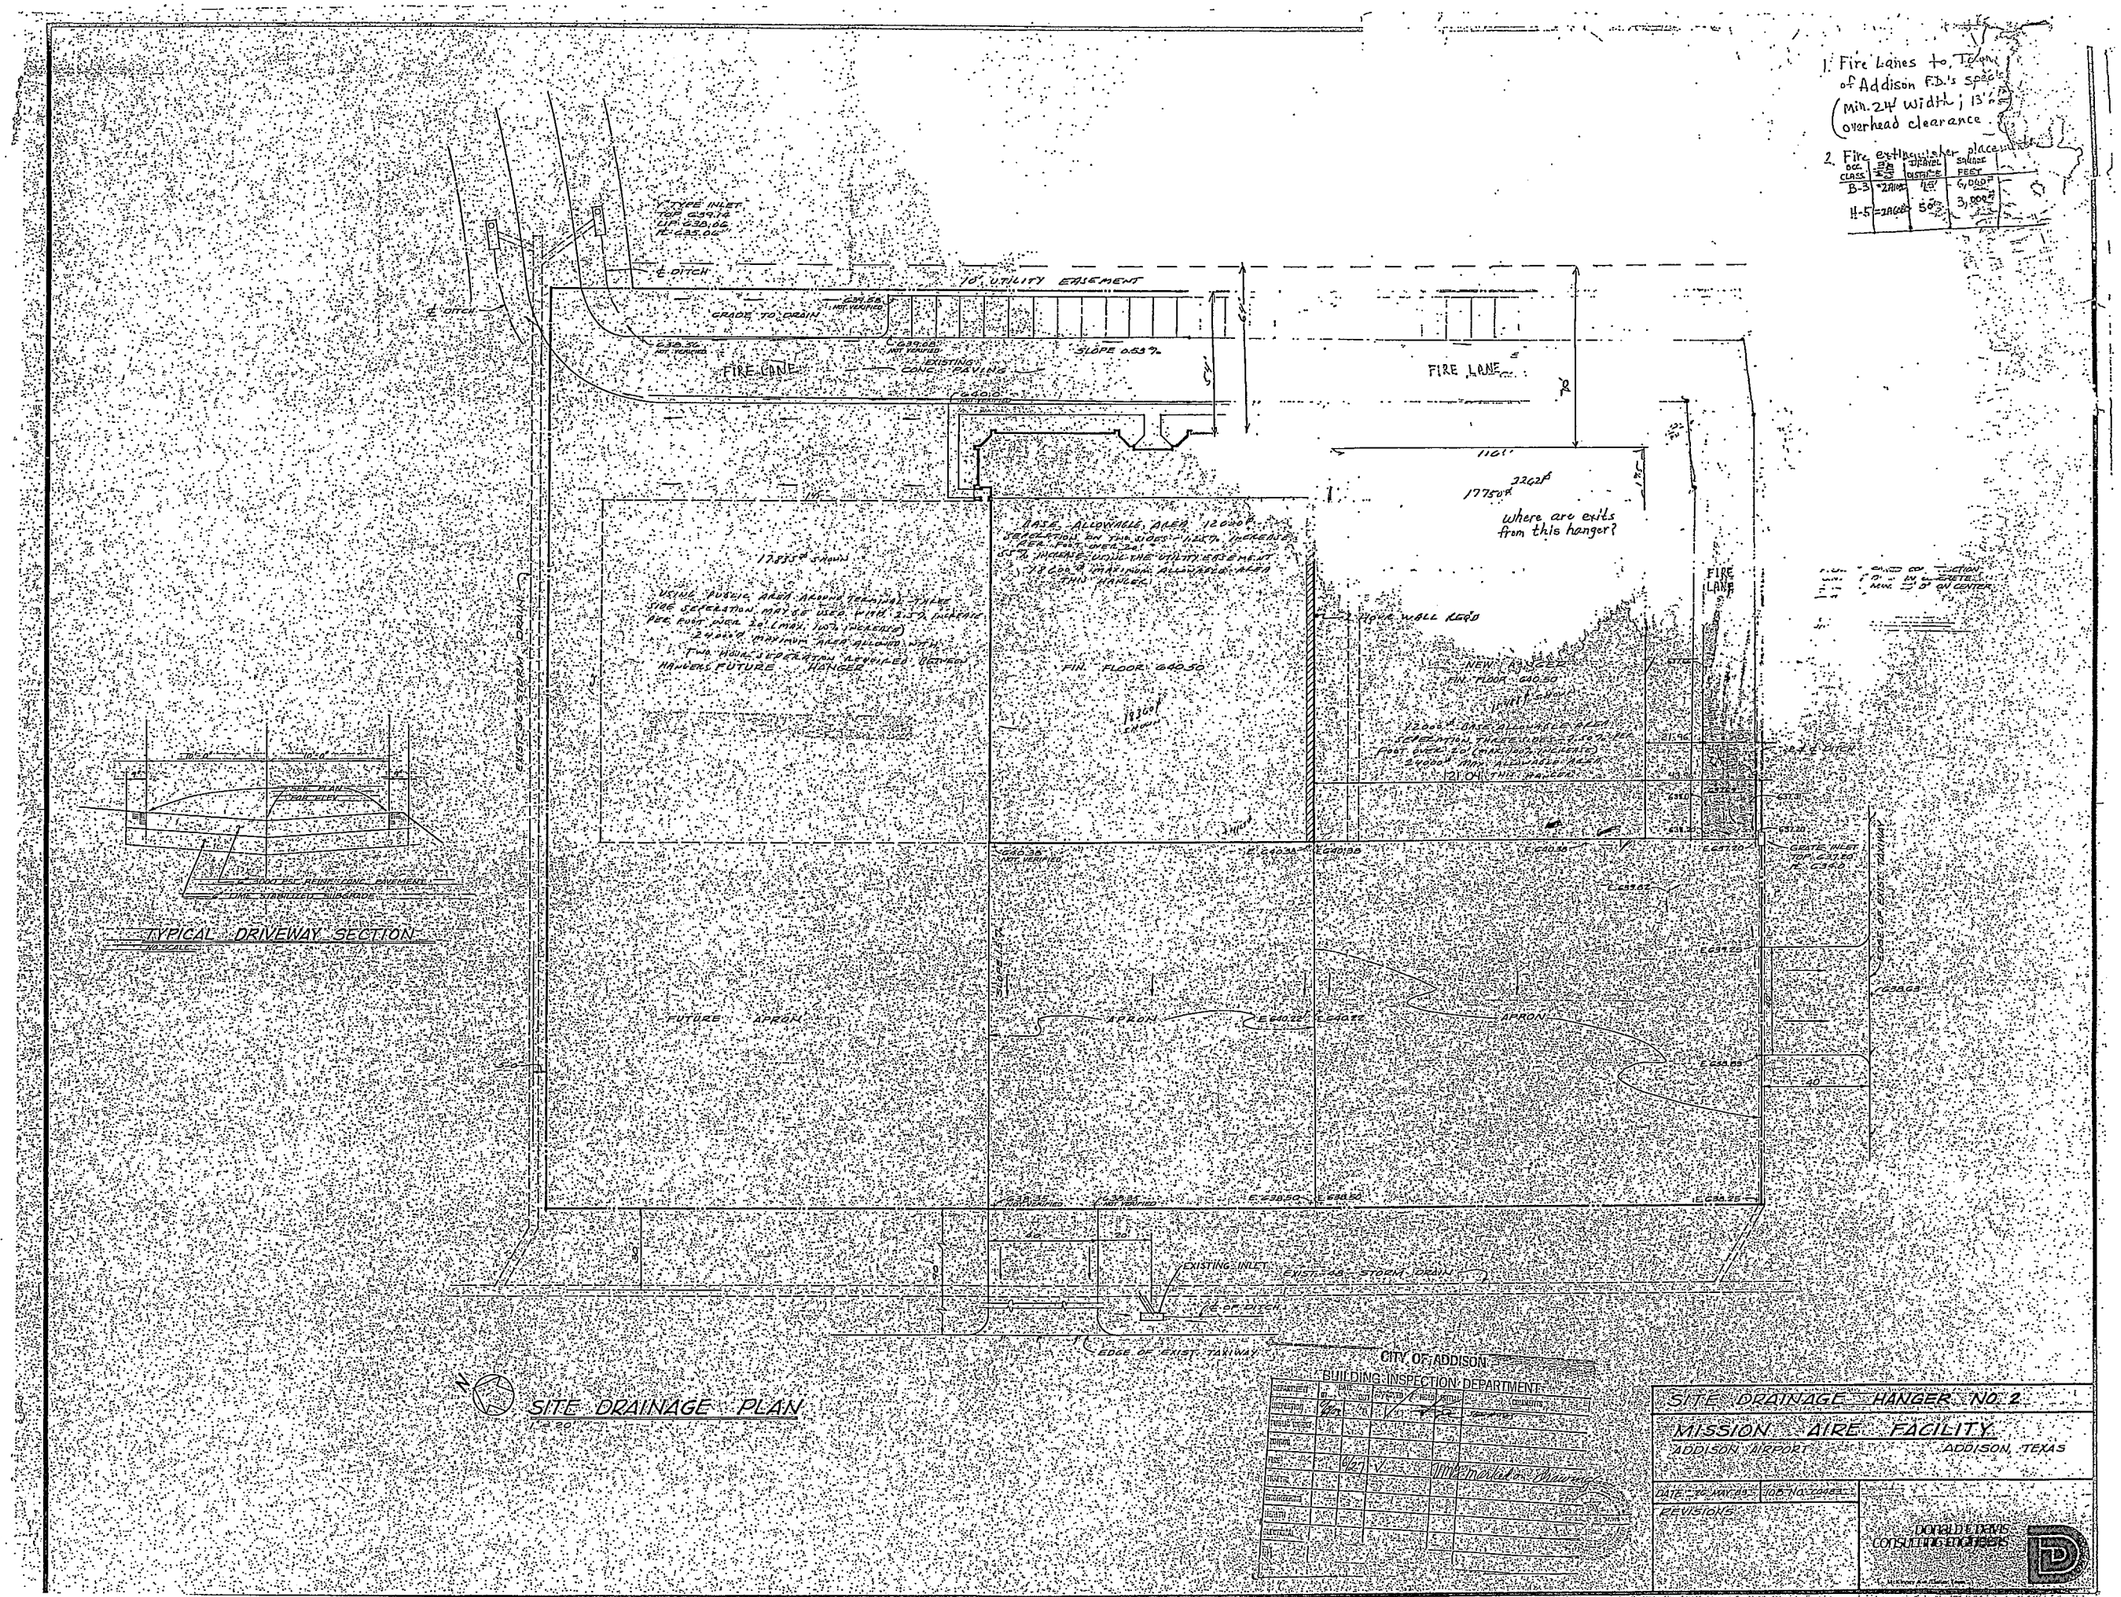

1. Fire Lanes to Town of Addison F.D.'s specs (Min. 24' width; 13'6" overhead clearance
2. Fire extinguisher placement
OCC. CLASS
B-3
H-5
DRAWN
DISTANCE
SQUARE FEET
6,000
3,000
10' UTILITY EASEMENT
GRADE TO DRAIN
FIRE LANE
SLOPE 0.53%
EXISTING CONC. PAVING
17855 SHOWN
BASE ALLOWABLE AREA 12000
FIN. FLOOR 640.50
where are exits from this hanger?
NEW HANGER
FIN. FLOOR 640.50
FUTURE APRON
APRON
EXISTING INLET
EDGE OF EXIST. TAXIWAY
TYPICAL DRIVEWAY SECTION
SITE DRAINAGE PLAN
CITY OF ADDISON
BUILDING INSPECTION DEPARTMENT
SITE DRAINAGE HANGER NO. 2
MISSION AIRE FACILITY
ADDISON AIRPORT
ADDISON, TEXAS
REVISIONS
DONALD E. DAVIS CONSULTING ENGINEERS