
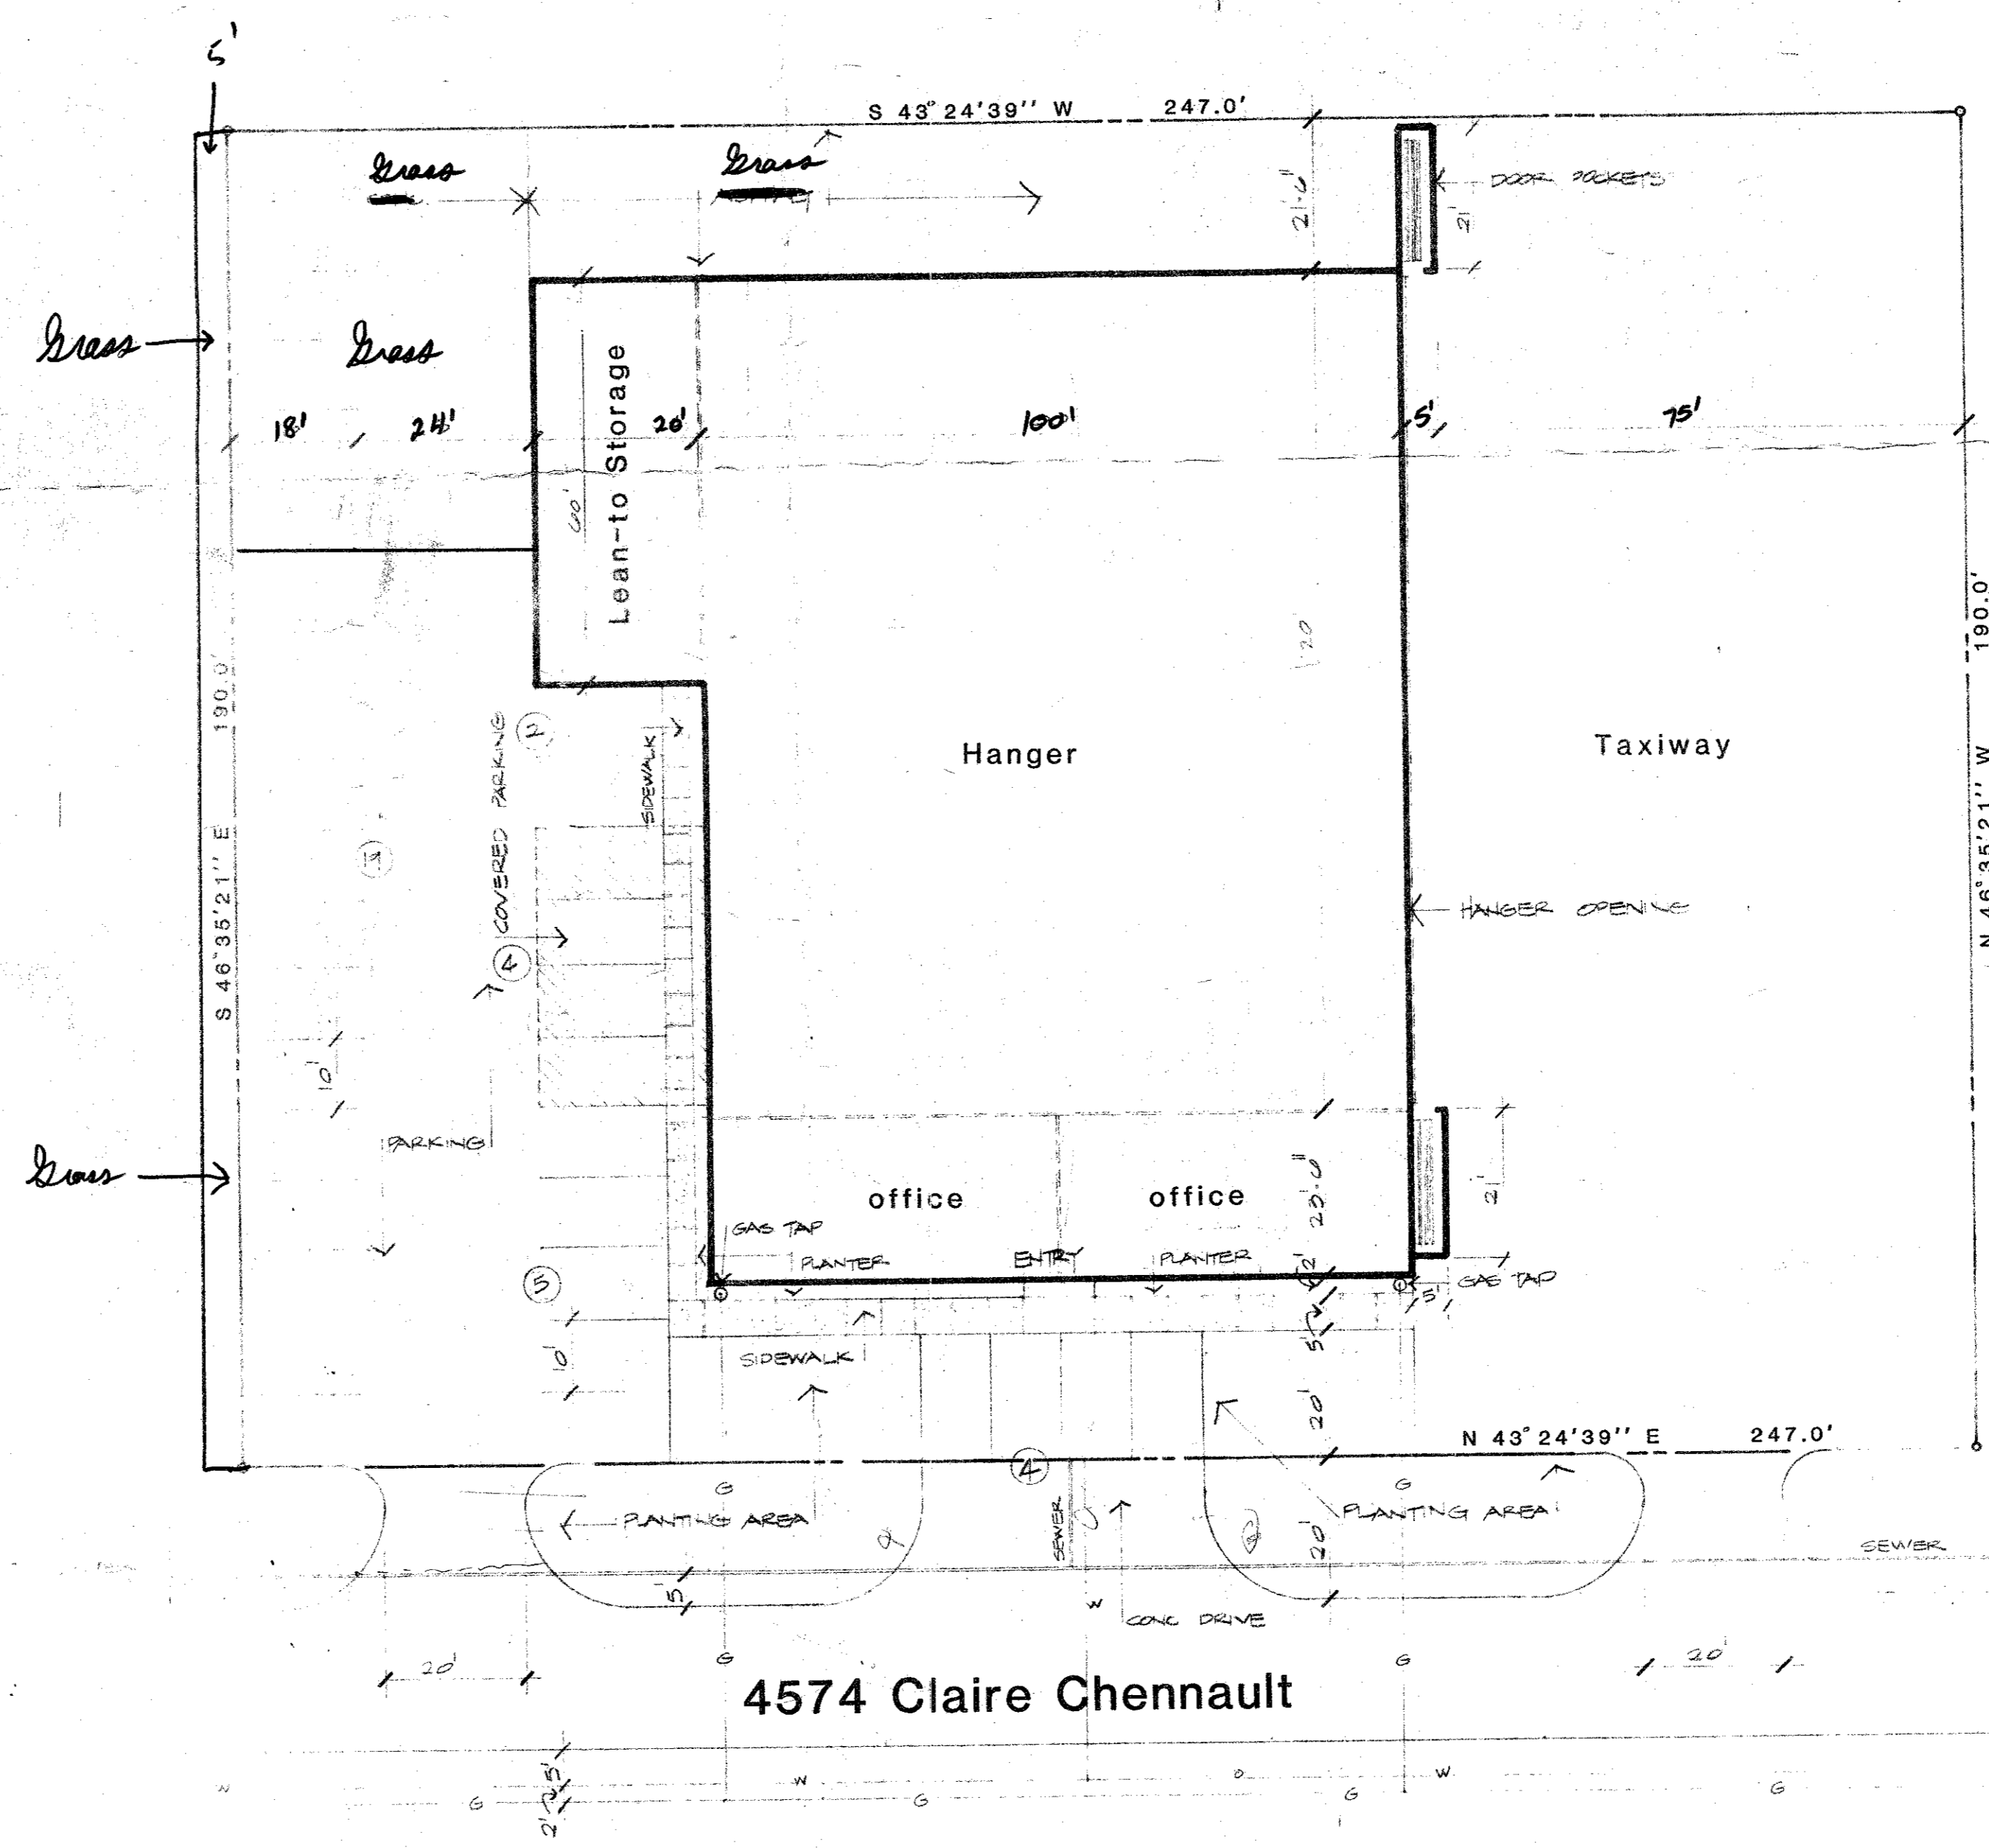


tgma, inc.
 Architecture
 Planning

2351 Gus Thomasson, Suite 123
 Dallas, Texas 75228
 Phone (214) 347-2440

PHARRIS - MILLER, inc.
 ADDISON AIRPORT
 Addison, Texas

JOB	100-82
DATE	MARCH 3, 1972
DRAWN	BE
CHECKED	BE

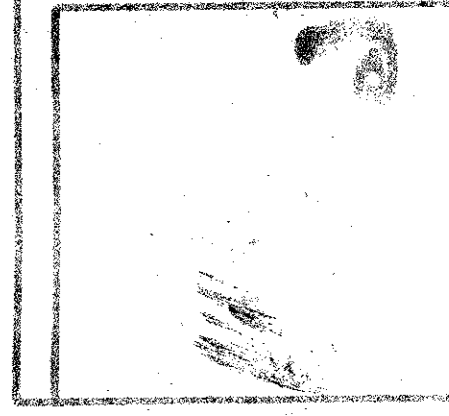

- 3" CONCRETE SLAB
PARKING
WALKS
DRIVES
- 5" CONCRETE SLAB
TAXIWAY
HANGER
GRADE EDGE

TABULATIONS

LAND AREA	46,121 SQ FT
HANGER AREA	7,500 SQ FT
COVERAGE	65%

4574 Claire Chennault

← SITE PLAN