CONSTRUCTION NOTES:

(STA. 0+00 to 1+89 See Typ. Detail Sht.)

The following notes correspond by station number with the appropriate typical detail drawing.

1. Saw And Remove Existing Concrete Required To Construct The Water Line With Appurtenances, As Shown With Typical Detail Drawing. Pay Item No. 100.1
2. Replace With 8" Thick, 3000 psi. Concrete Slab, As Shown With Typical Detail Drawing. Pay Item No. 101.1
3. Special Care Shall Be Taken Not To Disturb The Loop Detectors. If Damaged During Construction, Repair Shall Be Made By The Contractor At No Additional Compensation. All Conduit Damaged Shall Be Repaired Or Replaced To The Engineers Satisfaction.

NOTE:

1. Contractor Shall Determine The Exact Location And Depth Of The Underground Utilities Shown Prior To Construction By Contacting The Utility Companies. The Utility Elevations Shown Are Only Approximate.
2. Contractor Shall Be Responsible For Any Utility Damages Resulting From Construction.
3. Contractor Shall Repair Or Replace Any Damaged Utility Equal To Or Better Than The Original Condition At No Additional Compensation.

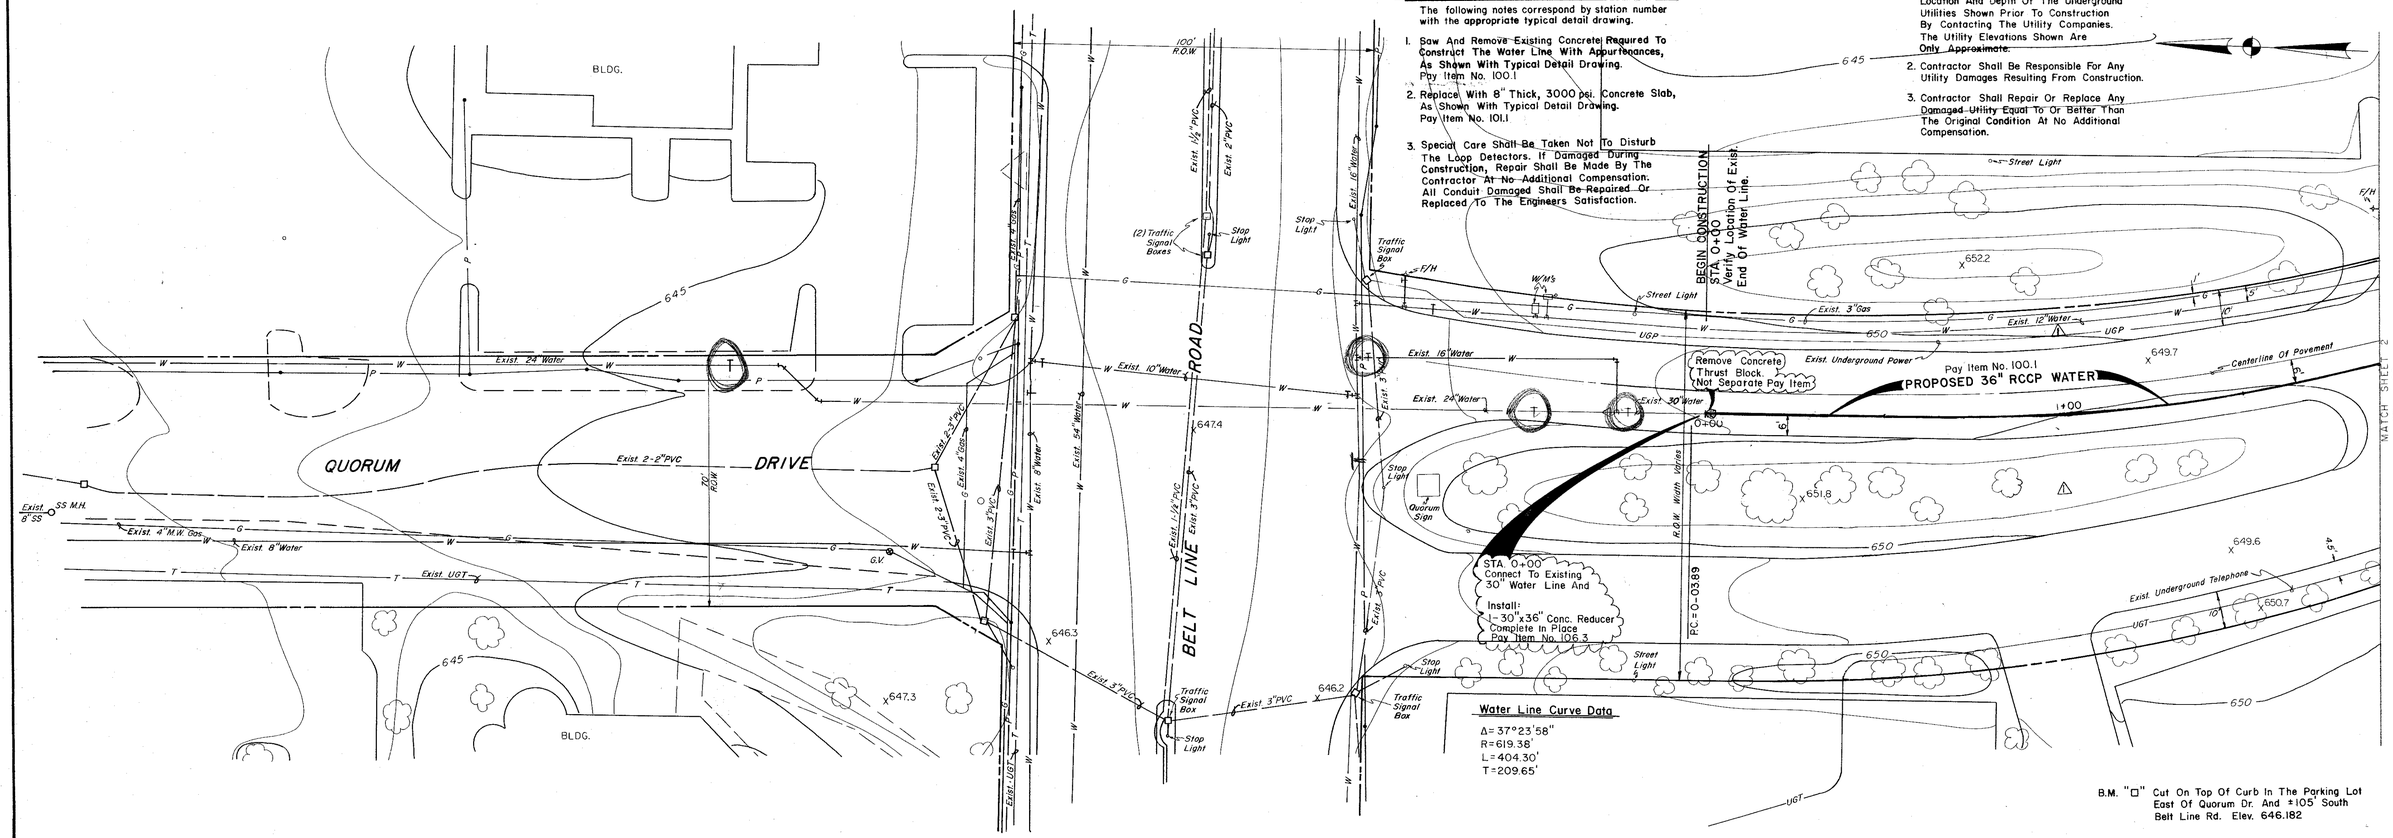

Water Line Curve Data

Δ=37°23'58"
R=619.38'
L=404.30'
T=209.65'

B.M. "□" Cut On Top Of Curb In The Parking Lot East Of Quorum Dr. And ±105' South Belt Line Rd. Elev. 646.182

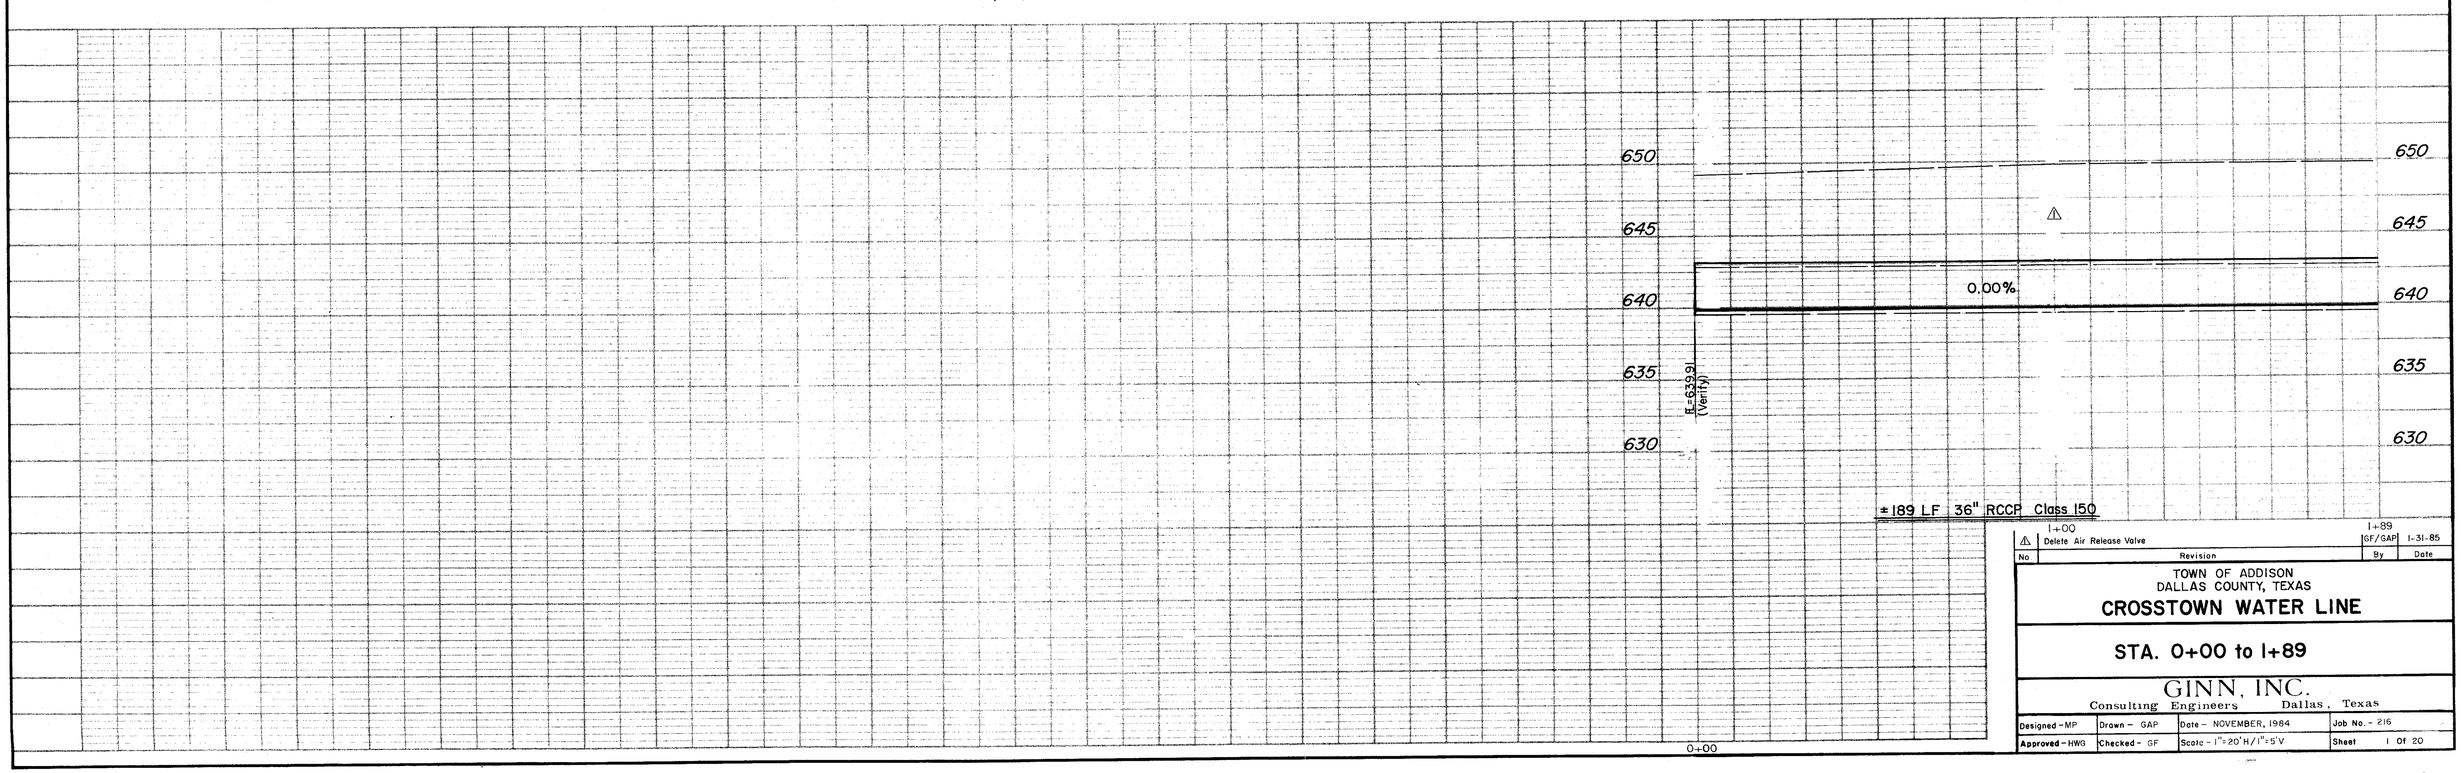

No.	Revision	By	Date
1	Delete Air Release Valve	GF/GAP	1-31-85

TOWN OF ADDISON
DALLAS COUNTY, TEXAS

CROSSTOWN WATER LINE

STA. 0+00 to 1+89

GINN, INC.
Consulting Engineers Dallas, Texas

Designed - MP	Drawn - GAP	Date - NOVEMBER, 1984	Job No. - 216
Approved - HWG	Checked - GF	Scale - 1"=20'H/1"=5'V	Sheet 1 Of 20