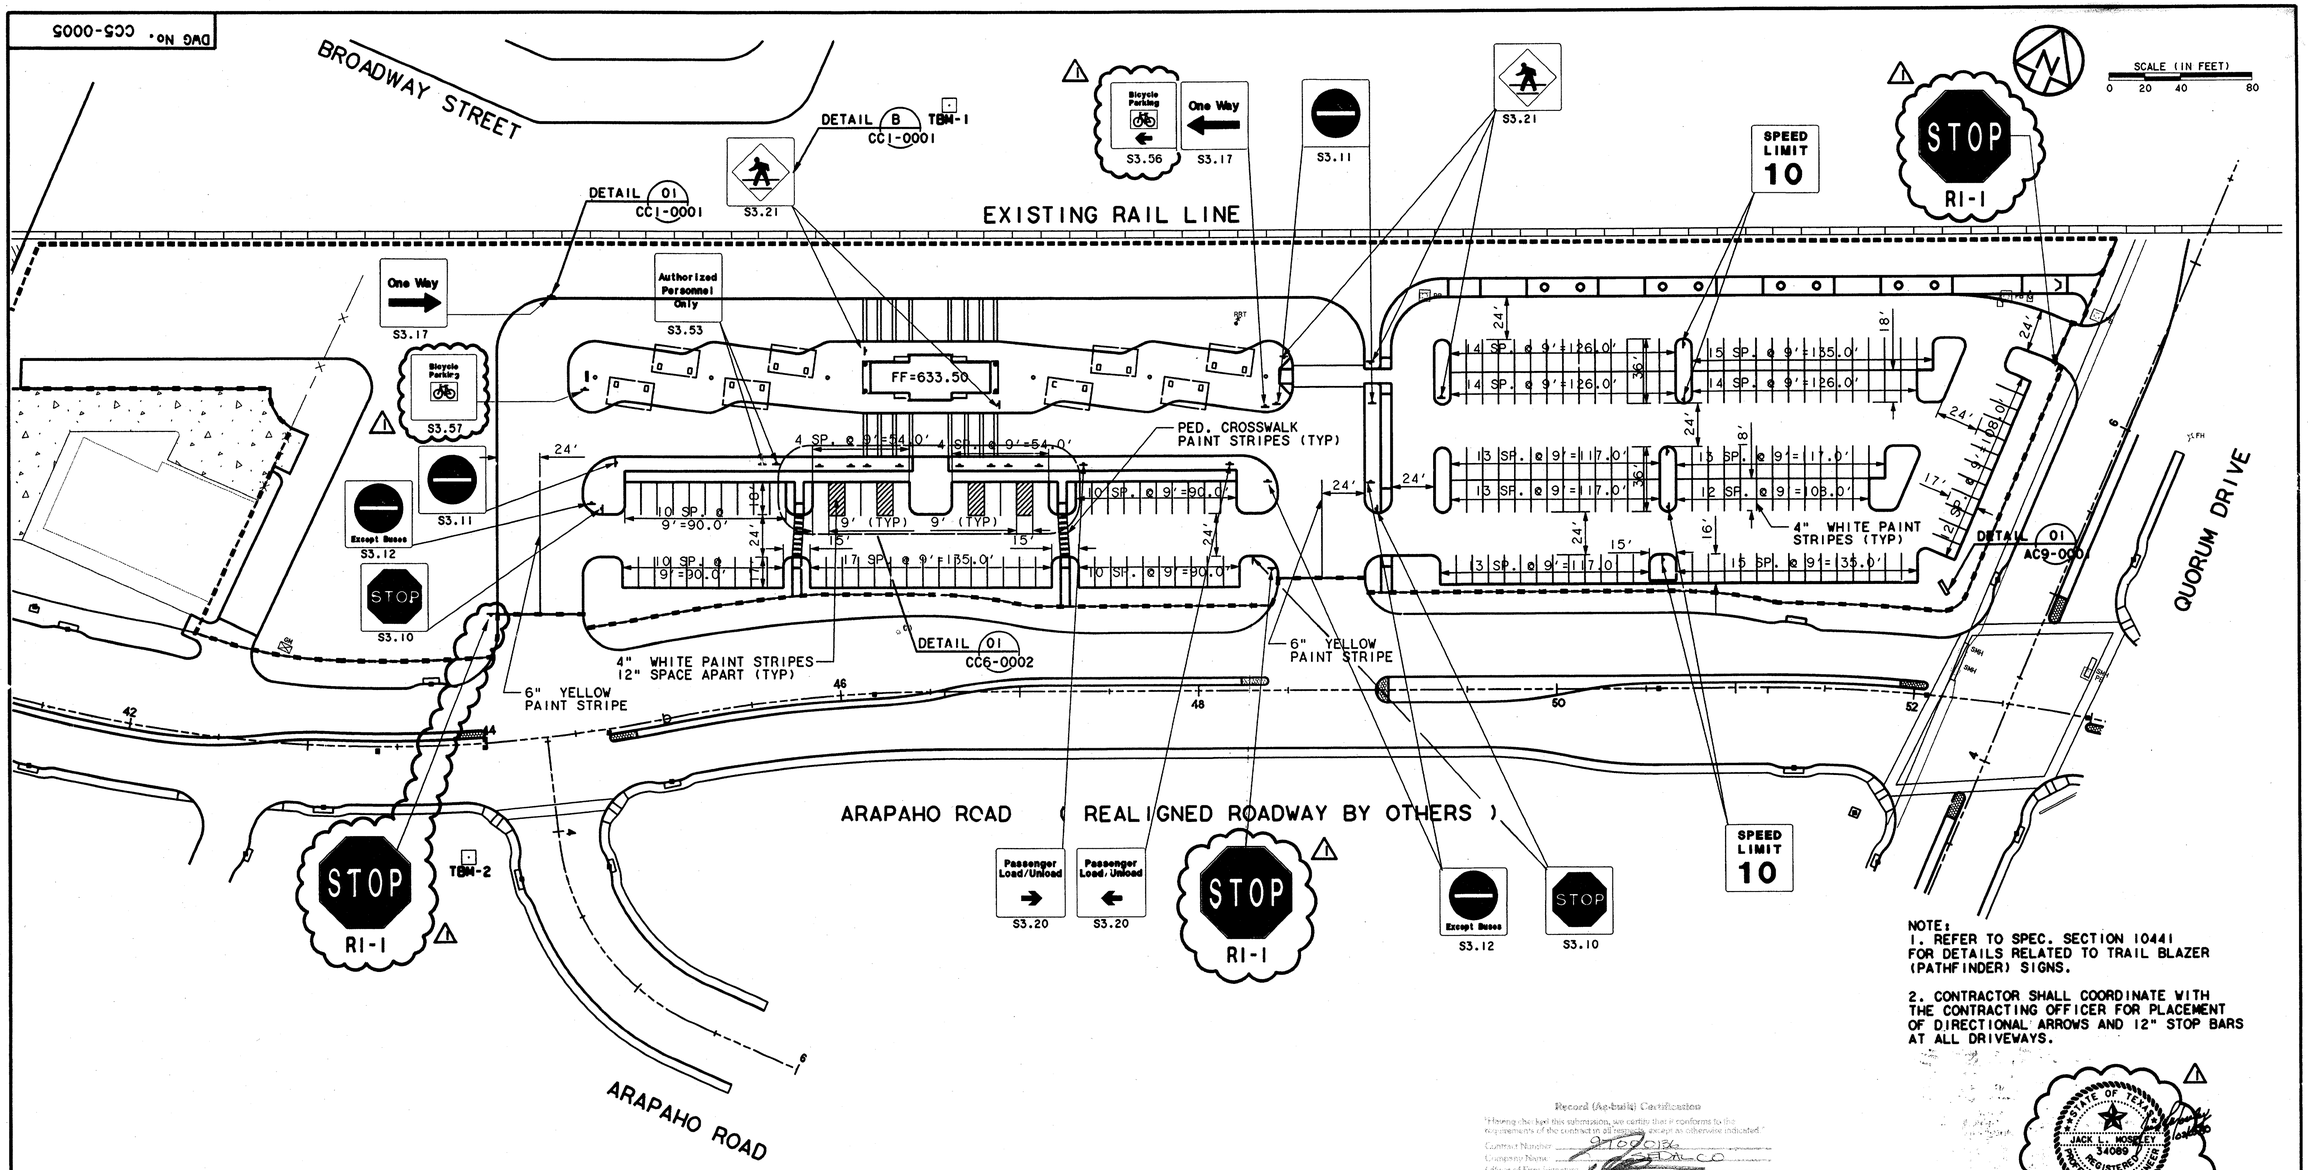

NOTE:
1. REFER TO SPEC. SECTION 10441 FOR DETAILS RELATED TO TRAIL BLAZER (PATHFINDER) SIGNS.

2. CONTRACTOR SHALL COORDINATE WITH THE CONTRACTING OFFICER FOR PLACEMENT OF DIRECTIONAL ARROWS AND 12" STOP BARS AT ALL DRIVEWAYS.

Record (As-built) Certification

"Having the full this submission, we certify that it conforms to the requirements of the contract in all respects except as otherwise indicated."

Contract Number: 97000136
Company Name: TRAL CO
Officer of Firm (signature):
Date:
Officer of Firm Name (type): TOM KNOTT
Title of Officer (type): PRESIDENT

Sealed Professional Engineer of Construction Contractor, including signature and date, together with "as-built" drawings for accepted "as-built" changes and/or additions, must be placed below.

RONALD D. WILLIAMS 61 REGISTERED PROFESSIONAL ENGINEER
7-7-99

STATE OF TEXAS
JACK L. MOSELEY
34089
REGISTERED PROFESSIONAL ENGINEER

THE SEAL OF JACK L. MOSELEY P.E. No. 34089 SHOWN HEREON APPLIES ONLY TO THE CHANGES AND/OR MODIFICATIONS TO THE DESIGN INDICATED FOR REVISION No. 1 AS SHOWN IN CLOUDED AREAS.

CE#014 SA#010

REV	DATE	DESCRIPTION	BY	ENG	CHK	APP
1	2/8/99	ADDED BICYCLE RACK	DC	JCM	TJS	JLM

REV	DATE	DESCRIPTION	BY	ENG	CHK	APP

ORIGINAL SEAL(S) RESIDE IN DART FOR THE FOLLOWING REVISION(S):

REV 0: SEALED BY CHRISTOPHER L. MILLER LANDSCAPE ARCHITECT No. 682

WENDY LOPEZ & ASSOC.
LOCKWOOD, ANDREWS & NEWNAM
THE SWA GROUP
GERARD & ASSOCIATES
ZAXON

WLA
WENDY LOPEZ & ASSOCIATES, INC.
ENGINEERING • SURVEYING • CONSTRUCTION SERVICES
1825 MARKET CENTER BLVD - SUITE 510
DALLAS, TEXAS 75207
(214) 741-7777

DART PROJECT

DART

SCALE	1"=40'
DRAWN	D. KRUCIAK
DESIGNED	P. ZHAO
CHECKED	V. STEVENS
IN CHARGE	V. STEVENS
DATE	AUG. 14, 1997

CAES

CONTRACT SHEET No. 26 OF 95

ADDISON TRANSIT CENTER

PAVEMENT MARKING & SIGNING PLAN

CONTRACT	DWG No.	REV
C-97000136	CC5-0005	1

PRF ROTATION=270.000000, f:\transit centers\abtc\dgn\abt
\plot\Tables\lgdart;\bff\cadd\abtccp05.prf Feb 8 14:52:04 1999
DART CADD

SITE, F:\TRANSIT CENTERS\ABTC\abtccpr1.040, 1-11,13-45,47-49,51-60*no ref levels*, abtcrwr1.050, 32
TOPO1, F:\TRANSIT CENTERS\ABTC\abtctpr1.040, 3,4,6,8-10,13-16,18*no ref levels*, 20,23-28,33,34,38*no ref levels*
UTIL, F:\TRANSIT CENTERS\ABTC\abtcutr1.040, 1-62 *no ref levels*
BY*OTHERS, F:\TRANSIT CENTERS\ABTC\basehz.dgn, 2,4-40,43-61 *no ref levels*
BORDER, F:\TRANSIT CENTERS\ABTC\abtcbor1.001, 1-6,15-22,24-31,35*no ref levels*

f:\transit centers\abtc\dgn\abtccp05.040