PRF ROTATION=0.000000
j:\tbl\lgdarf.tbl
J:\PROJ\DARTSTD\DNCTSG34.008
Mon Feb 21 13:20:01 1994
J:\PLOTTING\400M\DNCTSG34.PRF
plot

no ref logical, *no ref name*, *no ref levels*

3ORDER, DNCTBORI.008, 1,3-7,9,11-22,26-62

DWG No. AS9-0024

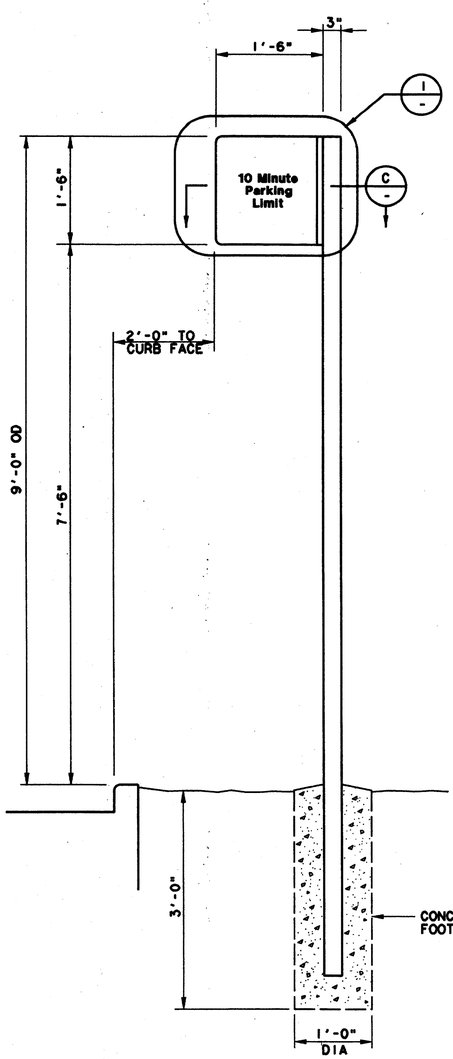

FRONT ELEVATION LANDSCAPED CONDITION (A)

SCALE: 1"=1'-0"

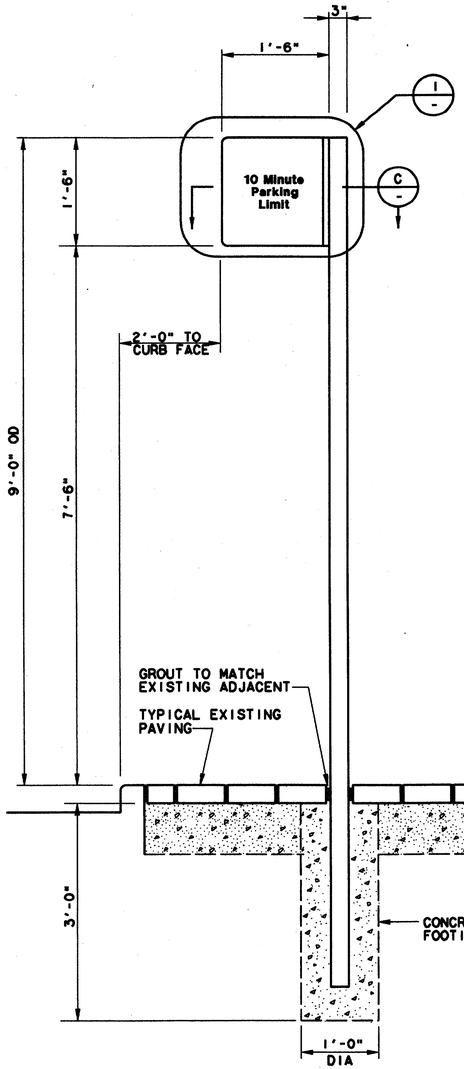

FRONT ELEVATION PLATFORM CONDITION (B)

SCALE: 1"=1'-0"

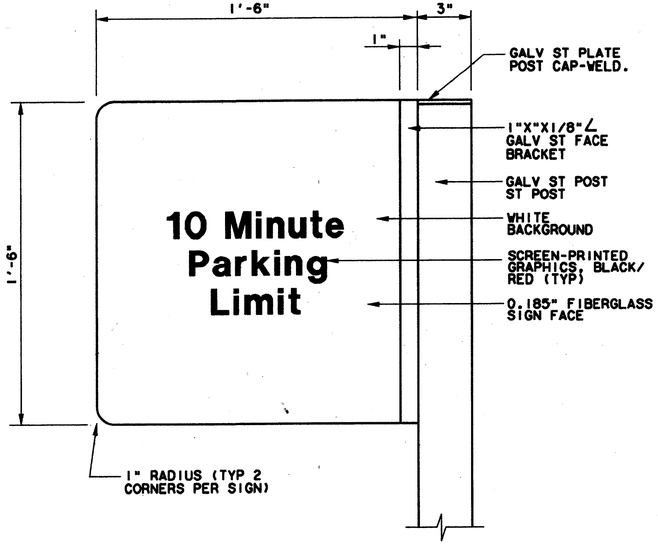

TYPICAL FACE DETAIL (1)

SCALE: 3"=1'-0"

GENERAL NOTES

1. REFER TO DART SIGN STANDARDS MANUAL FOR CORRECT FONTS, SYMBOLS AND REPRODUCTION ART.
2. SIGNS 3.10-3.56 ARE SINGLE FACE CONFIGURATION UNLESS OTHERWISE NOTED ON SITE-SPECIFIC SIGN SCHEDULES.
3. FOR SINGLE FACE CONFIGURATIONS PAINT BACK SIDE OF SIGN FACE TO BE WHITE.
4. SIGN POST, CAP AND FACE BRACKET TO BE UNFINISHED FOR LANDSCAPED CONDITIONS. PAINT GRAY FOR PLATFORM CONDITIONS.
5. MOUNT SIGN FACES TO OTHER SIDE OF SIGN POSTS IN CONDITIONS WHERE SIGN POST LOCATION IS LESS THAN 3'-6" FROM CURB OR RIGHT OF WAY.

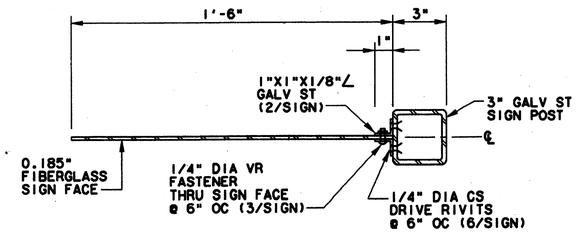

SECTION (C)

SCALE: 3"=1'-0"

Record (As-built) Certification

I hereby stamped this submission, we certify that it conforms to all requirements of the contract in all respects as otherwise noted.

Contract Number: A97000136

Company Name: SEDALCO

Signature of Firm Representative: [signature]

Date: 7-7-99

Name of Firm Representative (typed): TOM KNAPP PRESIDENT

Title of Officer (typed):

Seal or Professional Engineer or Commercial Contractor, indicate signature, and date. For fully scaling record as-built drawings for accuracy. If redline revisions reflected hereon, must be placed below.

7-7-99 **CONFORMED**

REV	DATE	DESCRIPTION	BY	ENG	CHK	APP
1	6-25-93	REVISED ENTIRE SHEET		GS	DS	AZ
2	1-25-94	REVISE ENTIRE SHEET	GS	DS	AZ	

STATE OF TEXAS — JOHN ANTHONY SOSEBEE — 59012 — REGISTERED PROFESSIONAL ENGINEER — 22 FEB 1994

ILIUM

ILIUM ASSOCIATES, INC.
500 108th Avenue NE
Suite 2450
Bellview, WA 98004

HUITT-ZOLLARS
3131 MCKINNEY AVENUE/SUITE 600
DALLAS, TEXAS/214-871-3311

Sverdrup Corporation
Barton-Aschman Associates, Inc.
Arredondo, Brunz & Associates, Inc.
LS Transit Systems
Hellmuth Obata & Kassabaum, Inc.

DART PROJECT

DART

CAES

SCALE	AS NOTED
DRAWN	G. SCOLARO
DESIGNED	A. ZREET
CHECKED	L. BERNAUER
IN CHARGE	D. KELLY
DATE	16 FEB 93

CONTRACT SHEET No. 29 of 95

SIGNAGE STANDARDS

SIGN TYPES S3.50 - S3.56 TRAFFIC CONTROL SIGNS ELEVATIONS, DETAILS, SECTIONS

CONTRACT C-97000136 | DWG No. AS9-0024 | REV 2