PRF ROTATION=270.000000 (C:\TEMP\DART\ab1cdr1\ab1cd105.002)
Mon Mar 18 15:12:17 1998
Q:\BYERS\TABLES\lgd97\NOUSER\ab1cd105.prf
$$USERNAME$$

ORDER, C:\TEMP\DART\ab1cbor1.006, 1-6,13-22,24-29,31-33,36-62 •no ref levels•
SLDKF, C:\TEMP\DART\ab1cafr2.004, 1-39,41-44,47-63 •no ref levels•
'IND', C:\TEMP\DART\ab1cd106.002, 1-39,41-45,47-49,51-62 •no ref levels•
no ref logical•, •no ref name•, •no ref levels•

DWG No. AC2-0012

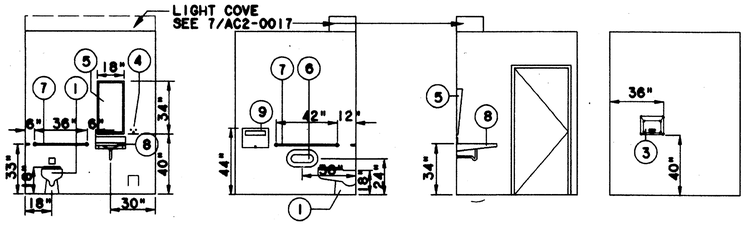

RESTROOM ELEVATION
SCALE: 1/4"=1'-0"

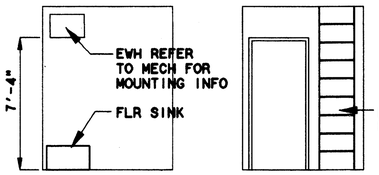

JANITOR RM EL
SCALE: 1/4"=1'-0"

SYM	ITEM	DESCRIPTION	MOUNTING HTS
①	WATER CLOSET	INFARED SENSOR CONTROL DIM TO TOP OF SEAT	18"
②	EWC	DIM TO TOP OF WATER SPOUT	3'-0 & 3'-6"
③	ELEC HAND DRYER	RECESSED MOUNTED DIM TO BOTTOM OF UNIT	3'-4"
④	LIQUID SOAP DISPENSER	RECESSED MOUNTED DIM TO BOTTOM OF UNIT	3'-4"
⑤	MIRROR	FIXED TILT SS MIRROR W/ TAPERED CLOURE ENDS CENTER OVER LABATORY. DIM TO BOTTOM OF MIRROR	3'-4"
⑥	DUAL ROLL TISSUE DISP	SURFACE MOUNTED DIM TO CENTER OF UNIT	2'-0"
⑦	GRAB BAR	DIM TO CENTER OF GRAB BARS	2'-9"
⑧	LAVATORY	INFARED SENSOR CONTROL DIM TO TOP OF LAVATORY	2'-10"
⑨	TOILET SEAT COVER DISP	RECESSED MOUNTED DIM TO TOP OF UNIT	3'-8"
⑩	TRASH CAN	PK S002, 20"X42" SUPPLIED BY PETOSKEY GROUP, COLOR: CAMEL	

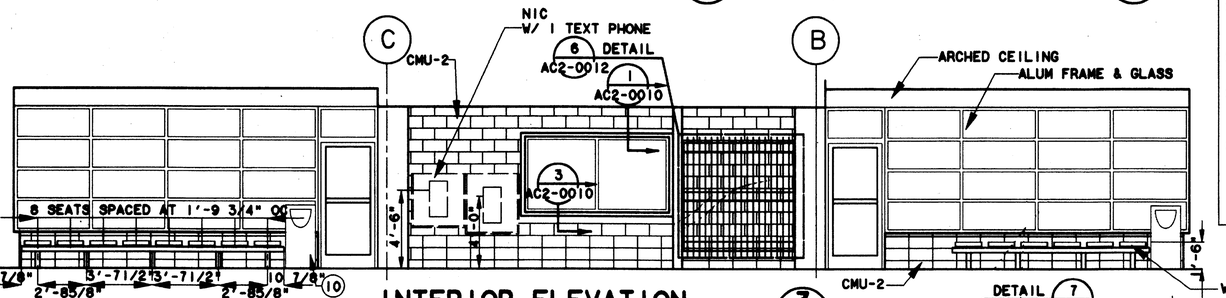

INTERIOR ELEVATION
SCALE: 1/4"=1'-0"

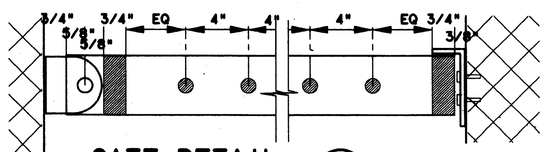

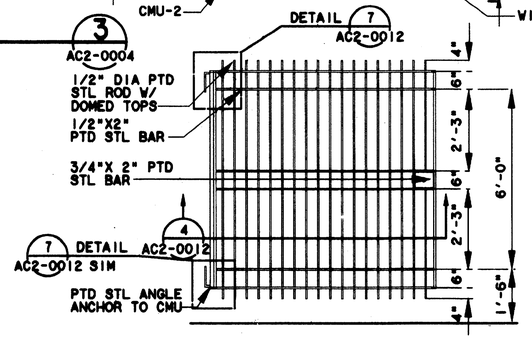

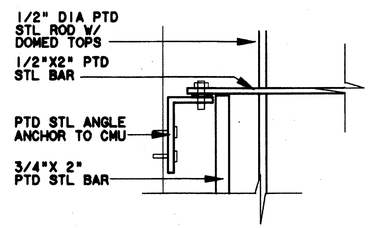

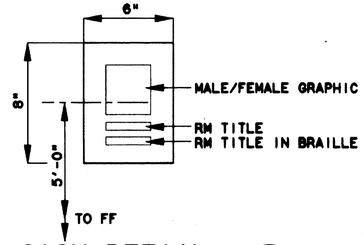

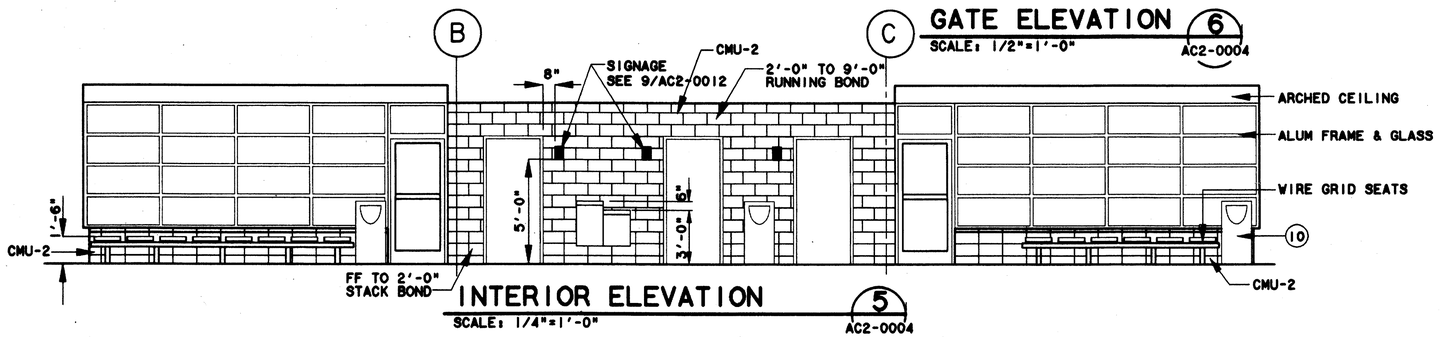

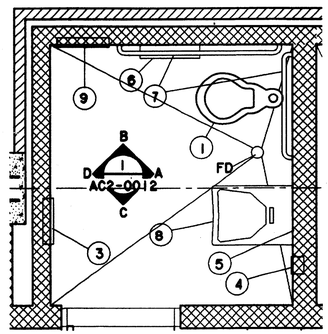

Record (As-built) Certification

"Having checked this submission, we certify that it conforms to the requirements of the contract in all respects, except as otherwise indicated."

Contract Number: 97000136
Company Name: BEDNARCO
Officer of Firm Signature:
Date:
Officer of Firm Name (typed): TOM KADER
Title of Officer (typed): PRESIDENT

Seal of Professional Engineer of Construction Contractor, including signature and date, thereby sealing record (as-built) drawings for accuracy of as-built condition reflected hereon, must be placed below.

7-7-99

CONFORMED

CONTRACT SHEET No. 64 OF 95

REV	DATE	DESCRIPTION	BY	ENG	CHK	APP
0						

Lockwood, Andrews & Newnam, Inc.
A SUBSIDIARY OF LEO A DALY

WENDY LOPEZ & ASSOCIATES, INC.
ENGINEERING • SURVEYING • CONSTRUCTION SERVICES
1825 MARKET CENTER BLVD - SUITE 310
DALLAS, TEXAS 75207
(214) 741-7777

DART PROJECT

SCALE	1/4"=1'-0"
DRAWN	K. DEAN
DESIGNED	N. INFANZON/K. DEAN
CHECKED	N. INFANZON/RON BOLTON
IN CHARGE	V. STEVENS
DATE	14 AUGUST 97

CAES

ADDISON TRANSIT CENTER

INTERIOR ELEVATIONS & GATE DETAILS

CONTRACT C-97000136 | DWG No. AC2-0012 | REV 0