DWG No. AC2-0014




ENCLOSURE SECTION 1
SCALE: 1/4"=1'-0"
AC2-0004




ENCLOSURE SECTION 2
SCALE: 1/4"=1'-0"
AC2-0004

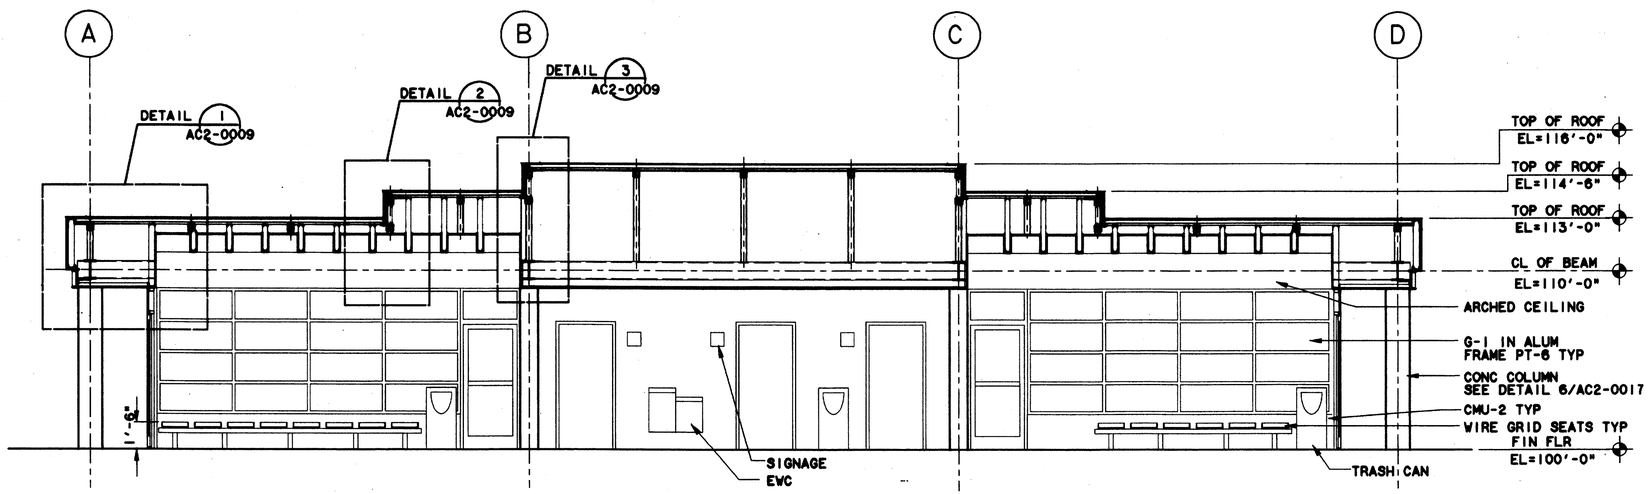


ENCLOSURE SECTION 3
SCALE: 1/4"=1'-0"
AC2-0004

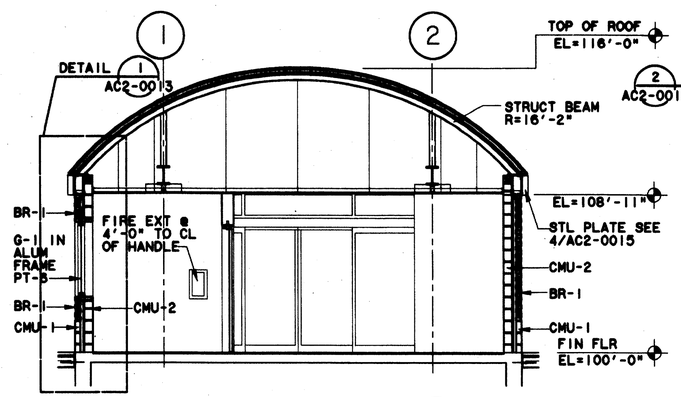


ENCLOSURE SECTION 4
SCALE: 1/4"=1'-0"
AC2-0004

Record (As-built) Certification

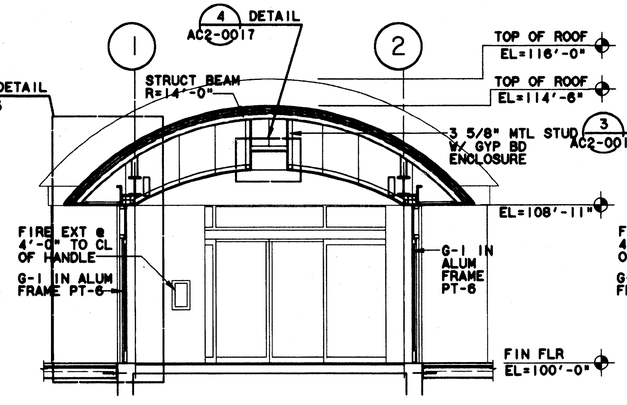"Having checked this submission, we certify that it conforms to the requirements of the contract in all respects, except as otherwise indicated."

Contract Number 97000136
Company Name SEDALCO
Officer of Firm Signature
Date
Officer of Firm Name (typed) TOM KADER
Title of Officer (typed) PRESIDENT

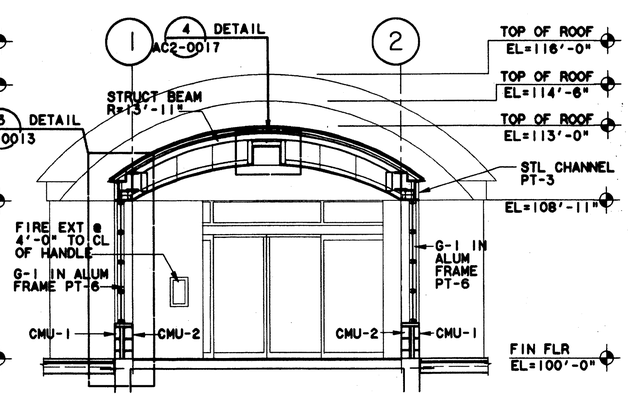Seal of Professional Engineer of Construction Contractor, including signature and date, thereby sealing record (as-built) drawings for accuracy of as-built condition reflected herein, must be placed below:

7-7-99

**CONFORMED**

CONTRACT SHEET No. 66 OF 95

| REV | DATE | DESCRIPTION | BY | ENG | CHK | APP | REV | DATE | DESCRIPTION | BY | ENG | CHK | APP |
|---|---|---|---|---|---|---|---|---|---|---|---|---|---|
| △ | | | | | | | △ | | | | | | |
| △ | | | | | | | △ | | | | | | |
REGISTERED ARCHITECT NESTOR I. INFANZON 11568 STATE OF TEXAS
14 Aug 97

Lockwood, Andrews & Newnam, Inc.
A SUBSIDIARY OF LEO A DALY

WENDY LOPEZ & ASSOCIATES, INC.
ENGINEERING • SURVEYING • CONSTRUCTION SERVICES
1825 MARKET CENTER BLVD - SUITE 510
DALLAS, TEXAS 75207
(214) 741-7777

DART PROJECT

DART

| | |
|---|---|
| SCALE | AS NOTED |
| DRAWN | K. DEAN |
| DESIGNED | N. INFANZON/K. DEAN |
| CHECKED | N. INFANZON/RON BOLTON |
| IN CHARGE | V. STEVENS |
| DATE | 14 AUGUST 97 |

CAES

ADDISON
TRANSIT CENTER

ENCLOSURE WALL
SECTIONS & DETAILS

CONTRACT C-97000136 | DWG No. AC2-0014 | REV 0

PRF ROTATION=270.000000 Wed Mar 18 15:10:33 1998
Q:\BYERS\TABLES\lgdd\QUEUES\abtcdt04.prf
$$USERNAME$$
c:\temp\dart\abtcdt04.002
ORDER, C:\TEMP\DART\abtcbor1.008, 1-6,13-22,24-29,31-33,36-62
•no ref logical•, •no ref name•, •no ref levels•