DWG No. AC9-0001

PRF ROTATION=90.000000
Aug 13 11:20:48 1997
Q:\BYERS\TABLES\lgd07.QUEUES\abtcdt15.prf
$$USERNAME$$

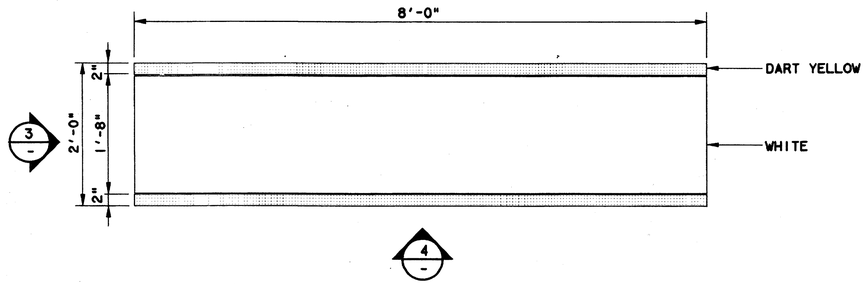

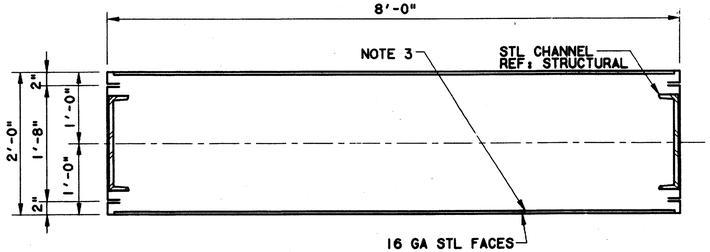

GENERAL NOTES

1. REFER TO DART SIGN STANDARDS MANUAL FOR CORRECT FONTS, SYMBOLS, STATION NAMES AND REPRODUCTION ART.
2. NOT USED
3. PROVIDE 1/2" EXTERIOR GYP BOARD AND 22 GAUGE SHEET METAL BACKUP AS PER SPECIFICATIONS. ⚠
4. SIGN IS DOUBLE FACE CONFIGURATION UNLESS OTHERWISE NOTED ON SITE-SPECIFIC SIGN

PLAN
SCALE: 1"=1'-0" (1)

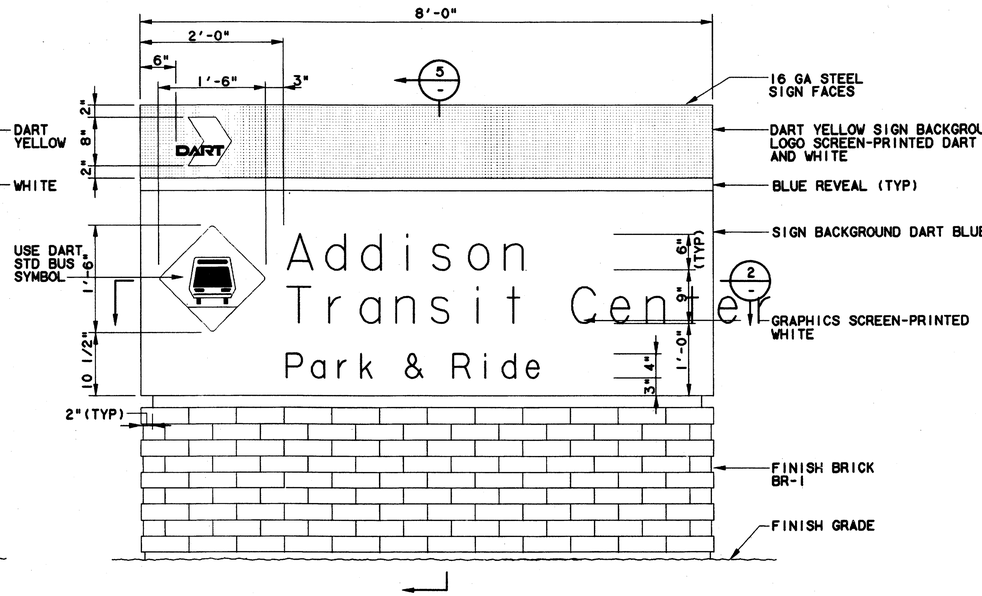

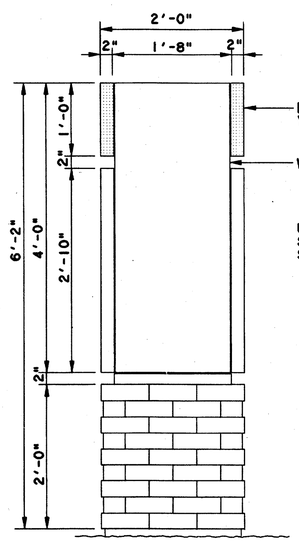

PLAN SECTION (2)
SCALE: 1"=1'-0"

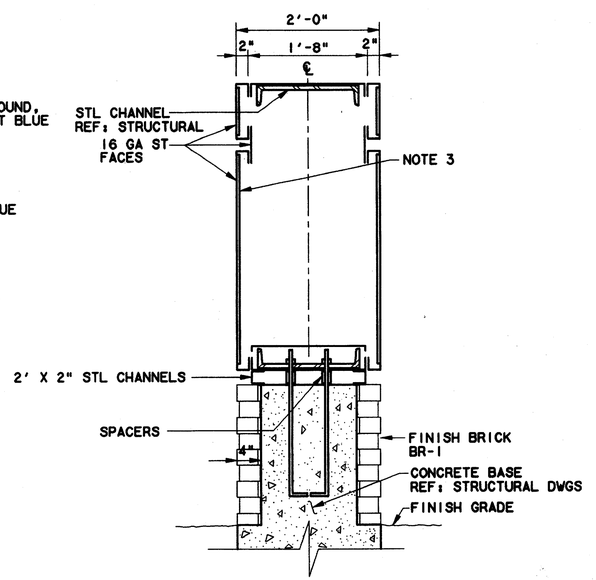

SIDE ELEVATION (3)
SCALE: 1"=1'-0"

FRONT ELEVATION (4)
SCALE: 1"=1'-0"

SECTION (5)
SCALE: 1"=1'-0"

Record (As-built) Certification

I hereby certify that this information, we certify that it conforms to the requirement of the contract in all respects except as otherwise indicated.

Contract Number: C-97000136
Contractor's Name: TRINITY CO
Officer of Firm Signature:
Date:
Officer of Firm Name (typed): TOM KADER
Title of Officer (typed): PRESIDENT

Seal of Professional Engineer of Construction Contractor, if required by regulation and state, thereby sealing record (as-built) drawings for inventory of as-built condition reflected hereon, must be placed below:

7-7-99

CONFORMED

CONTRACT SHEET No. 70 OF 95

REV	DATE	DESCRIPTION	BY	ENG	CHK	APP
0	8/14/97	ISSUED FOR CONSTRUCTION				

Lockwood, Andrews & Newnam, Inc.
A SUBSIDIARY OF LEO A DALY

WENDY LOPEZ & ASSOCIATES, INC.
ENGINEERING • SURVEYING • CONSTRUCTION SERVICES
1825 MARKET CENTER BLVD – SUITE 250
DALLAS, TEXAS 75207
(214) 741-7777

DART PROJECT

DART

CAES

SCALE	1"=1'-0"
DRAWN	K. DEAN
DESIGNED	N. INFANZON/K. DEAN
CHECKED	N. INFANZON/RON BOLTON
IN CHARGE	V. STEVENS
DATE	14 AUGUST 97

ADDISON
TRANSIT CENTER

SITE SIGNAGE
& GRAPHICS

CONTRACT	DWG No.	REV
C-97000136	AC9-0001	0

ORDER, k:\wlq0933\004\abtcborl.008, 1-7,9,12-29,31-62
no ref logical*, *no ref name*, *no ref levels*