$$$$DGN$SPECIFICATION$$$$$$$$$$
$$$$$SYTIME$$$$$$$
$$PRF$$
$$USERNAME$$
$$PRF ROT$$
$$PEN$$
$$FILE6$$
$$FILE7$$
$$FILE8$$
$$FILE9$$
$$FILE10$$
$FILE1$$
$FILE2$$
$FILE3$$
$FILE4$$
$FILE5$$

DWG NO. SC1-0008

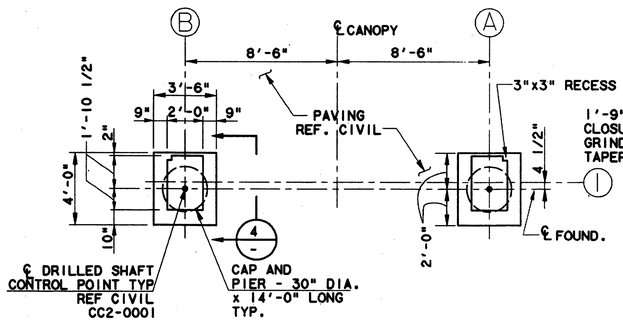

FOUNDATION PLAN 1/-

SCALE: 1/4"=1'-0"

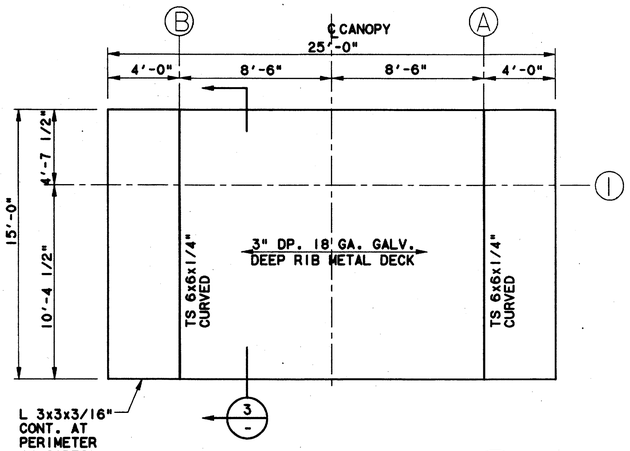

ROOF FRAMING PLAN 2/-

SCALE: 1/4"=1'-0"

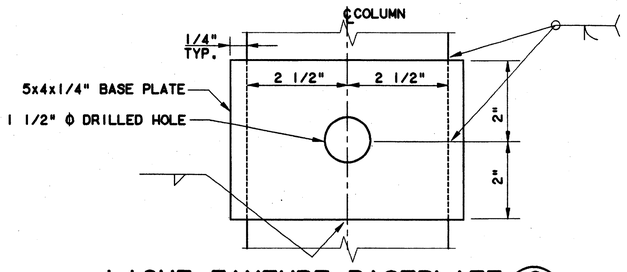

LIGHT FIXTURE BASEPLATE 6/-

SCALE: 1/4"=1'-0"

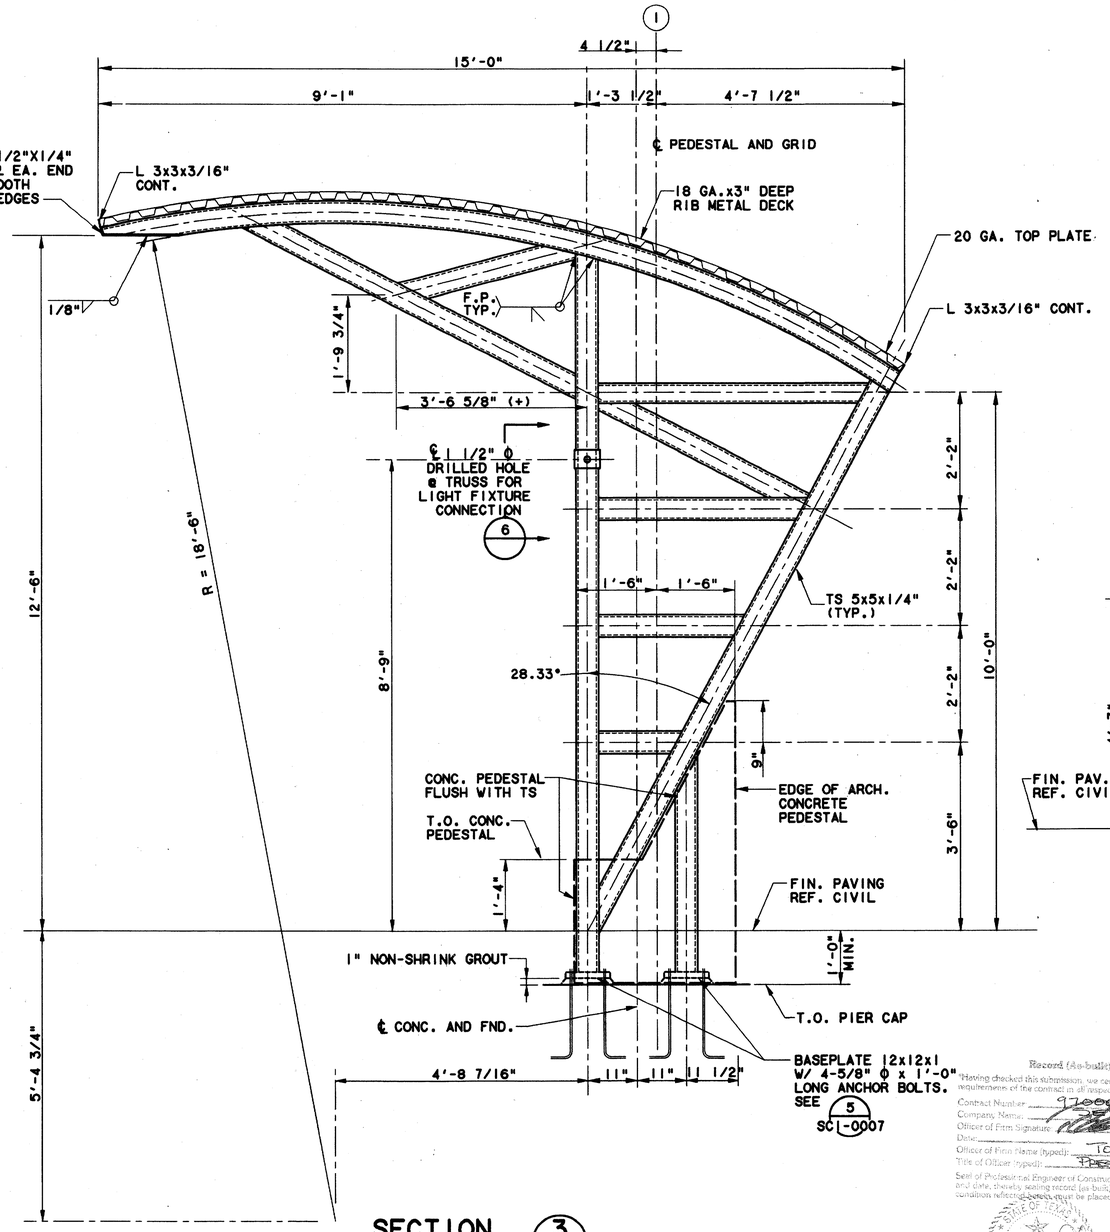

SECTION 3/-

SCALE: 3/4"=1'-0"

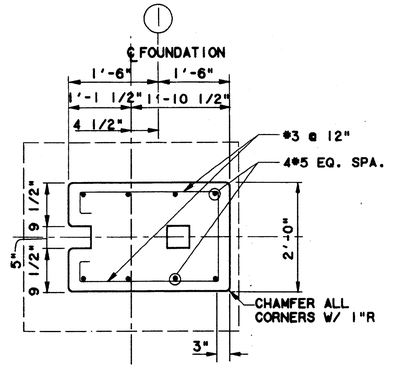

SECTION 5/-

SCALE: 3/4"=1'-0"

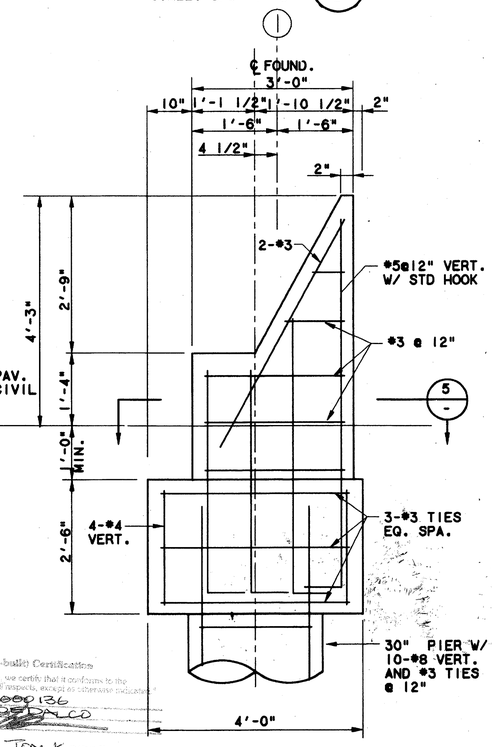

SECTION 4/-

SCALE: 3/4"=1'-0"

Record (As-built) Certification
"Having checked this submission, we certify that it conforms to the requirements of the contract in all respects, except as otherwise indicated."
Contract Number: 97000136
Company Name: [illegible] CO
Officer of Firm Signature: [signature]
Date: 7-7-97
Officer of Firm Name (typed): TOM KADER
Title of Officer (typed): PRESIDENT
Seal of Professional Engineer or Construction Contractor, including signature and date, thereby sealing record (as-built) drawings for accuracy of as-built conditions reflected, must be placed below.

KEITH J. BURKHOLDER 58163 REGISTERED PROFESSIONAL ENGINEER 7-7-97

CONFORMED

CONTRACT SHEET No. 79 OF 95

REV	DATE	DESCRIPTION	BY	ENG	CHK	APP
△						
△						
△						
△						
△						
△						

REV	DATE	DESCRIPTION	BY	ENG	CHK	APP
△						
△						
△						
△						
△						
△						

Lockwood, Andrews & Newnam, Inc.
A SUBSIDIARY OF LEO A DALY

WENDY LOPEZ & ASSOCIATES, INC.
ENGINEERING • SURVEYING • CONSTRUCTION SERVICES
1825 MARKET CENTER BLVD - SUITE 530
DALLAS, TEXAS 75207
(214) 741-7777

DART PROJECT

DART

CAES

SCALE	AS NOTED
DRAWN	P.R. MASON
DESIGNED	V. BAND
CHECKED	K. BURKHOLDER
IN CHARGE	V. STEVENS
DATE	14 AUGUST 97

ADDISON TRANSIT CENTER

CANOPY FOUNDATION AND FRAMING PLAN

CONTRACT C-97000136 | DWG No. SC1-0008 | REV 0