


BENCH MARK: TOP OF BOLT IN NW CORNER OF BASE PLATE FOR PARKING LOT LIGHT STANDARD
 143' EAST OF CL TOLLWAY STA 609+266
 ELEV. 630.76

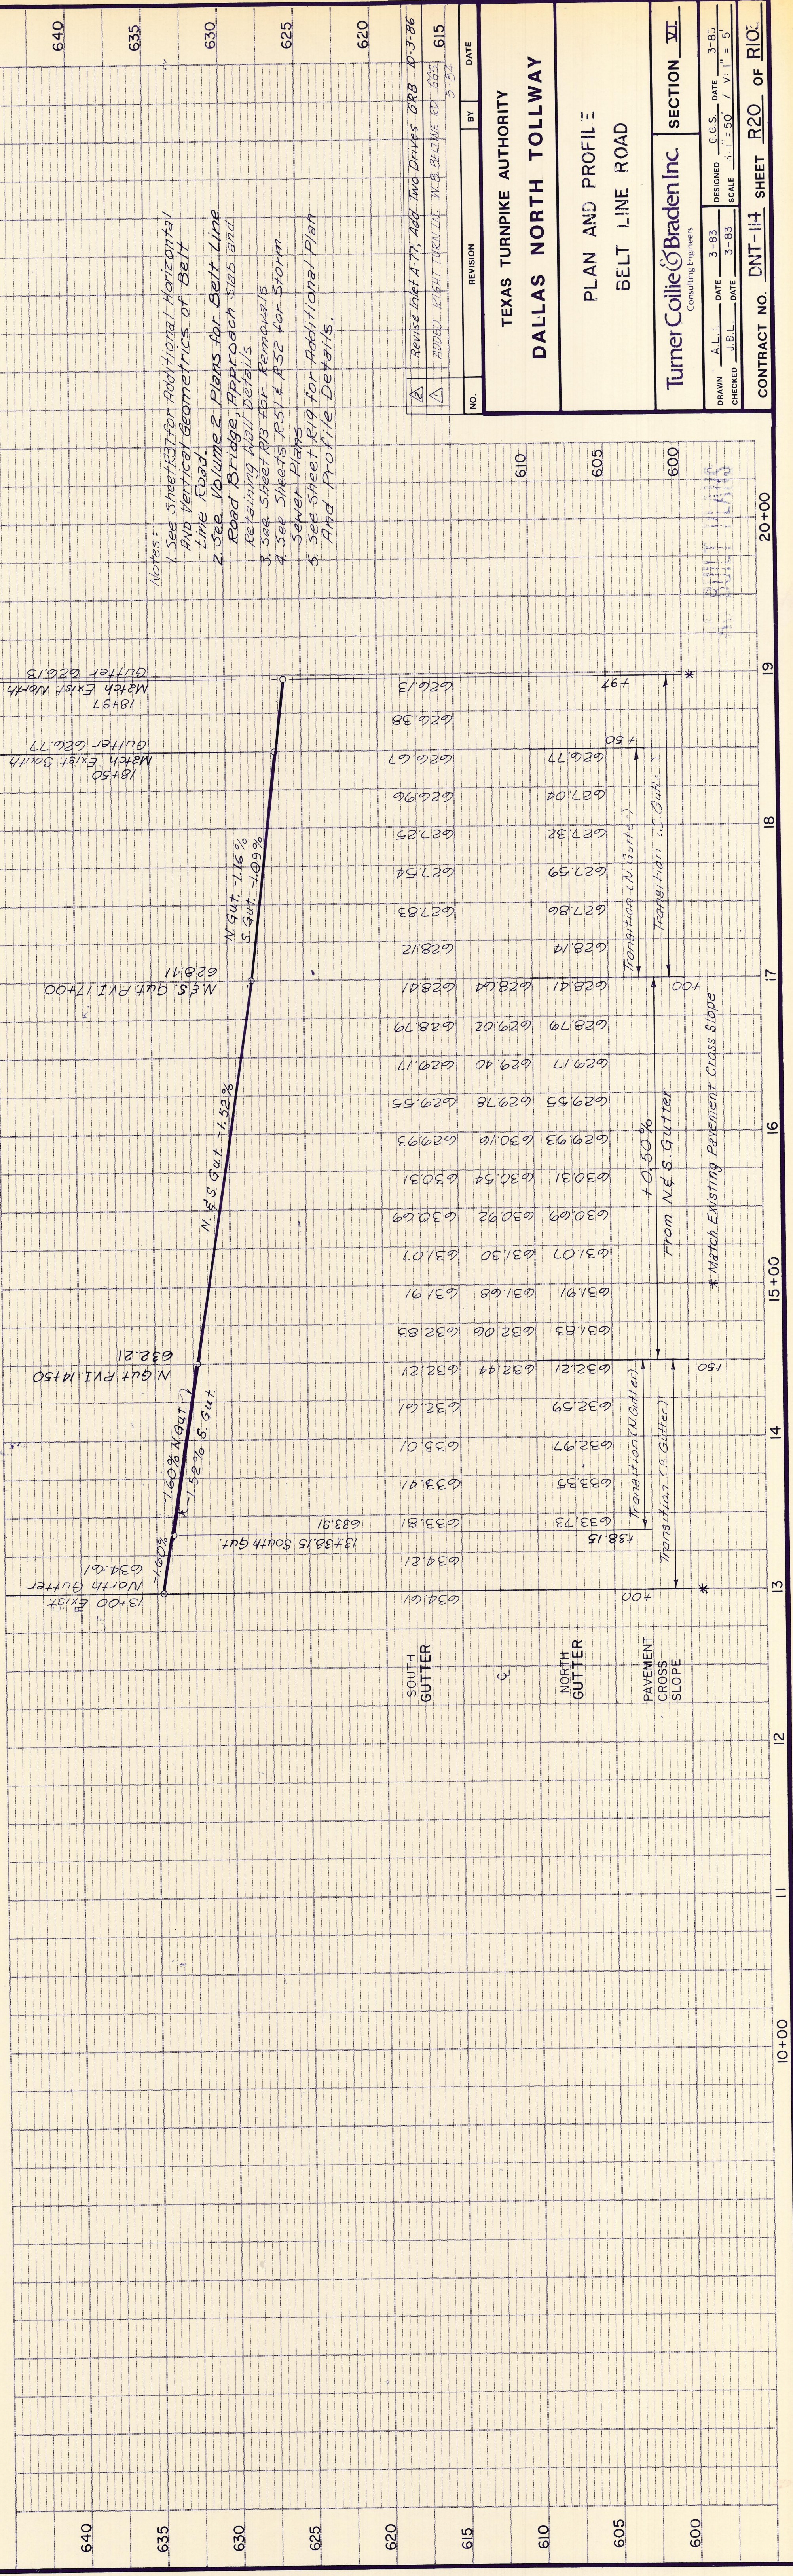

- Notes:
1. See Sheet R37 for Additional Horizontal and Vertical Geometrics of Belt Line Road.
 2. See Volume 2 Plans for Belt Line Road Bridge, Approach Slab and Retaining Wall Details.
 3. See Sheet R13 for Forming Slab Sewer Plans.
 4. See Sheets R51 & R52 for Storm and Profile Details.

NO.	REVISION	BY	DATE
1	Revise Inlet A-77, Add Two Drives BRB D-3-86		
2	Added Belt Trench Detail N.B. Beltline Rd		

TEXAS TURNPIKE AUTHORITY
DALLAS NORTH TOLLWAY
 PLAN AND PROFILE
 BELT LINE ROAD
 Turner Collier & Braden Inc.
 Consulting Engineers
 SECTION VI

DRAWN: A.L.L. DATE: 3-83 DESIGNED: G.S.S. DATE: 3-83
 CHECKED: J.E.L. DATE: 3-83 SCALE: 1" = 50' / V.P. = 5'
 CONTRACT NO. DNT-114 SHEET R20 of R10.