SPECTRUM I LIMITED — REGISTRY DALLAS ASSOCIATES — MEPC QUORUM PROPERTIES, INC.

NOTES

1. See Sheet R24 for N.B. Dallas Pkwy. profile.
2. " " R26 for S.B. Dallas Pkwy. profile.
3. " " R29 for Ramp BL-N profile.
4. " " R29 for Ramp N-BL profile.
5. " " R38 for Ramp BL-N details. & Nose Sta.
6. " " R39 for Ramp N-BL details. & Nose Sta.
7. " " R6 for Additional Horizontal Geometrics
8. " " R14 for Removals
9. " " R7&8 for Typical Roadway Sections
10. " " R53 for Storm Sewer Plan
11. See Volume 2 Plans for Retaining Wall Details

LEGEND

- (R1) Horizontal Curve Number
- A71 Inlet Designation
- Existing Light Pole
- Existing Power/Telephone Pole
- Existing Tree
- Existing Fence
- Existing Building
- Storm Sewer Manhole

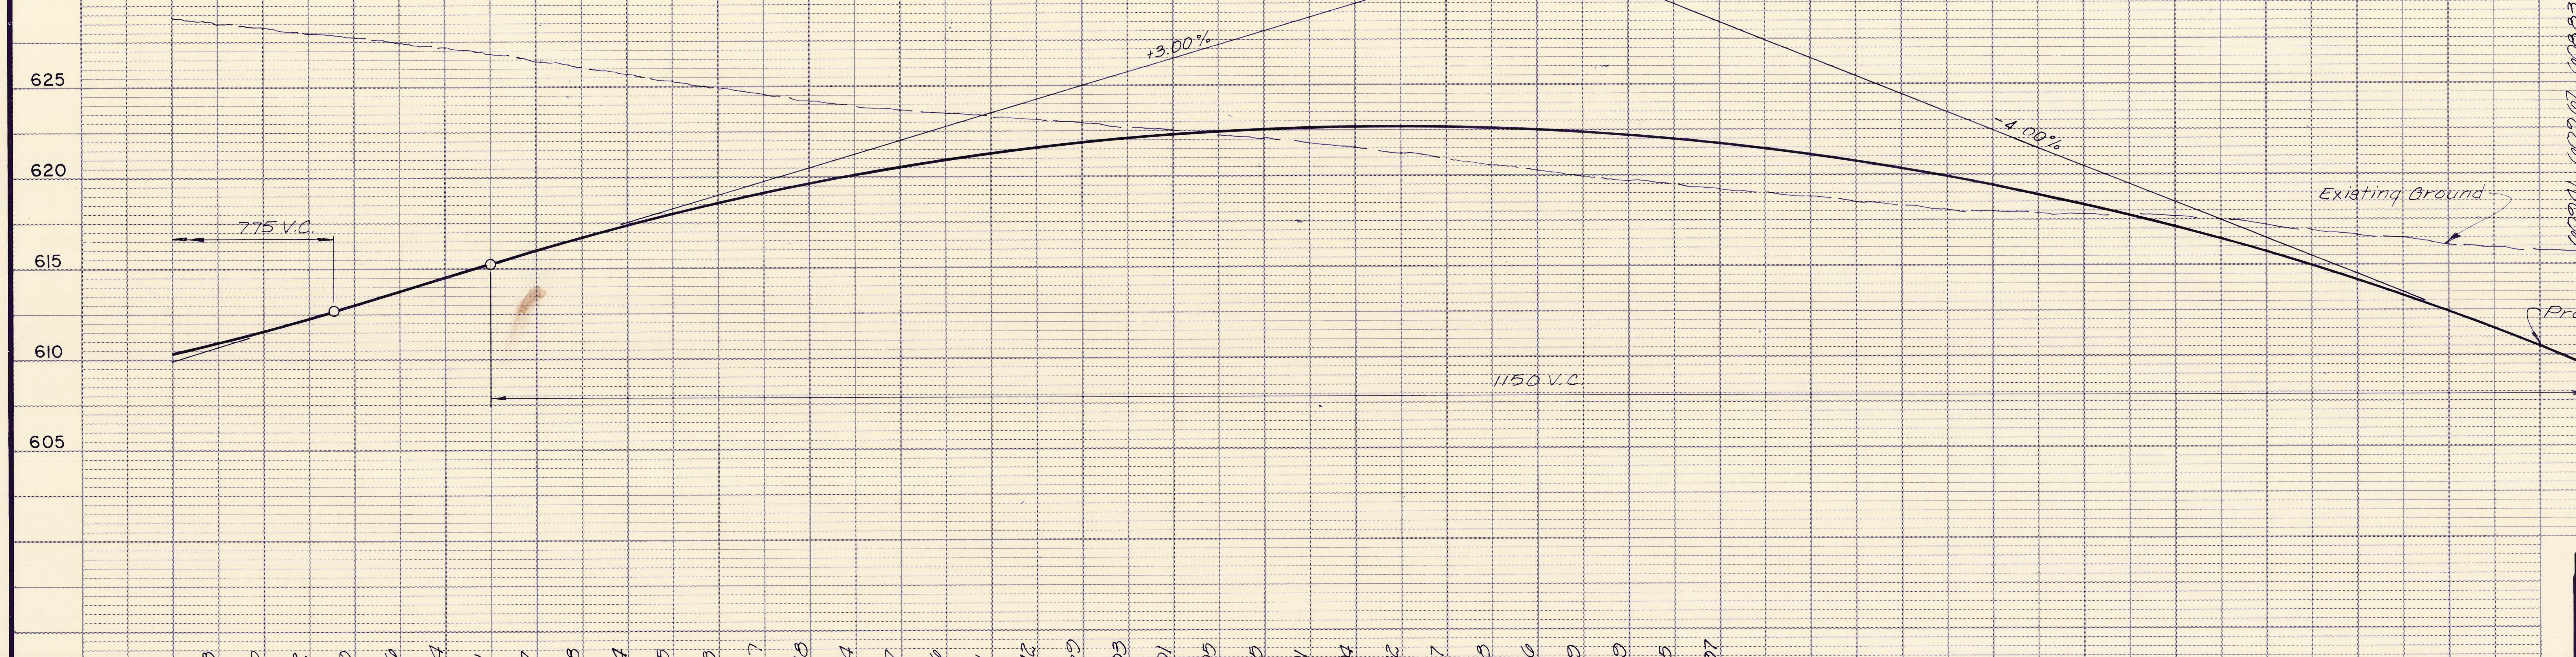

Station	40' LEFT	40' RIGHT	52' RIGHT	PROFILE GRADE
13	610.11	610.35		610.23
	610.83	610.81		610.82
	611.60	611.34		611.47
	612.42	611.91		612.17
14	613.29	612.53		612.91
	614.16	613.16		613.66
	615.04	613.78		614.41
	615.91	614.41		615.16
615	616.77	615.02		615.89
	617.58	615.58		616.58
	618.24	616.24		617.24
	618.85	616.86		617.86
16	619.43	617.44		618.43
	619.97	617.98		618.98
	620.48	618.48		619.48
	620.94	618.94		619.94
17	621.37	619.37		620.37
	621.70	619.76		620.76
	622.11	620.11		621.11
	622.42	620.42		621.42
18	622.69	620.70		621.70
	622.93	620.93		621.93
	623.01	621.13		622.13
	623.05	621.29		622.29
19	623.05	621.41		622.41
	623.01	621.60		622.50
	622.94	621.76		622.54
	622.82	621.87		622.55
620	622.67	621.94		622.52
	622.48			622.45
	622.26			622.35
	621.99			622.20
21	621.69			622.02
	621.35			621.80
	620.97			621.54
				621.25
22				620.91
				620.54
				620.13
				619.68
23				619.20
				618.67
				618.11
				617.51
24				616.87
				616.19
				615.48
			613.96	614.73
625			613.34	613.93
			612.69	613.11
			611.99	612.24
			611.25	611.33
26			610.48	610.39
	608.83		609.67	609.41
	607.71		608.84	608.41
	606.60		608.01	607.41
	605.48		607.18	606.41

AS BUILT PLANS

NO.	REVISION	BY	DATE
27			

TEXAS TURNPIKE AUTHORITY

DALLAS NORTH TOLLWAY

PLAN AND PROFILE

STA. 613+00 TO STA. 627+00

Turner Collie & Braden Inc. Consulting Engineers — SECTION VI

DRAWN T.K.L. DATE 3-83 — DESIGNED G.G.S. DATE 3-83
CHECKED J.B.L. DATE 3-83 — SCALE H: 1" = 50' / V: 1" = 5'

CONTRACT NO. DNT-114 SHEET R21 OF R103