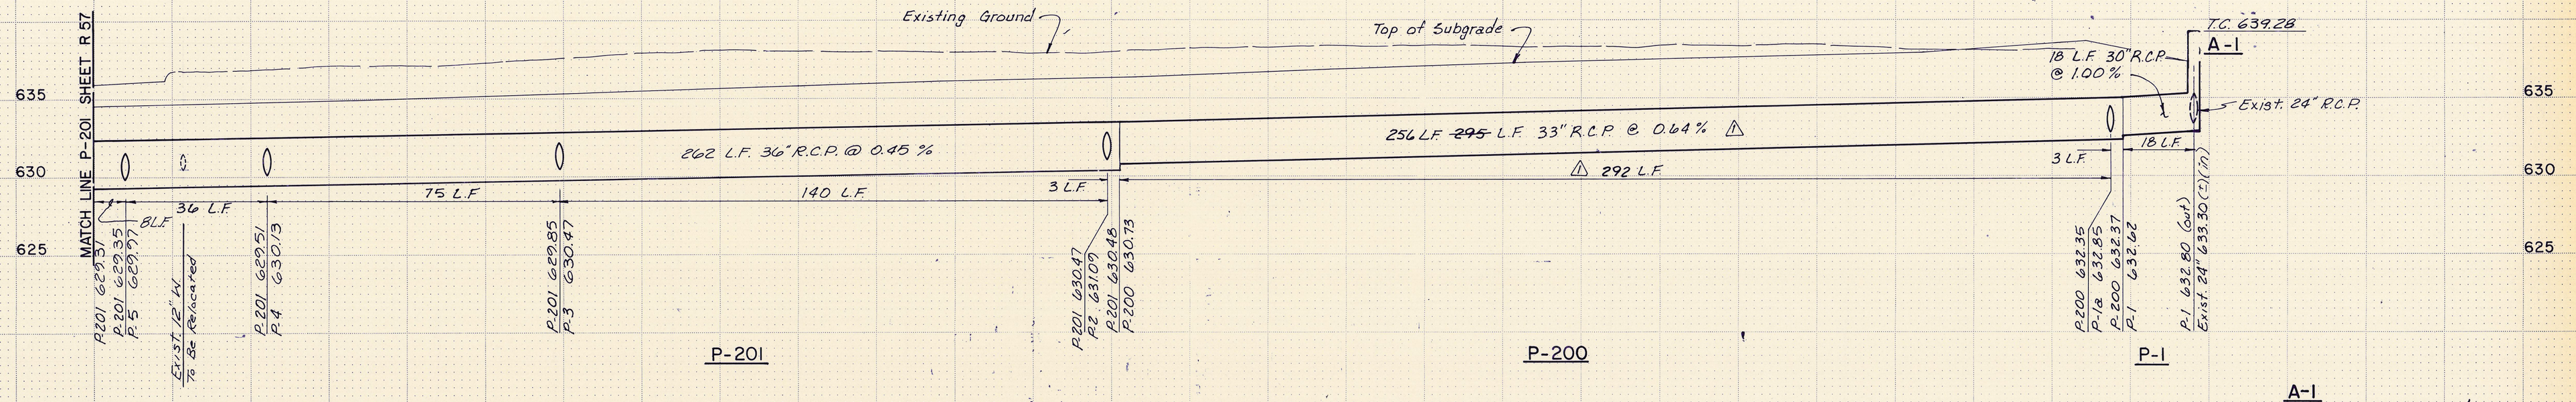

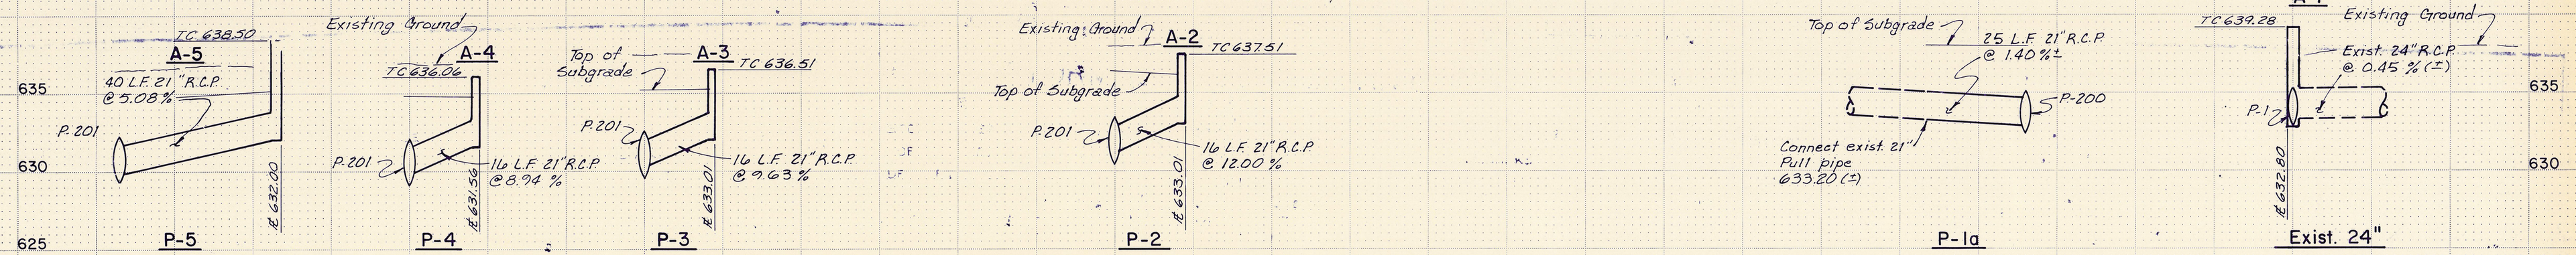

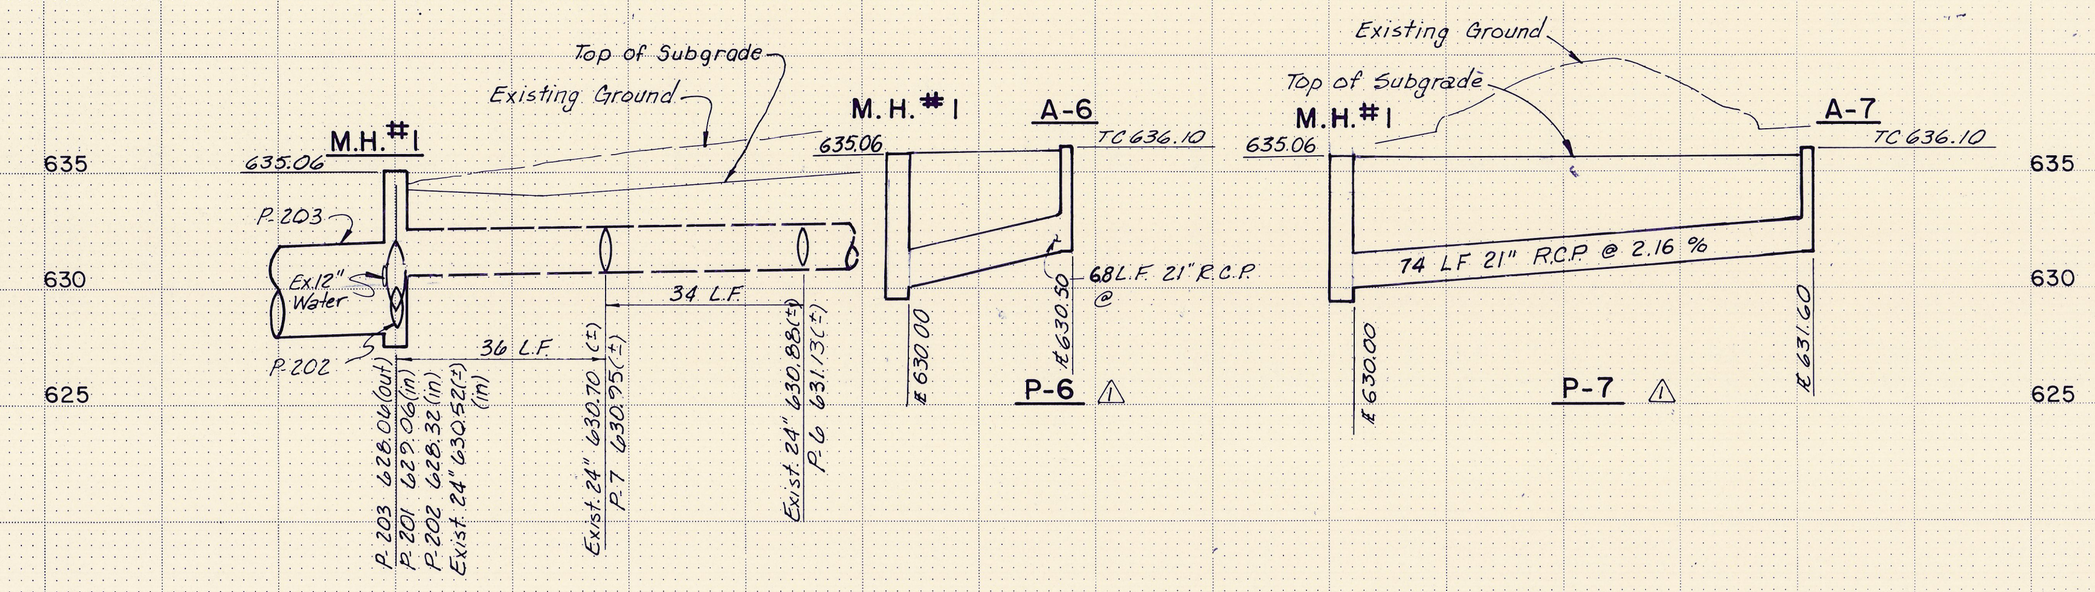

Exist. 24"

Note: 1. All R.C.P. to be Class III unless noted.
2. See sheet R50 for horizontal location of pipes.

P-1	M.H. #1
P-1a	
P-2	
P-3	
P-4	
P-5	
P-6	
P-7	
P-200	
P-201	

AS BUILT PLANS

NO.	REVISION	BY	DATE
⚠	As Built	C.B.	

TEXAS TURNPIKE AUTHORITY
DALLAS NORTH TOLLWAY

STORM SEWER PROFILE

Turner Collie & Braden Inc. | SECTION VI

MADE J.B.L. DATE 7-83 | TRACED J.B.L. DATE 7-83
CHECKED G.G.S. DATE 7-83 | SCALE H: 1" = 20' / V: 1" = 5'

CONTRACT NO. DNT-114 SHEET R56 OF R103