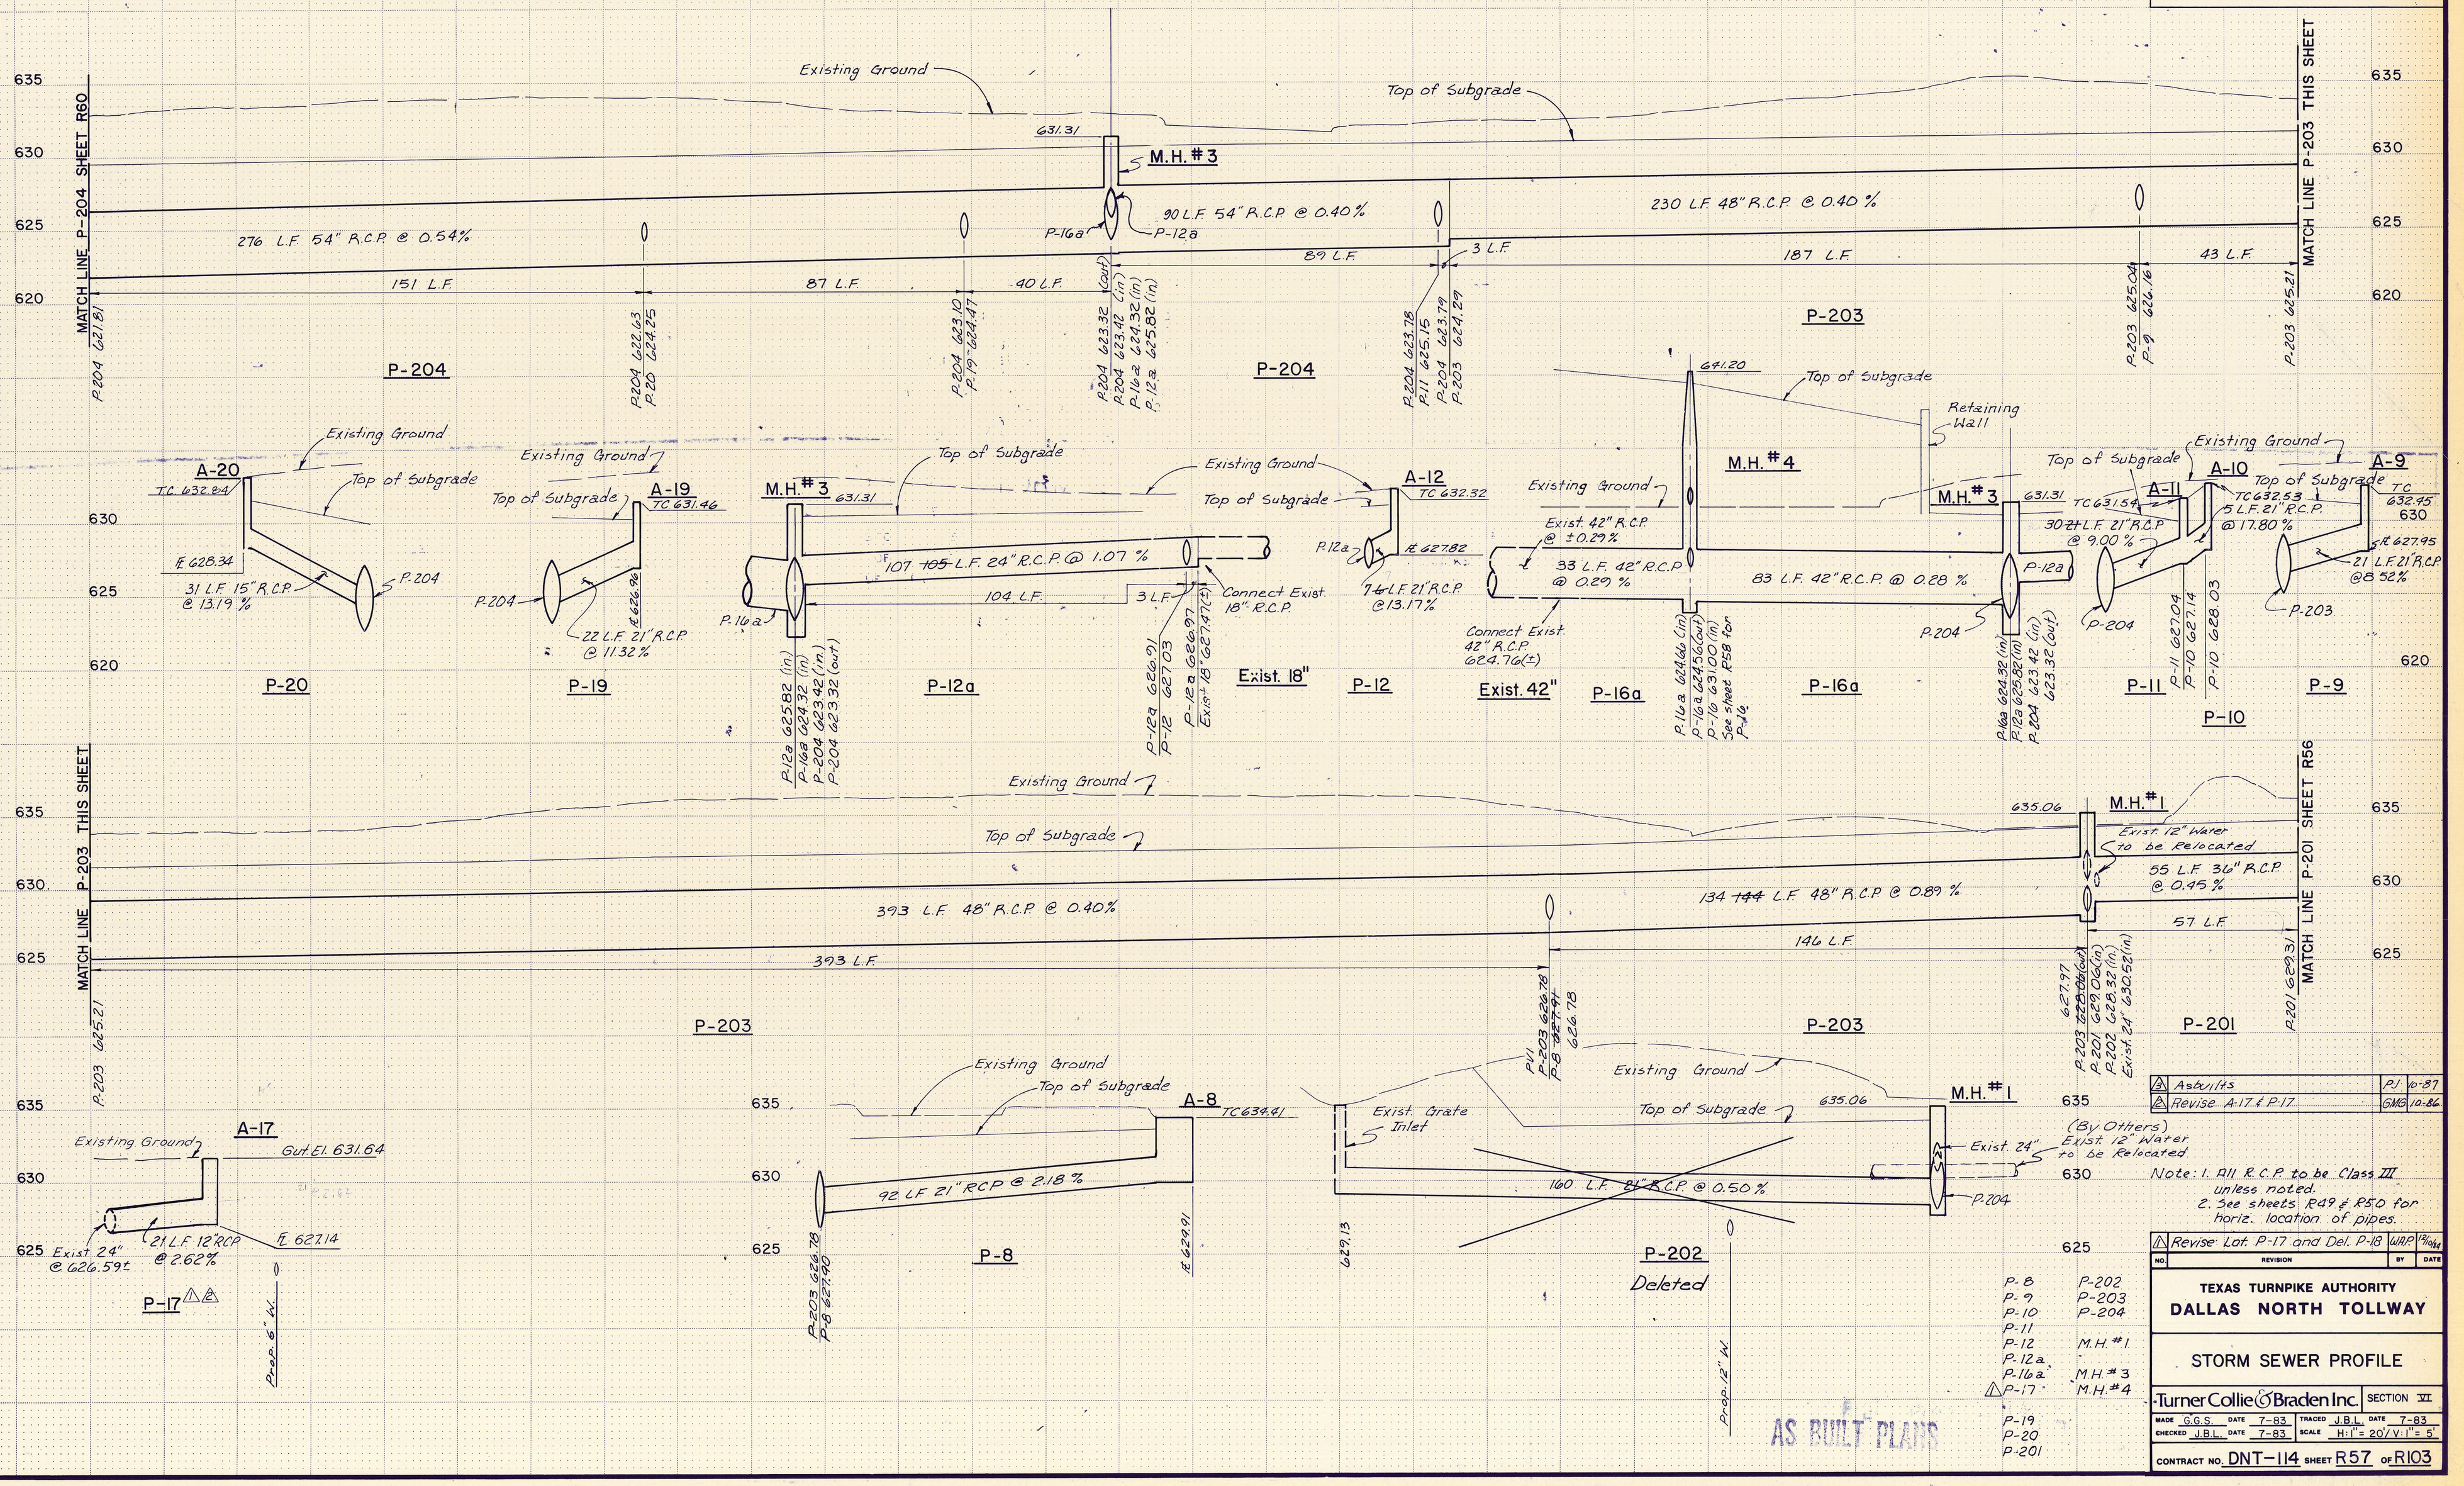

2	As-builts	PJ	10-87
1	Revise A-17 & P-17	GMG	10-86

Note: 1. All R.C.P. to be Class III unless noted.
2. See sheets R49 & R50 for horiz. location of pipes.

NO.	REVISION	BY	DATE
1	Revise Lot. P-17 and Del. P-18	WRP	7/1984

P-8	P-202
P-9	P-203
P-10	P-204
P-11	
P-12	M.H. #1
P-12a	
P-16a	M.H. #3
P-17	M.H. #4
P-19	
P-20	
P-201	

TEXAS TURNPIKE AUTHORITY
DALLAS NORTH TOLLWAY

STORM SEWER PROFILE

Turner Collie & Braden Inc. | SECTION VII

MADE G.G.S.	DATE 7-83	TRACED J.B.L.	DATE 7-83
CHECKED J.B.L.	DATE 7-83	SCALE H: 1"= 20' V: 1"= 5'	

CONTRACT NO. DNT-114 SHEET R57 OF R103

AS BUILT PLANS