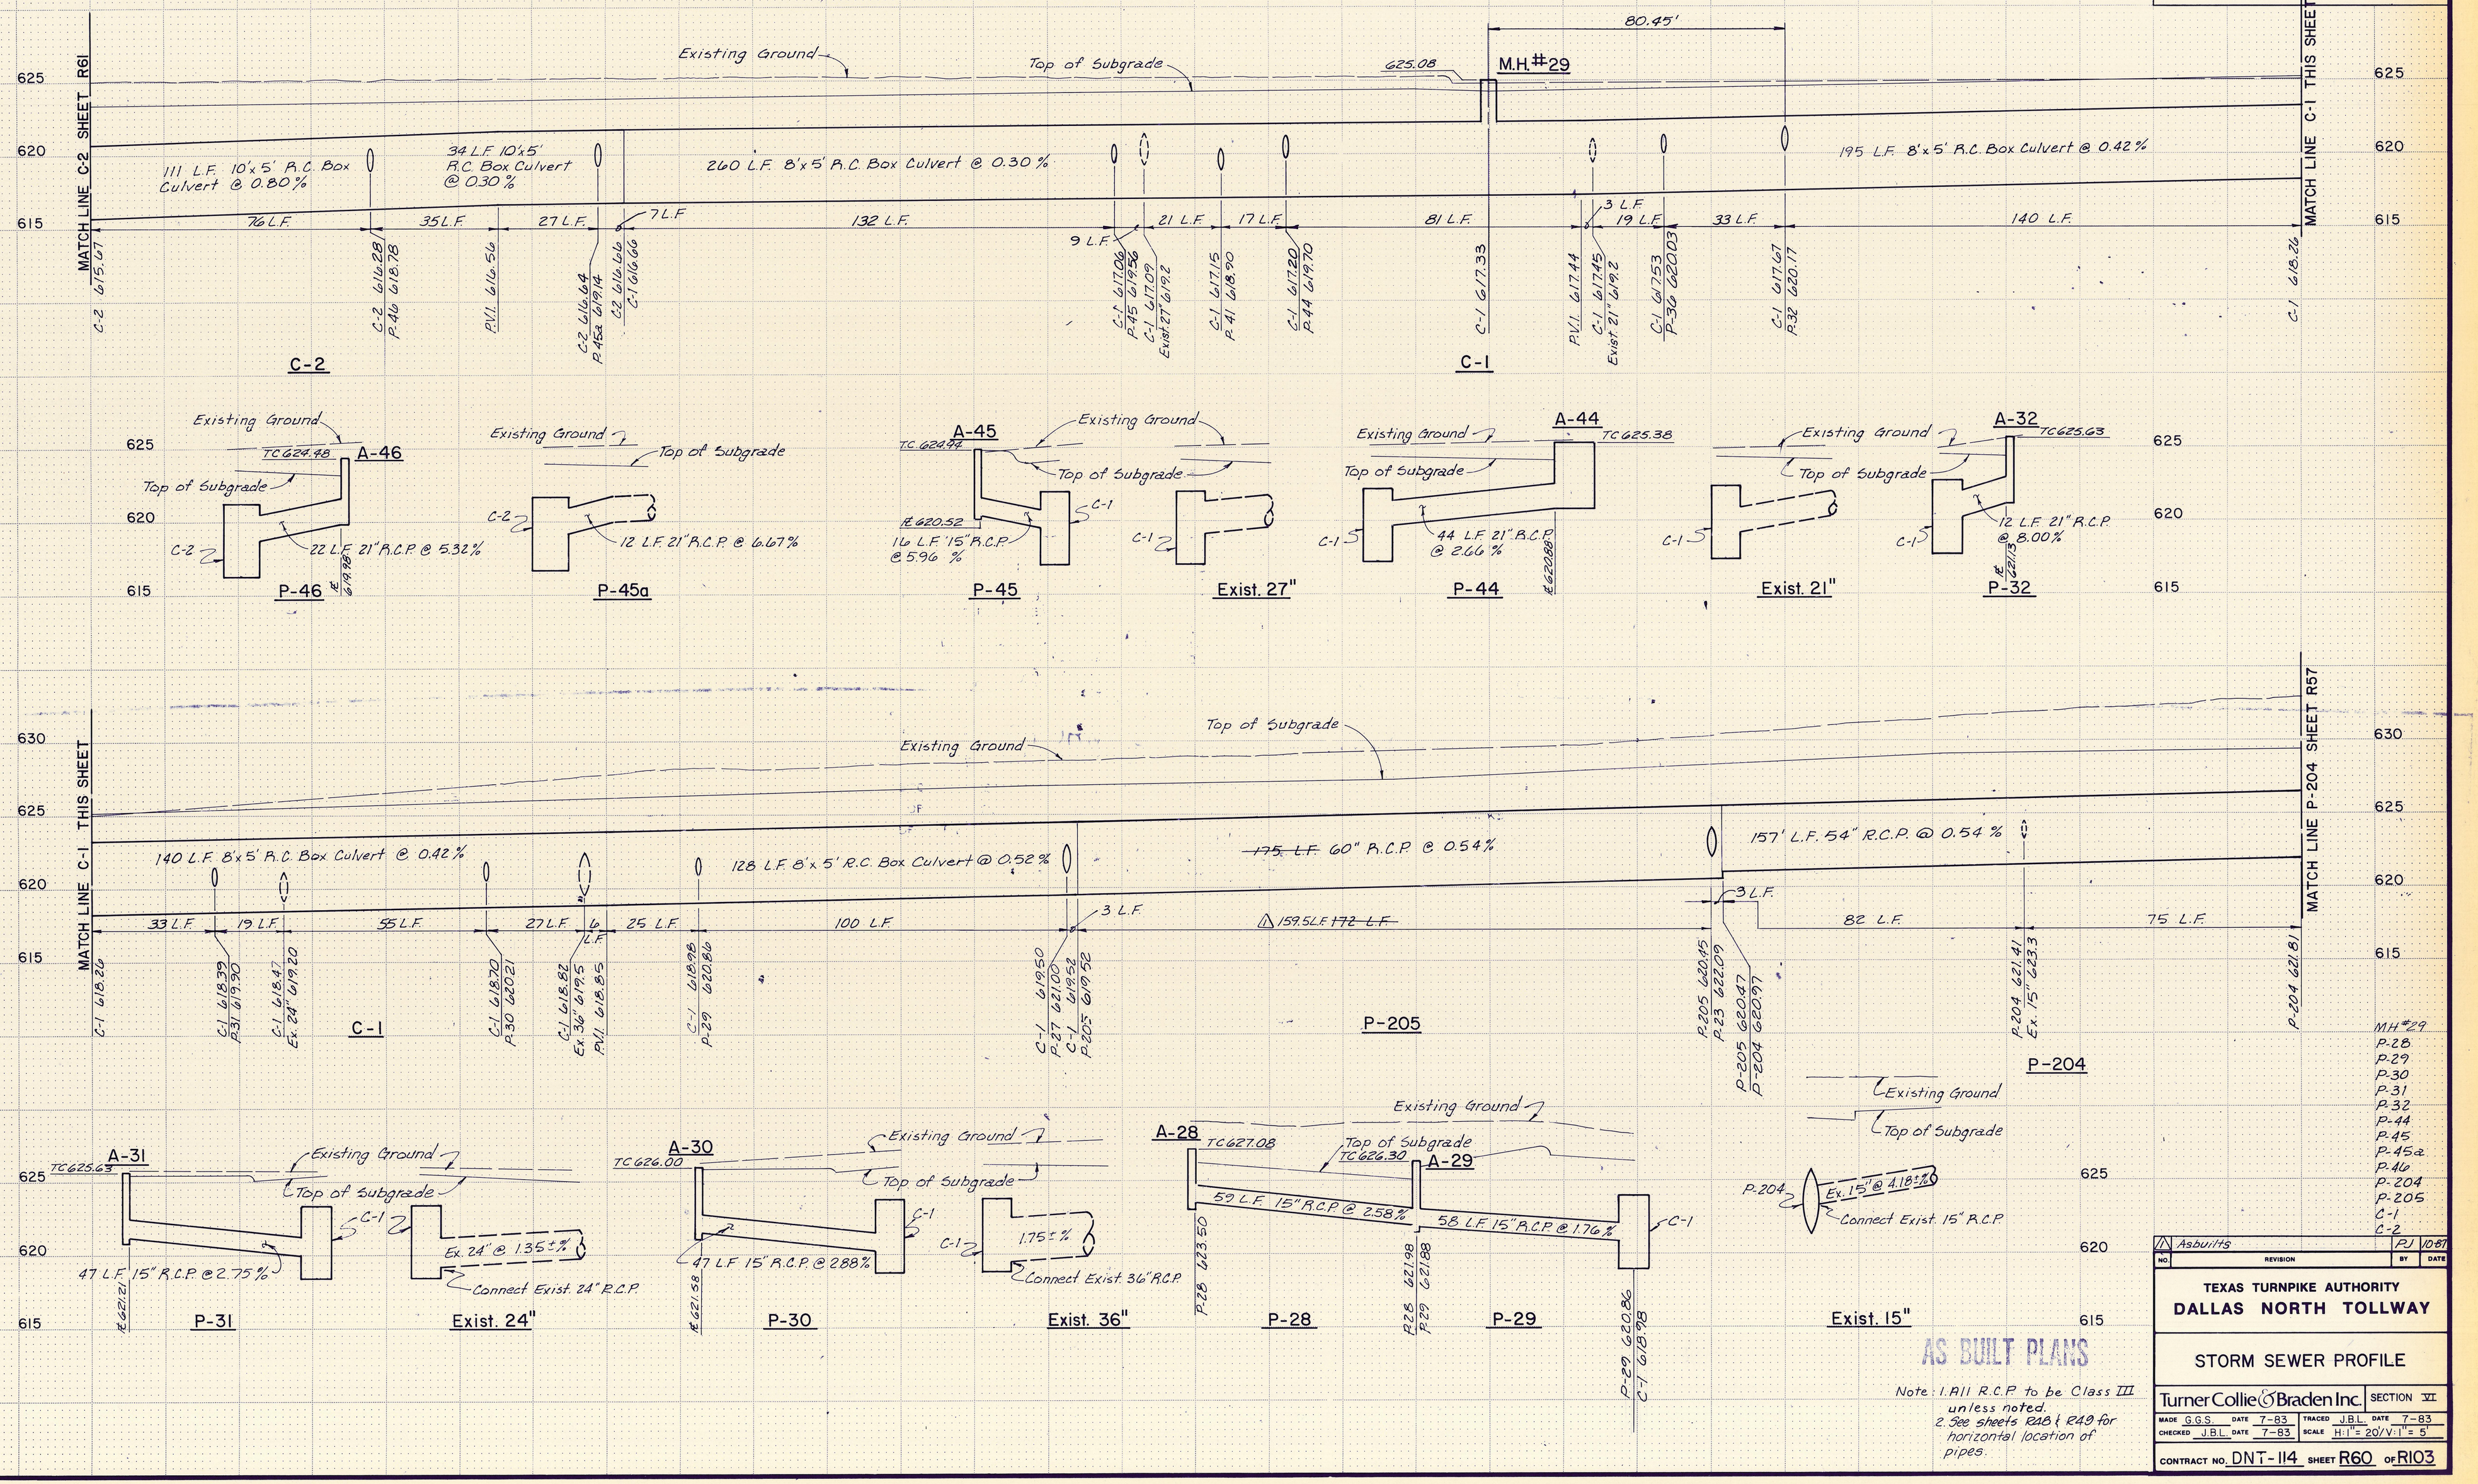

MH #29
P-28
P-29
P-30
P-31
P-32
P-44
P-45
P-45a
P-46
P-204
P-205
C-1
C-2

NO.	REVISION	BY	DATE
△	Asbuilts	PJ	10/87

TEXAS TURNPIKE AUTHORITY
DALLAS NORTH TOLLWAY

STORM SEWER PROFILE

Turner Collie & Braden Inc. | SECTION VI

MADE	G.G.S.	DATE 7-83	TRACED	J.B.L.	DATE 7-83
CHECKED	J.B.L.	DATE 7-83	SCALE	H: 1"= 20' / V: 1"= 5'	

CONTRACT NO. DNT-114 SHEET R60 OF R103

AS BUILT PLANS

Note: 1. All R.C.P. to be Class III unless noted.
2. See sheets R48 & R49 for horizontal location of pipes.