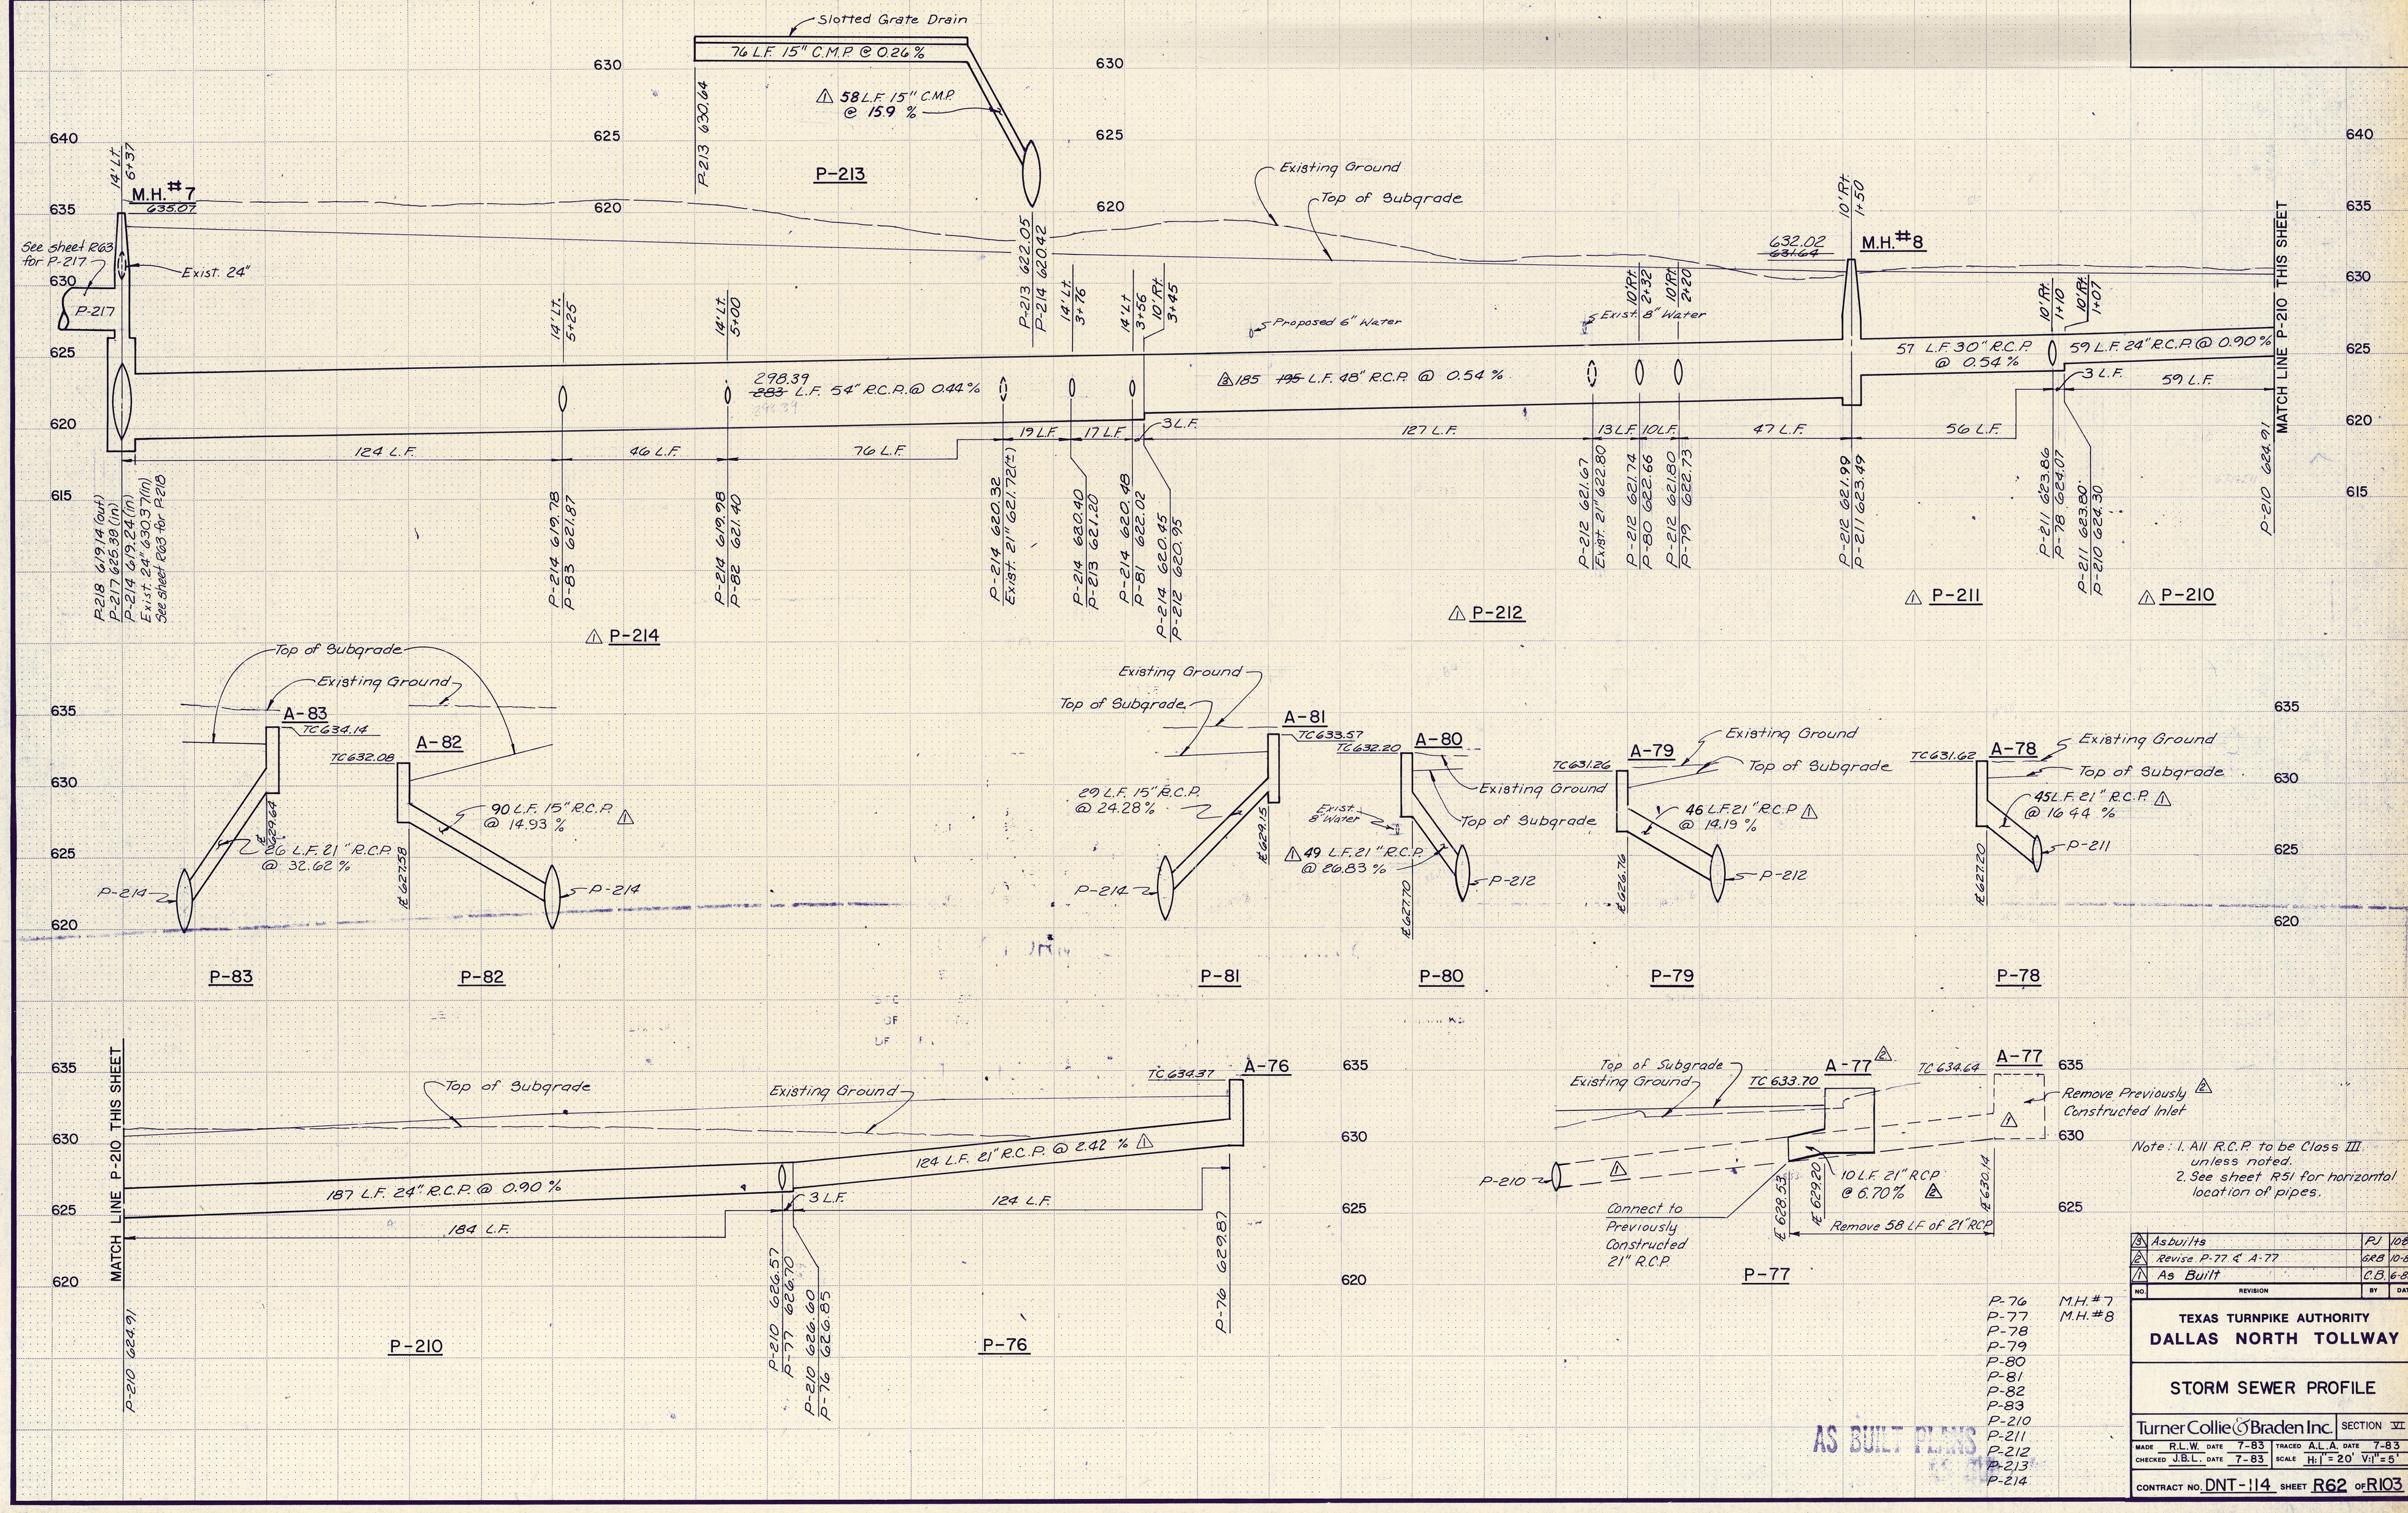

Note: 1. All R.C.P. to be Class III unless noted.
2. See sheet R51 for horizontal location of pipes.

NO.	REVISION	BY	DATE
3	As builts	PJ	10-87
2	Revise P-77 & A-77	GRB	10-86
1	As Built	C.B.	6-86

P-76 M.H. #7
P-77 M.H. #8
P-78
P-79
P-80
P-81
P-82
P-83
P-210
P-211
P-212
P-213
P-214

AS BUILT PLANS

TEXAS TURNPIKE AUTHORITY
DALLAS NORTH TOLLWAY

STORM SEWER PROFILE

Turner Collie & Braden Inc. SECTION VI

MADE R.L.W. DATE 7-83 TRACED A.L.A. DATE 7-83
CHECKED J.B.L. DATE 7-83 SCALE H: 1" = 20' V: 1" = 5'

CONTRACT NO. DNT-114 SHEET R62 OF R103