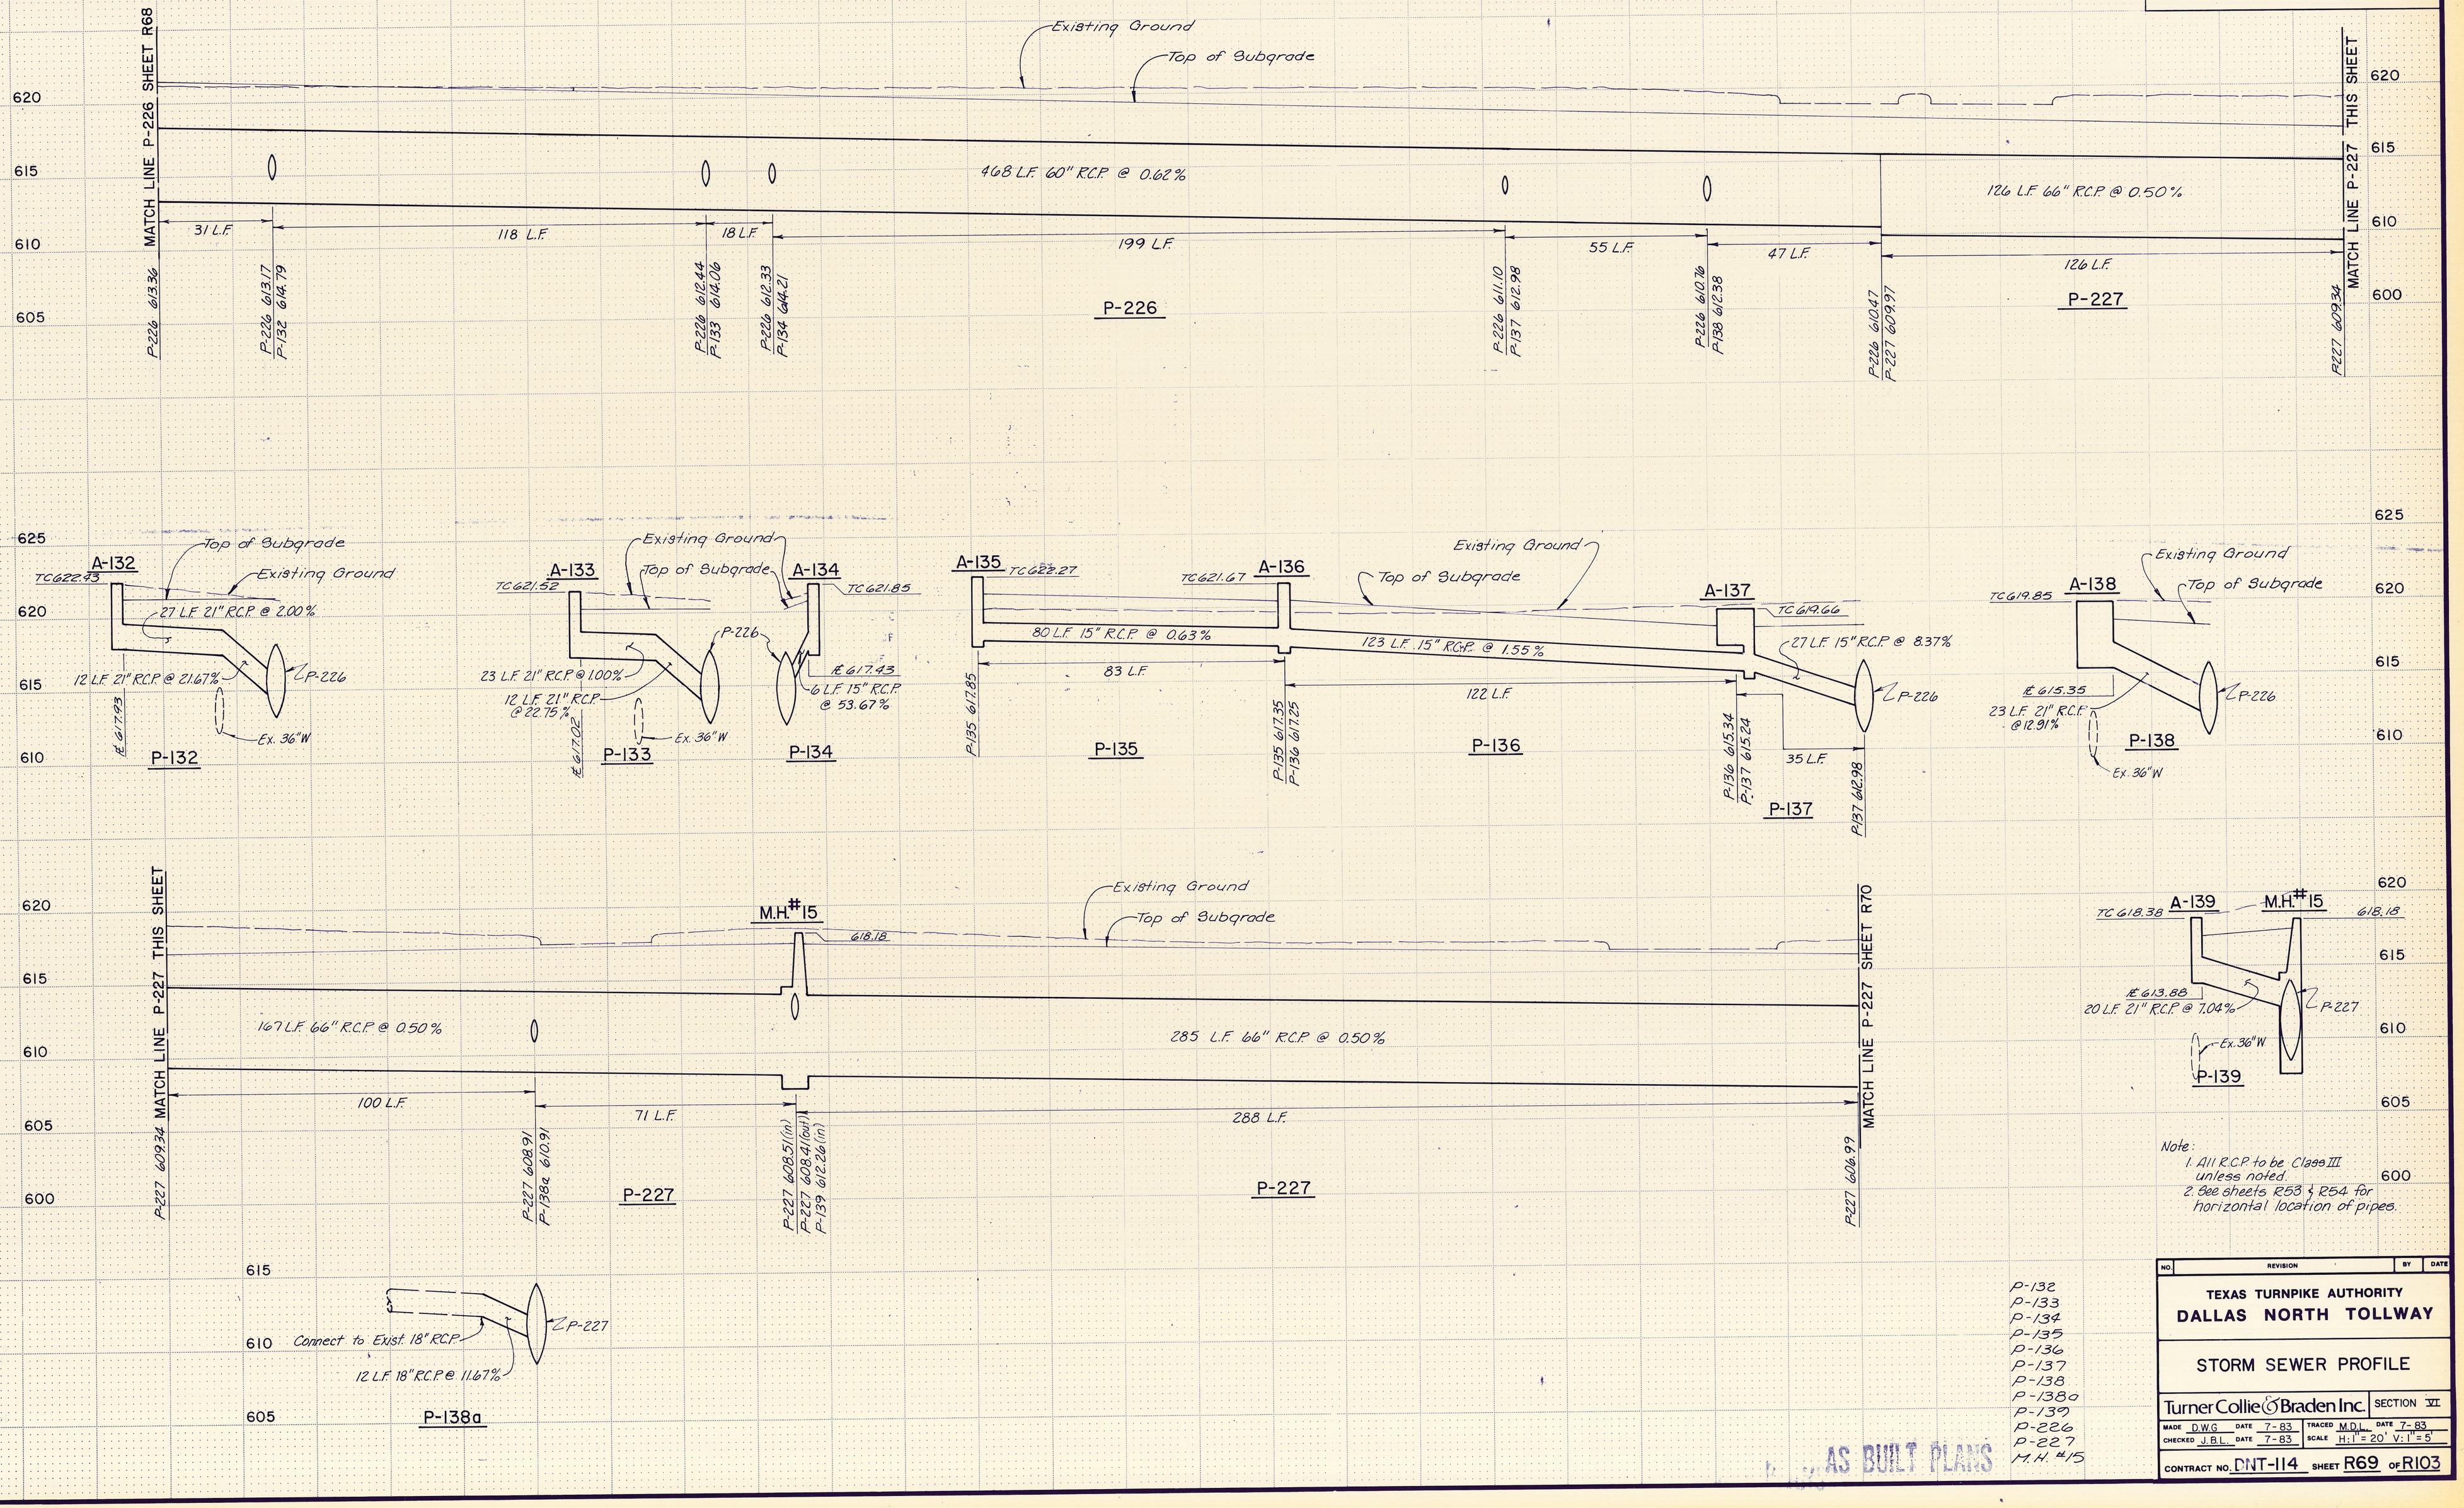

Note:
1. All R.C.P. to be Class III unless noted.
2. See sheets R53 & R54 for horizontal location of pipes.

P-132
P-133
P-134
P-135
P-136
P-137
P-138
P-139a
P-226
P-227
M.H. #15

AS BUILT PLANS

NO.	REVISION	BY	DATE

TEXAS TURNPIKE AUTHORITY
DALLAS NORTH TOLLWAY

STORM SEWER PROFILE

Turner Collie & Braden Inc. | SECTION VI

MADE D.W.G. DATE 7-83 | TRACED M.D.L. DATE 7-83
CHECKED J.B.L. DATE 7-83 | SCALE H: 1" = 20' V: 1" = 5'

CONTRACT NO. DNT-114 SHEET R69 OF R103