
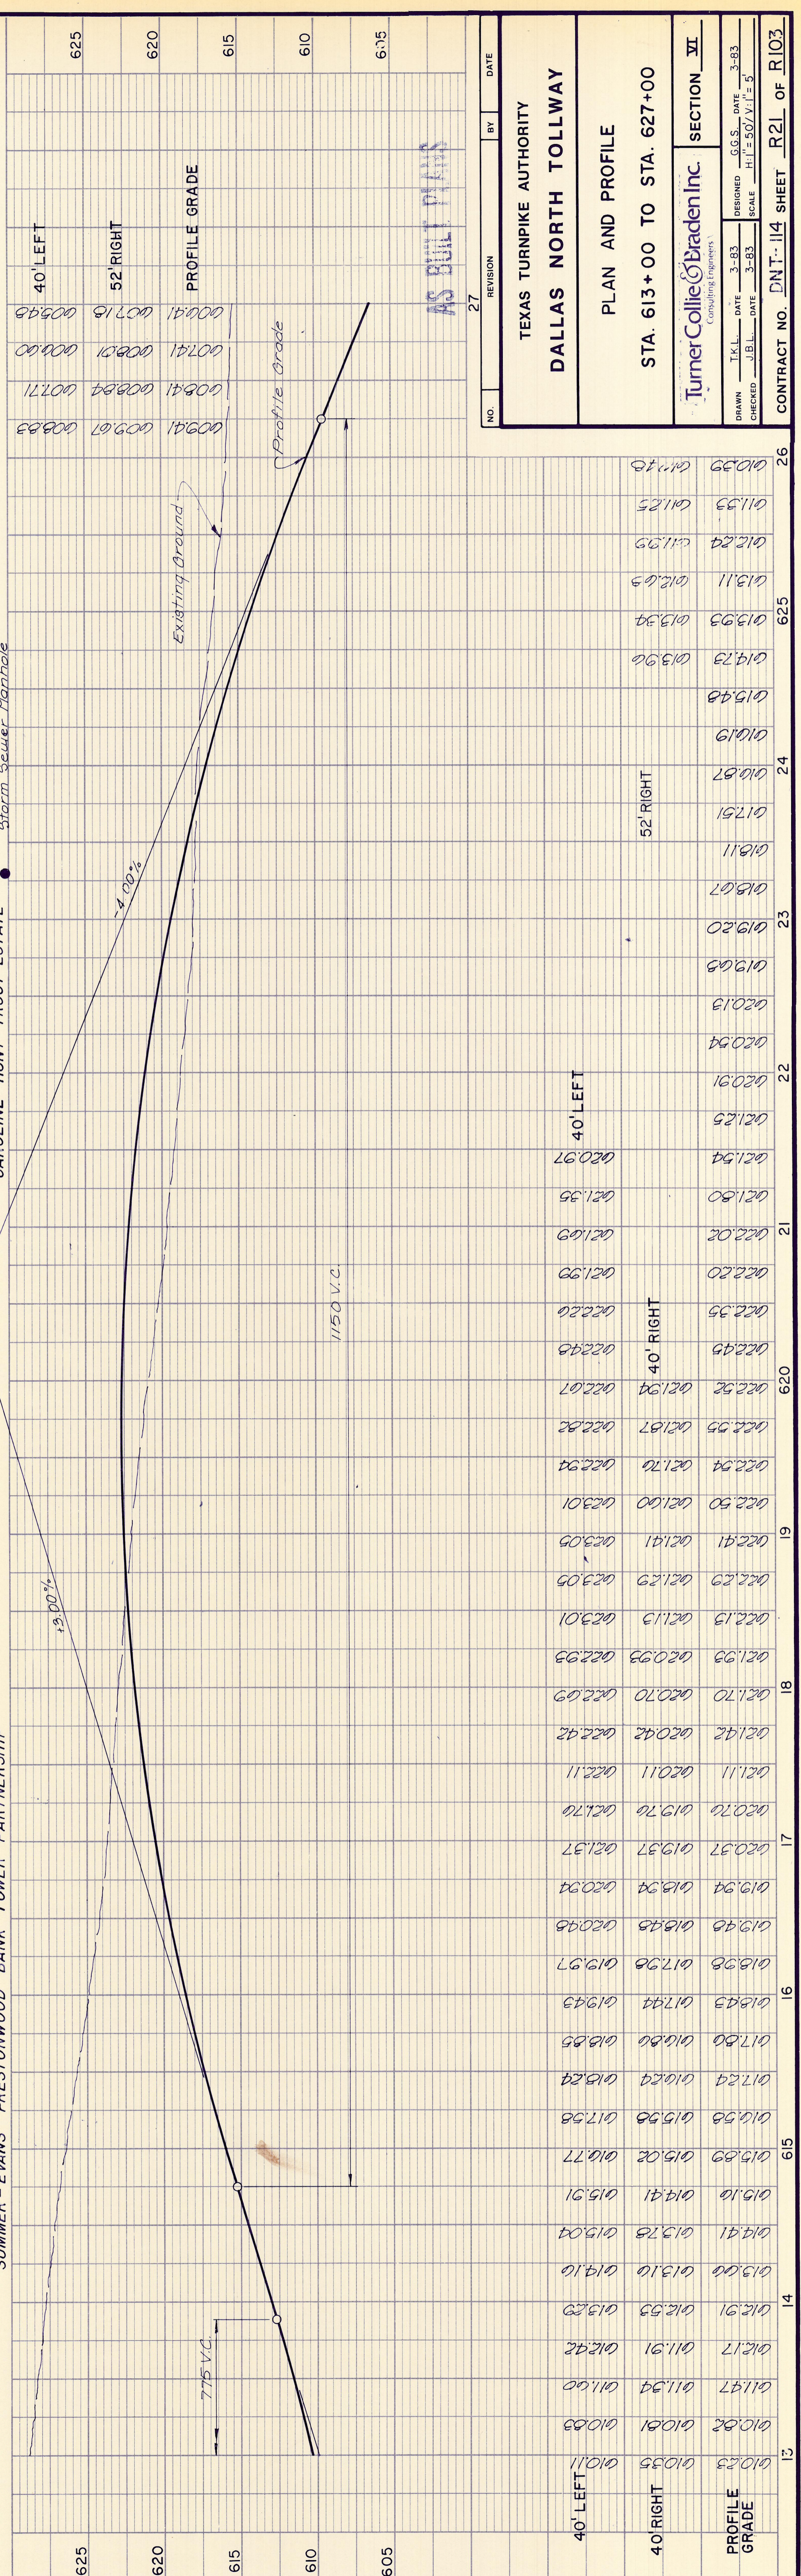


SPECTRUM I LIMITED

NOTES

- See Sheet R24 for N.B. Dallas Pkwy. profile.
- See Sheet R26 for S.B. Dallas Pkwy. profile.
- See Sheet R29 for Ramp BL-N profile.
- See Sheet R33 for Ramp BL-N details. Use Sta. 613+00 for details.
- See Sheet R39 for Ramp N-BL details. Use Sta. 613+00 for details.
- See Volume 2 Plans for Retaining Wall Details

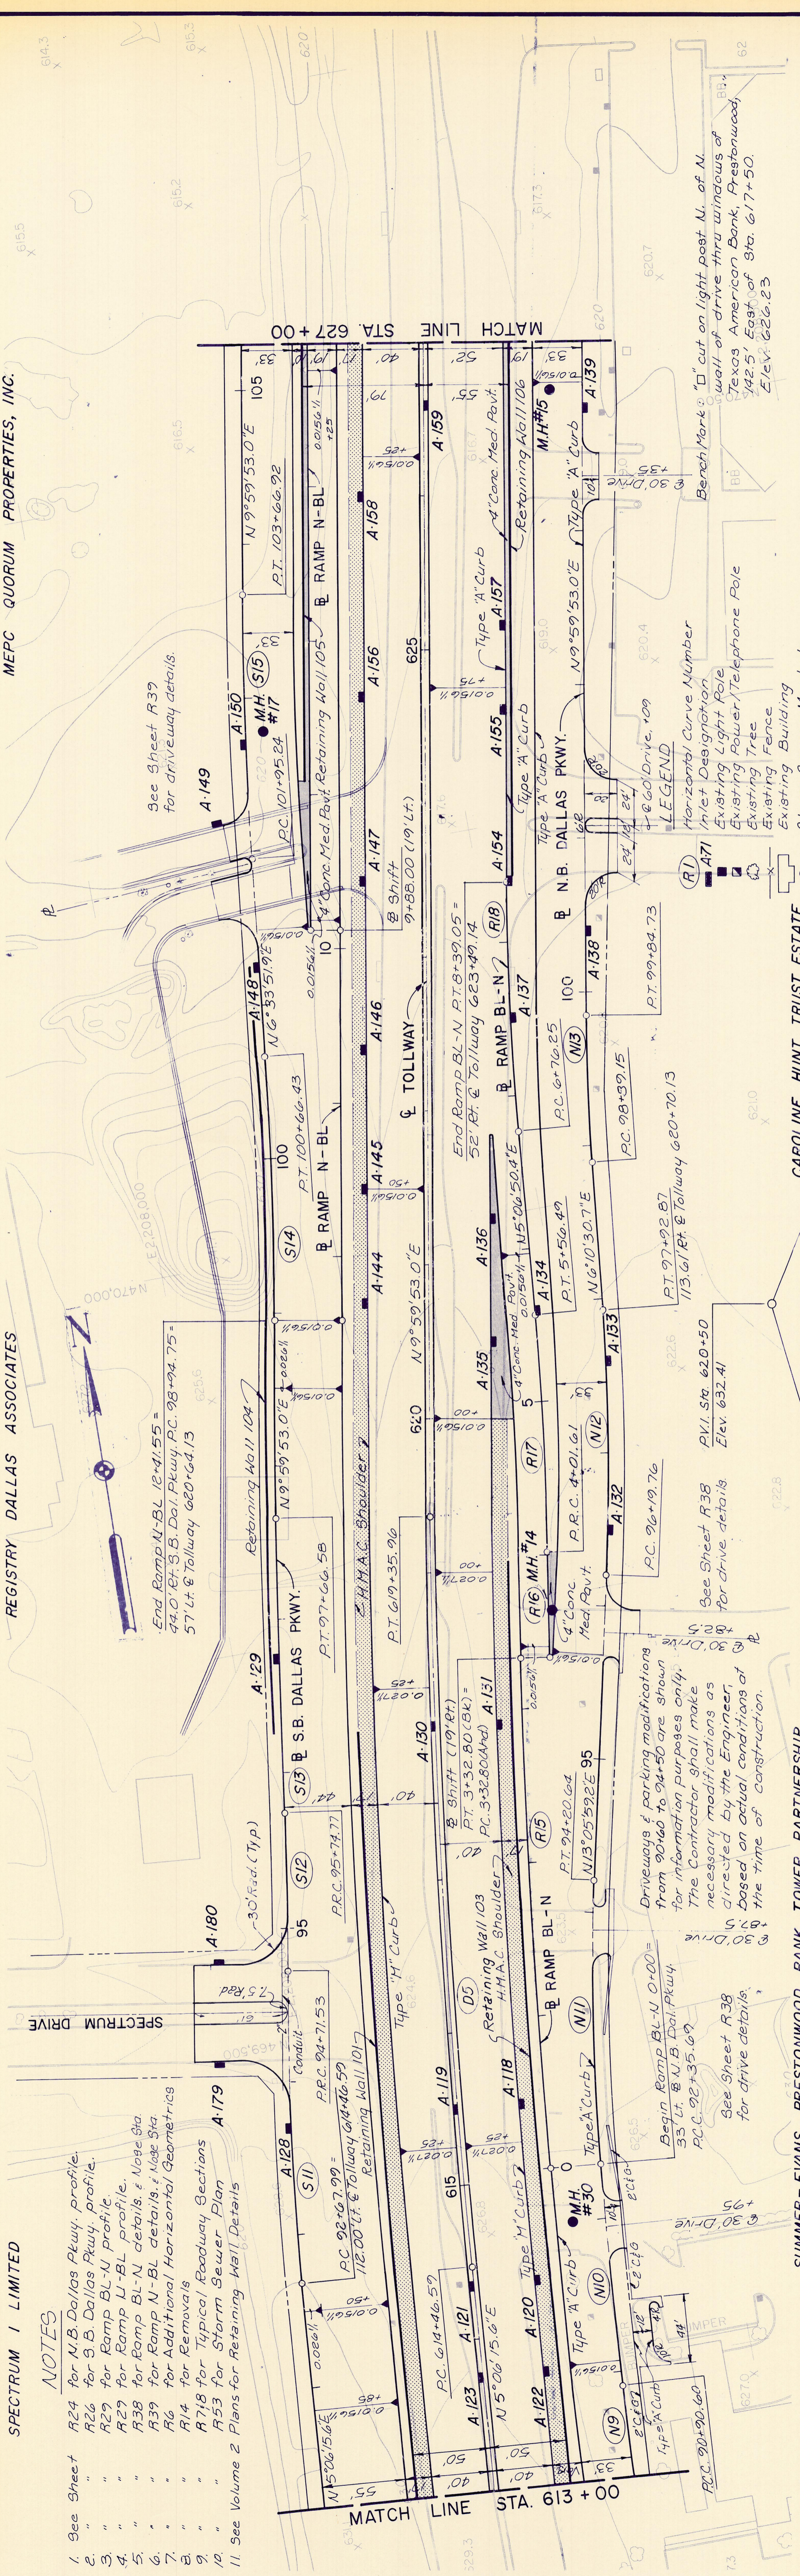

NO.	REVISION	BY	DATE
27			

TEXAS TURNPIKE AUTHORITY

DALLAS NORTH TOLLWAY

PLAN AND PROFILE

STA. 613+00 TO STA. 627+00

TurnerCollie & Braden Inc. Consulting Engineers

DESIGNED: G.C.S. DATE: 3-83
 CHECKED: J.B.L. DATE: 3-83
 SCALE: 1/4" = 50' V.L. = 1" = 5'

SECTION VI

CONTRACT NO. DNT-114 SHEET R2L OF R103