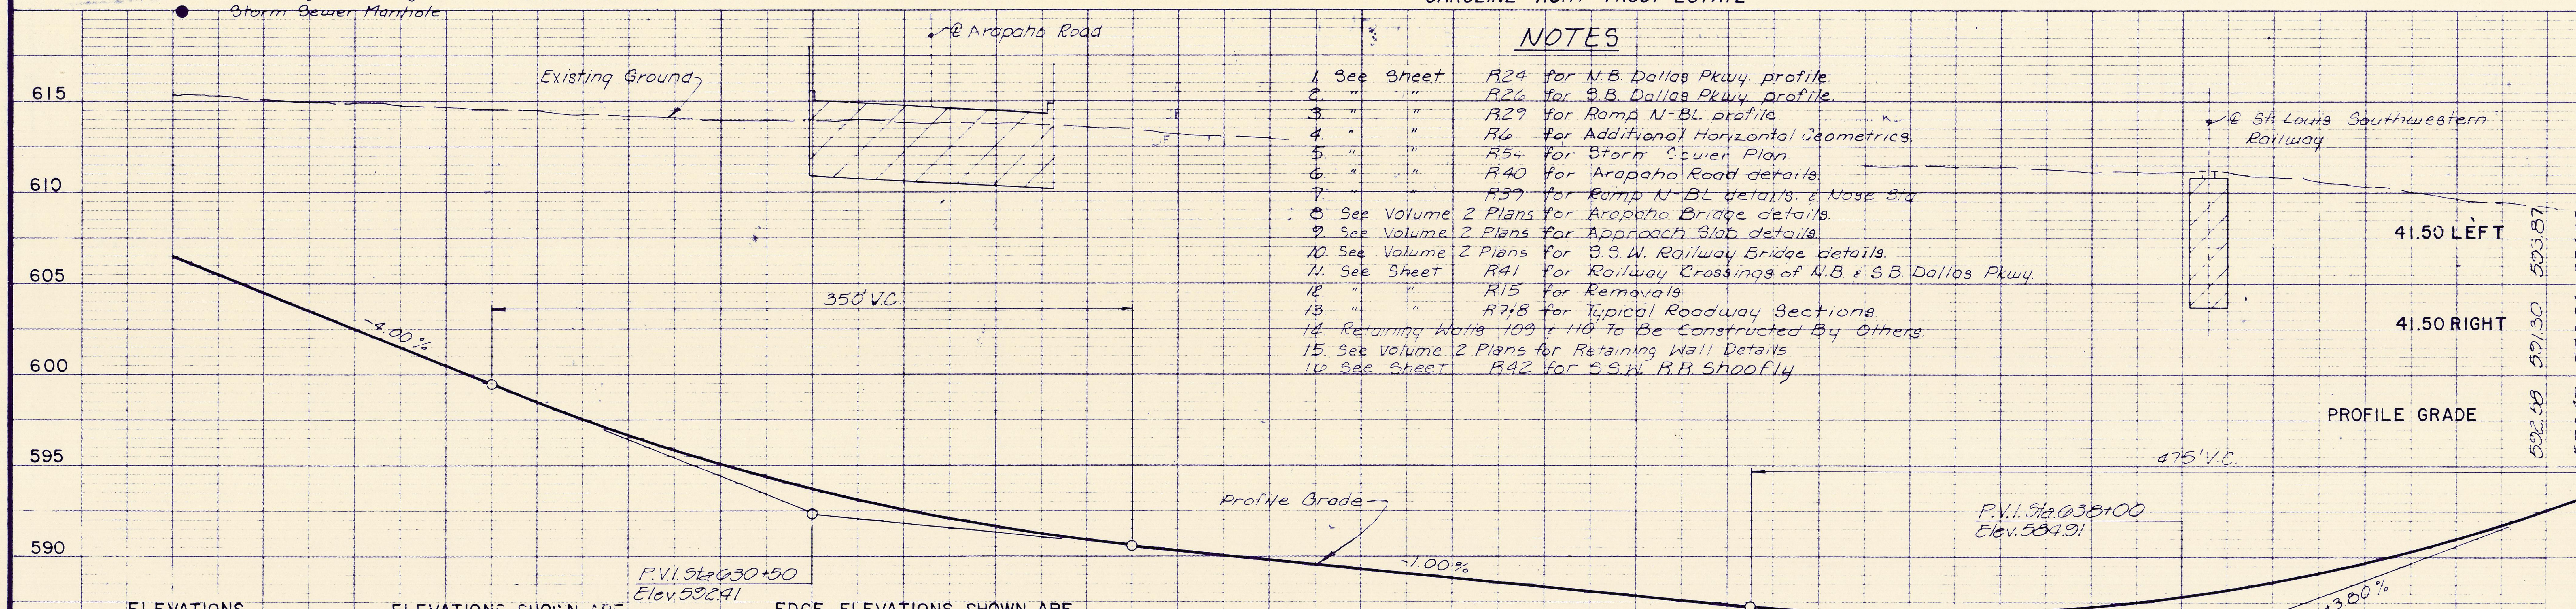

NOTES

1. See Sheet R24 for N.B. Dallas Pkwy. profile
2. " " R26 for S.B. Dallas Pkwy. profile
3. " " R29 for Ramp N-BL profile
4. " " R6 for Additional Horizontal Geometrics
5. " " R54 for Storm Sewer Plan
6. " " R40 for Arapaho Road details
7. " " R39 for Ramp N-BL details & Nose 3.4
8. See Volume 2 Plans for Arapaho Bridge details
9. See Volume 2 Plans for Approach Slab details
10. See Volume 2 Plans for S.S.W. Railway Bridge details
11. See Sheet R41 for Railway Crossings of N.B. & S.B. Dallas Pkwy.
12. " R15 for Removals
13. " R7,8 for Typical Roadway Sections
14. Retaining Walls 109 & 110 to Be Constructed By Others
15. See Volume 2 Plans for Retaining Wall Details
16. See Sheet R42 for S.S.W. R.R. Shoofly

ELEVATIONS 40' Lt. & 52' Rt. (627+00 to 627+50)
ELEVATIONS SHOWN ARE 37' RIGHT AND LEFT OF MEDIAN EDGE (627+75 to 630+00)
EDGE ELEVATIONS SHOWN ARE 41.5' RIGHT AND LEFT OF ℄ (630+25 to 640)

Station	LEFT	RIGHT	PROFILE GRADE
27	605.48	607.18	606.41
	604.36	606.35	605.41
	603.24	605.52	604.41
	602.12	604.38	603.41
28	601.00	603.51	602.41
	599.88	602.64	601.41
	598.77	601.70	600.41
	597.65	600.89	599.41
29	596.58	600.05	598.44
	595.56	599.20	597.52
	594.65	598.52	596.65
	593.84	597.84	595.84
630	593.08	597.08	595.08
	592.38	596.37	594.37
	591.72	595.72	593.72
	591.13	595.12	593.12
31	590.58	594.58	592.58
	590.09	594.09	592.09
	589.65	593.65	591.65
	589.27	593.27	591.27
32	588.94	592.93	590.94
	588.66	592.66	590.66
	588.41	592.41	590.41
	588.16	592.16	590.16
33	587.91	591.91	589.91
	587.66	591.66	589.66
	587.41	591.41	589.41
	587.16	591.16	589.16
34	586.91	590.91	588.91
	586.66	590.66	588.66
	586.55	590.27	588.41
	586.45	589.87	588.16
635	586.34	589.48	587.91
	586.23	589.09	587.66
	586.13	588.69	587.41
	586.03	588.31	587.17
36	585.98	587.98	586.98
	586.00	587.71	586.86
	586.08	587.51	586.80
	586.23	587.37	586.80
37	586.44	587.29	586.87
	586.71	587.28	586.99
	587.04	587.33	587.19
	587.44	587.44	587.44
38	587.90	587.62	587.70
	588.43	587.86	588.14
	589.01	588.16	588.59
	589.67	588.52	589.09
39	590.38	588.95	589.67
	591.16	589.44	590.30
	592.00	590.00	591.00
	592.90	590.62	591.70
640			

41.50 LEFT	593.87	594.90	595.98
41.50 RIGHT	591.30	592.04	592.84
PROFILE GRADE	592.58	593.47	594.41

AS BUILT PLANS

NO.	REVISION	BY	DATE
5	Added Conduit	JTK	2-19-86
4	Revise Drive Sta. 106+29.00	GMG	11-85
3	Revise Drive Sta 106+29.00	Ram	11-84
2	DELETE DRIVE IN RIGHT TURN	GRB	9-84
1	CONTRACT LIMITS NB & SB DALLAS PARKWAY	GGS	4-84

TEXAS TURNPIKE AUTHORITY

DALLAS NORTH TOLLWAY

PLAN AND PROFILE

STA. 627+00 TO STA. 638+50

Turner Collie & Braden Inc. Consulting Engineers

SECTION VI

DRAWN T.K.L. DATE 3-83 | DESIGNED G.G.S. DATE 3-83
CHECKED J.B.L. DATE 3-83 | SCALE H: 1" = 50' / V: 1" = 5'

CONTRACT NO. DNT-114 SHEET R22 OF R103