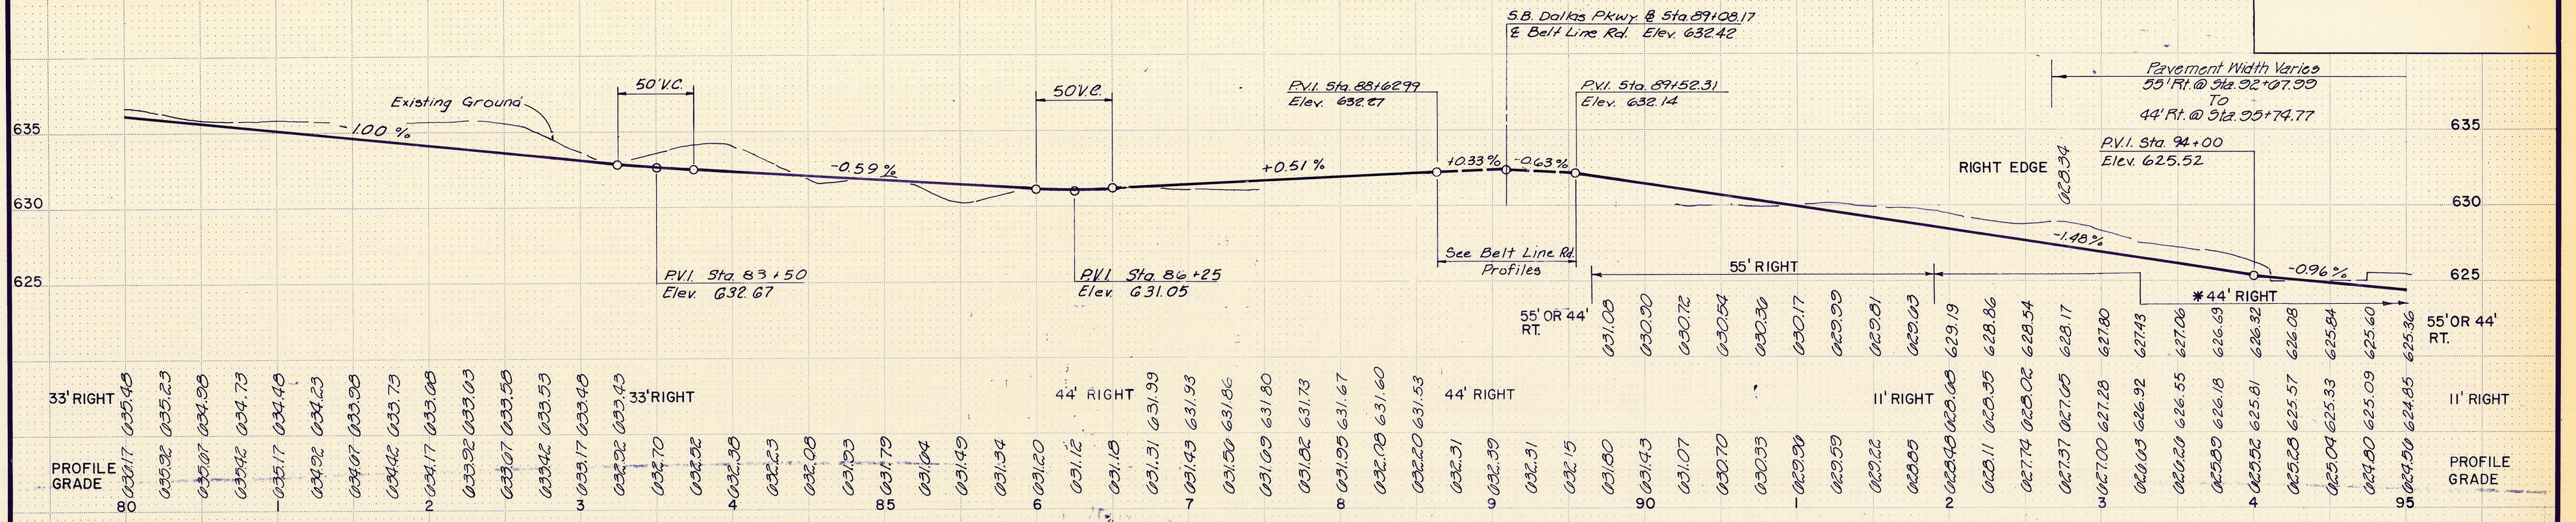

* Extend Pavement Cross Slope Of + 3/16" / Ft. From Elevations Shown At 44' Right To Right Edge Of Proposed Southbound Dallas Parkway.

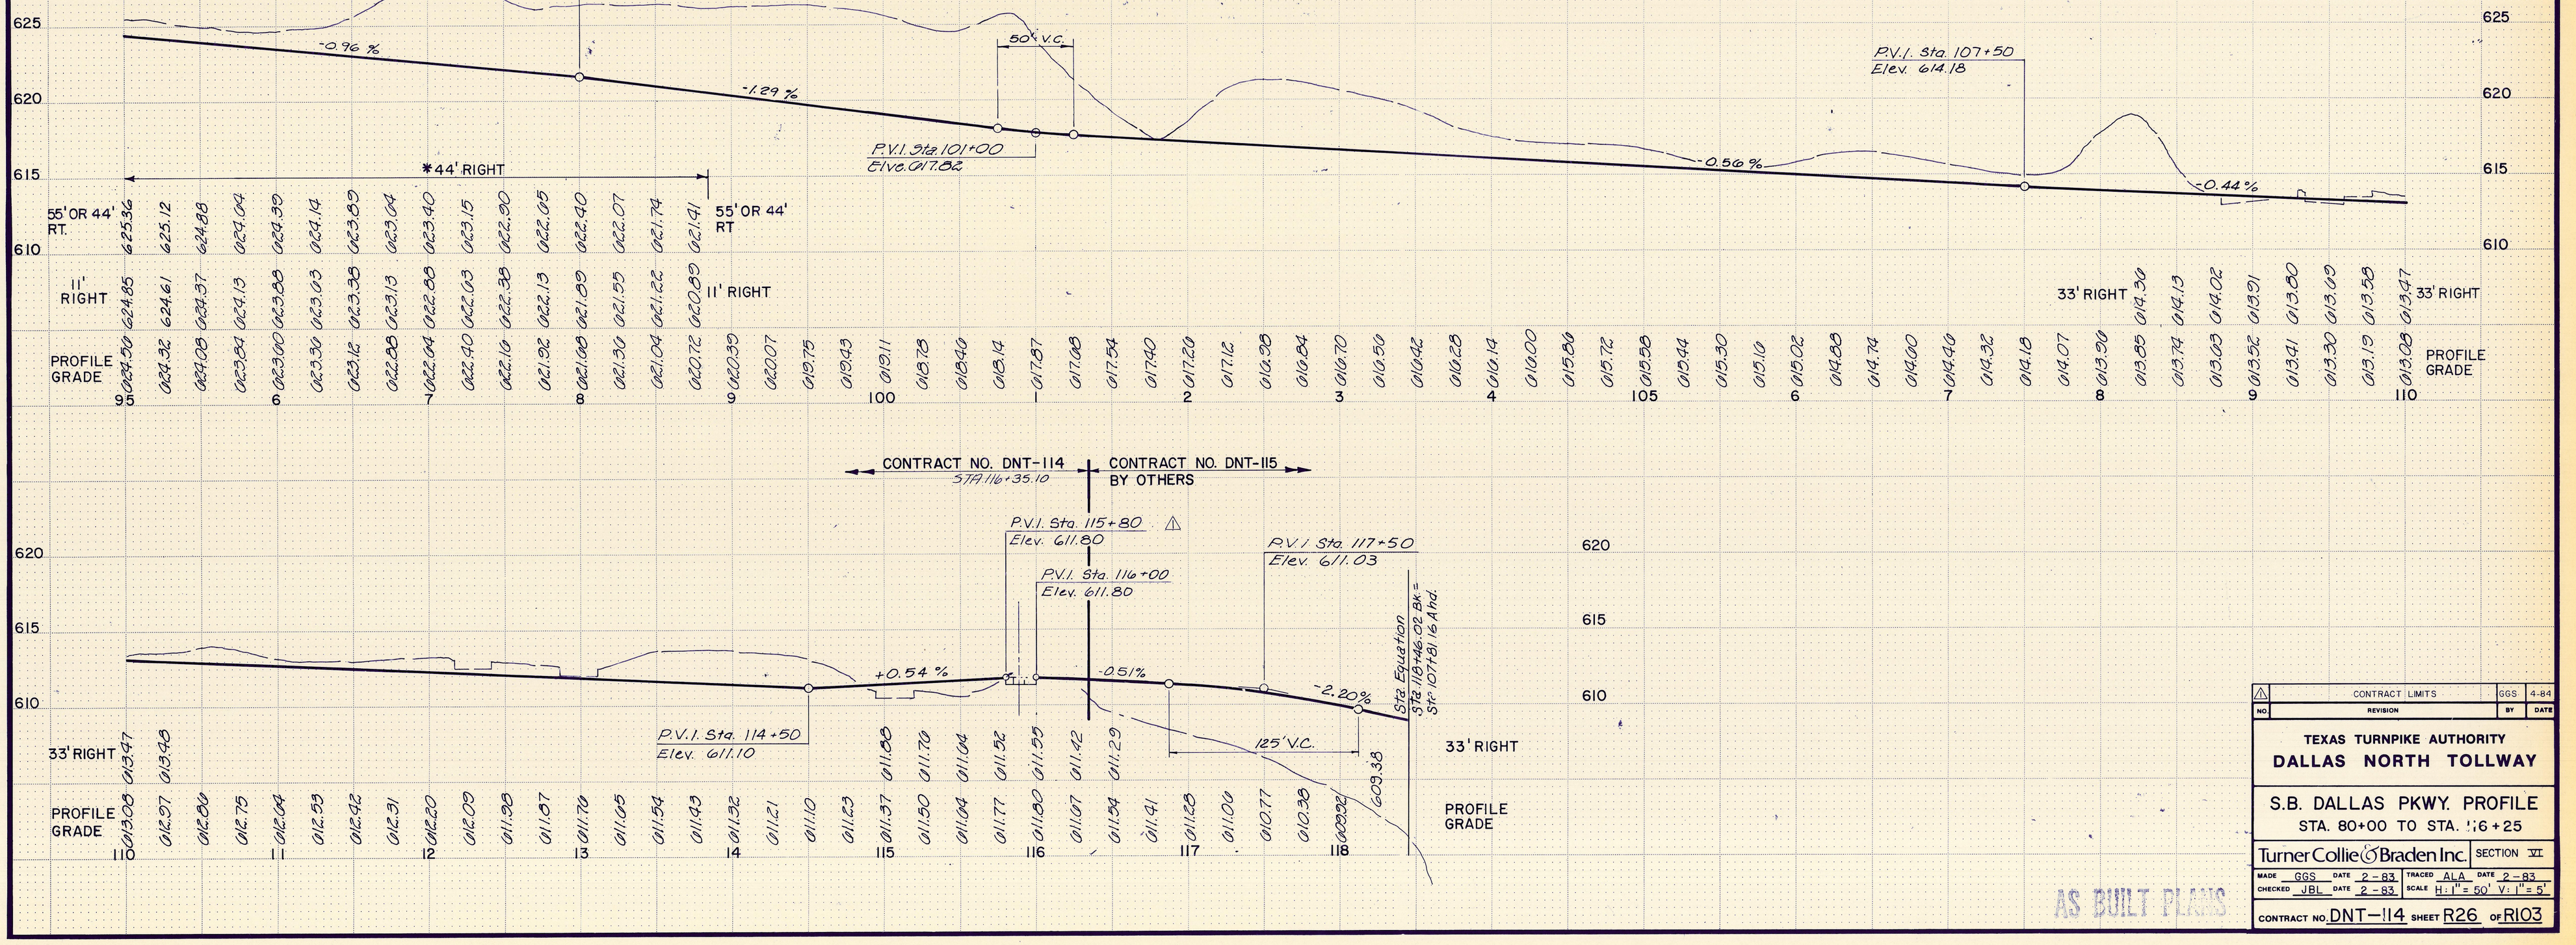

AS BUILT PLANS

NO.	REVISION	BY	DATE
△	CONTRACT LIMITS	GGS	4-84

TEXAS TURNPIKE AUTHORITY
DALLAS NORTH TOLLWAY

S.B. DALLAS PKWY. PROFILE
STA. 80+00 TO STA. 116+25

Turner Collie & Braden Inc. | SECTION VI

MADE GGS DATE 2-83 | TRACED ALA DATE 2-83
CHECKED JBL DATE 2-83 | SCALE H: 1" = 50' V: 1" = 5'

CONTRACT NO. DNT-114 SHEET R26 OF R103