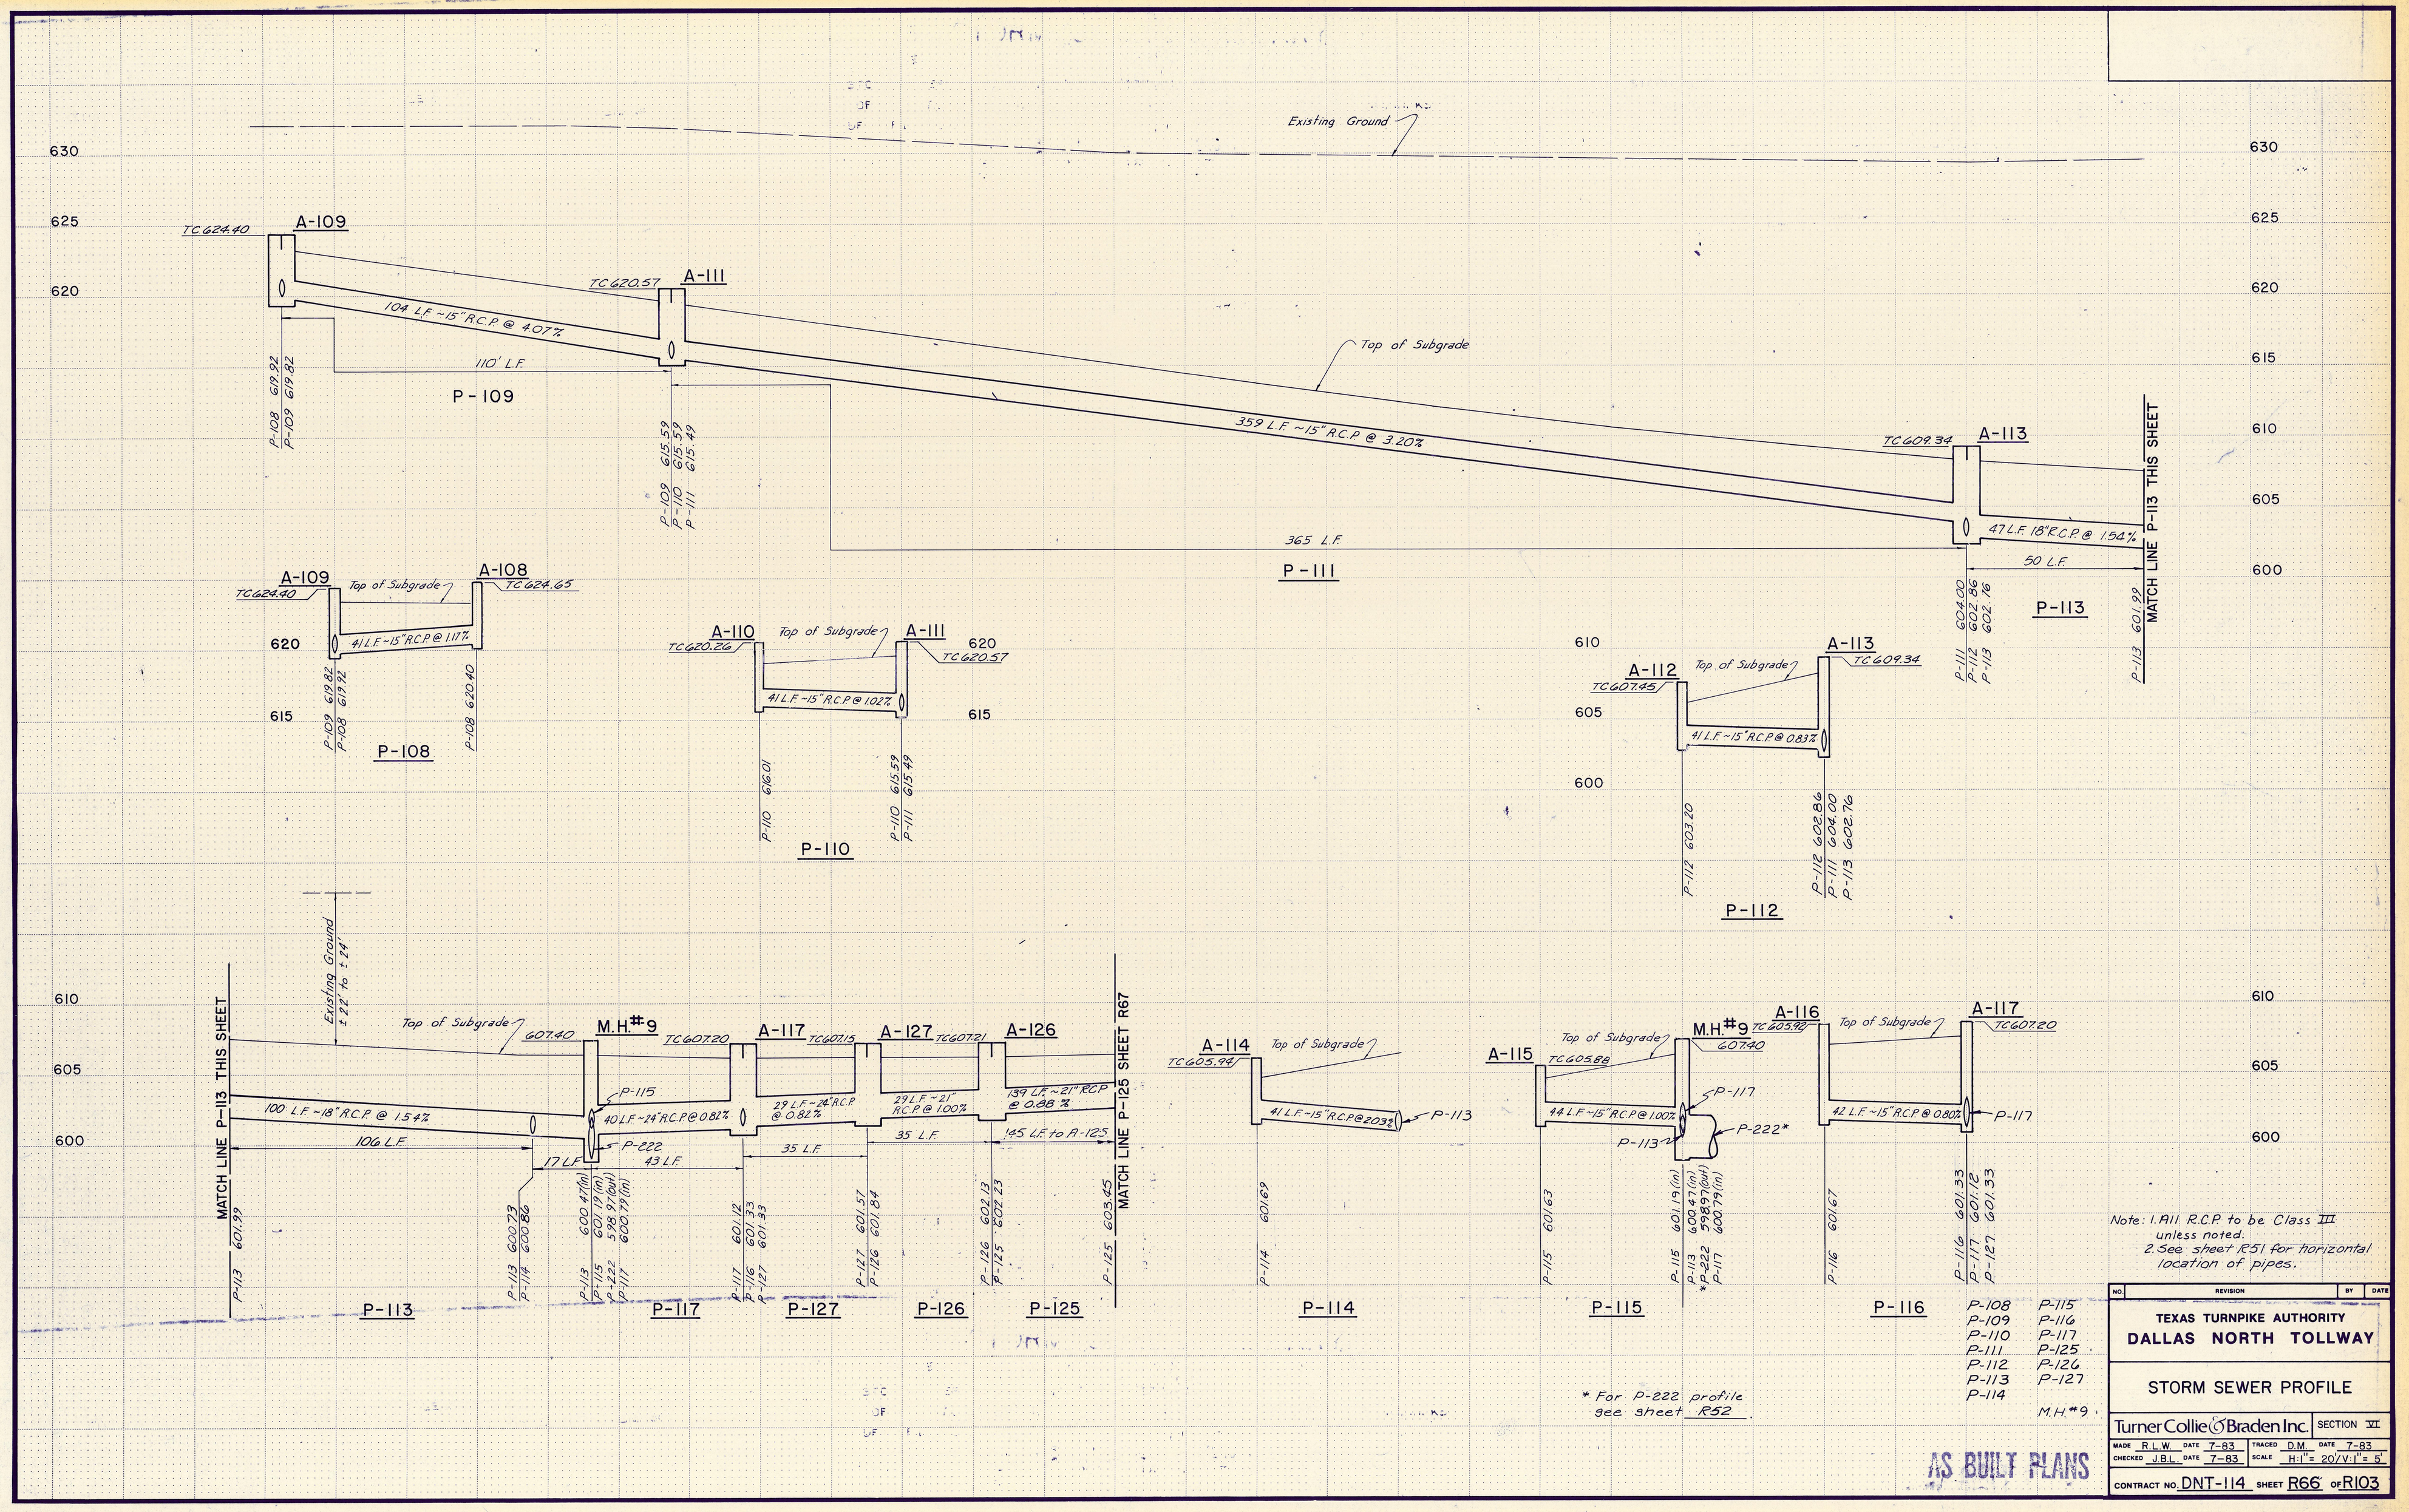

Note: 1. All R.C.P. to be Class III unless noted.
2. See sheet R51 for horizontal location of pipes.

NO.	REVISION	BY	DATE

TEXAS TURNPIKE AUTHORITY
DALLAS NORTH TOLLWAY

STORM SEWER PROFILE

Turner Collie & Braden Inc. | SECTION VI

MADE R.L.W. DATE 7-83 | TRACED D.M. DATE 7-83
CHECKED J.B.L. DATE 7-83 | SCALE H:1"= 20' V:1"= 5'

CONTRACT NO. DNT-114 SHEET R66 OF R103

P-108, P-109, P-110, P-111, P-112, P-113, P-114, P-115, P-116, P-117, P-125, P-126, P-127, M.H. #9

* For P-222 profile see sheet R52

AS BUILT PLANS