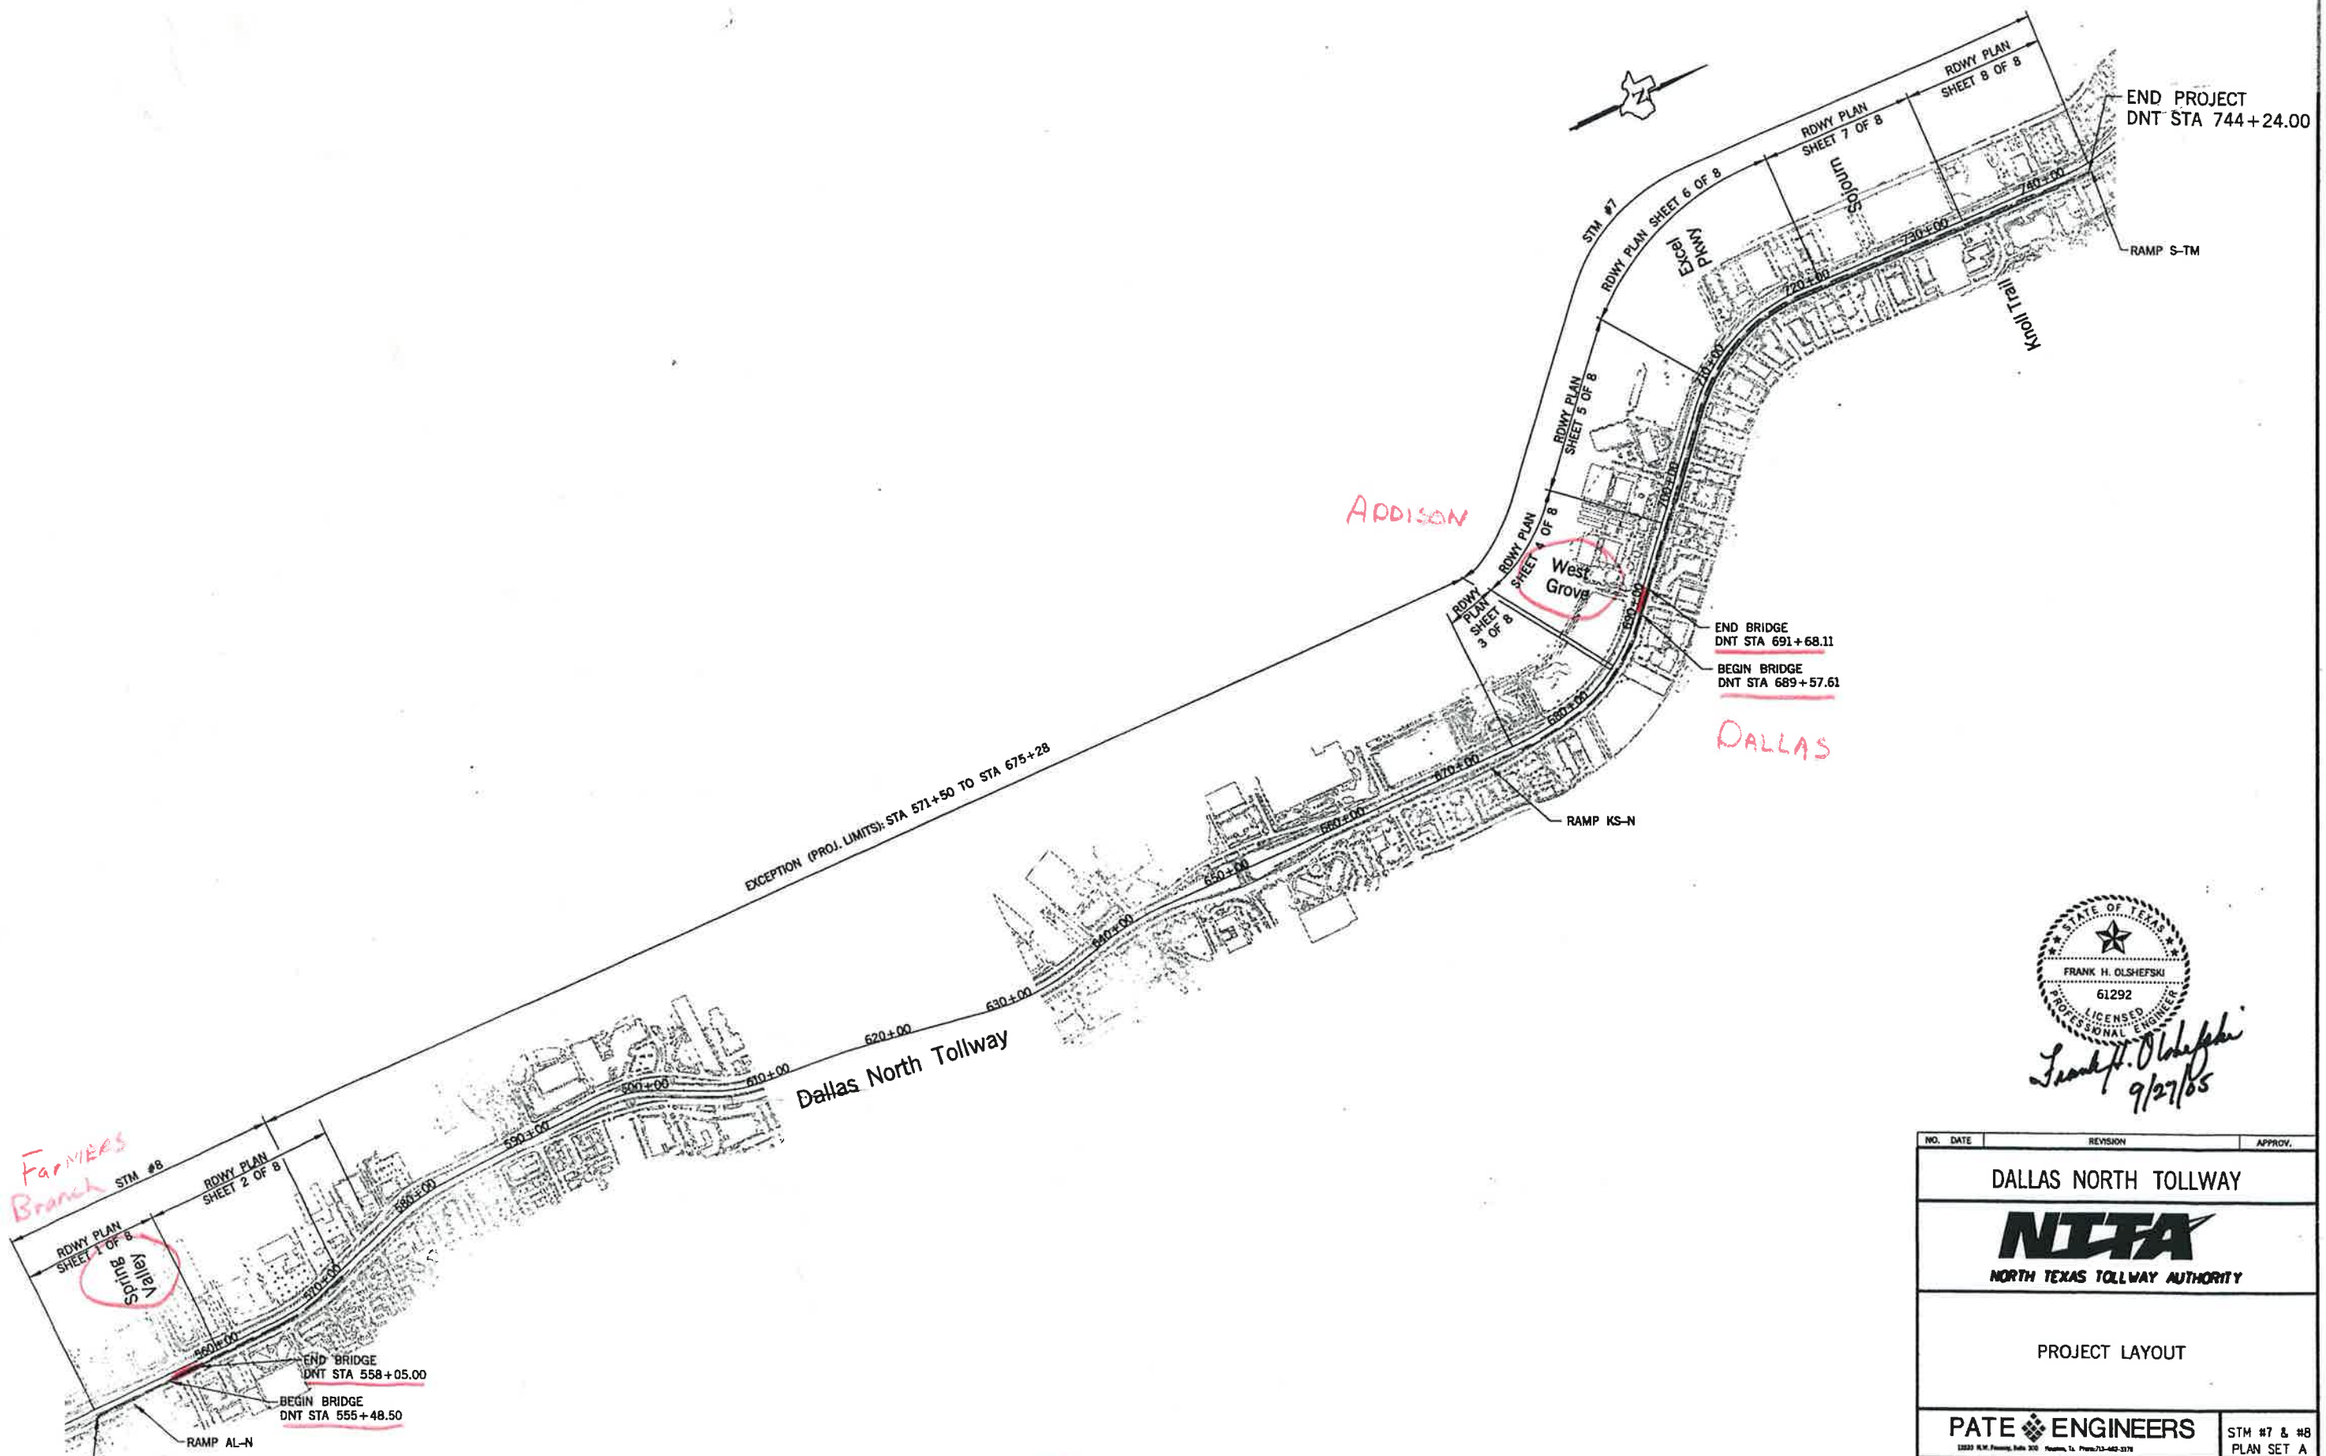

STATE OF TEXAS
FRANK H. OLSHEFSKI
61292
LICENSED PROFESSIONAL ENGINEER
Frank H. Olshefski
9/27/05

NO.	DATE	REVISION	APPROV.

DALLAS NORTH TOLLWAY

NTTA
NORTH TEXAS TOLLWAY AUTHORITY

PROJECT LAYOUT

PATE ENGINEERS
13333 N.W. Freeway, Suite 300 Houston, Tx. Phone 713-462-3178

STM #7 & #8
PLAN SET A

DRAWN KMH DATE 09-02-05
CHECKED RR DATE 09-02-05
DESIGNED DD DATE 09-02-05
SCALE NTS

CONTRACT NO. 02039-DNT-02-CN-EN A3 OF A247

02039

Sheet 1 of 1

PATE ENG
6:12:55 PM
9/27/2005
N:\130800\100\sheets
LIETPSBE-184.PLT
(dbpl.dgn