


Storm Sewer Curve Data

Δ = 16° 29' 36"
R = 164.0'
T = 23.77'
L = 47.21'

Bench Mark: Top of bolt in N.W. cor of base plate for parking lot light standard, 143' East of Sta. 609+20.6 Elev. 630.76

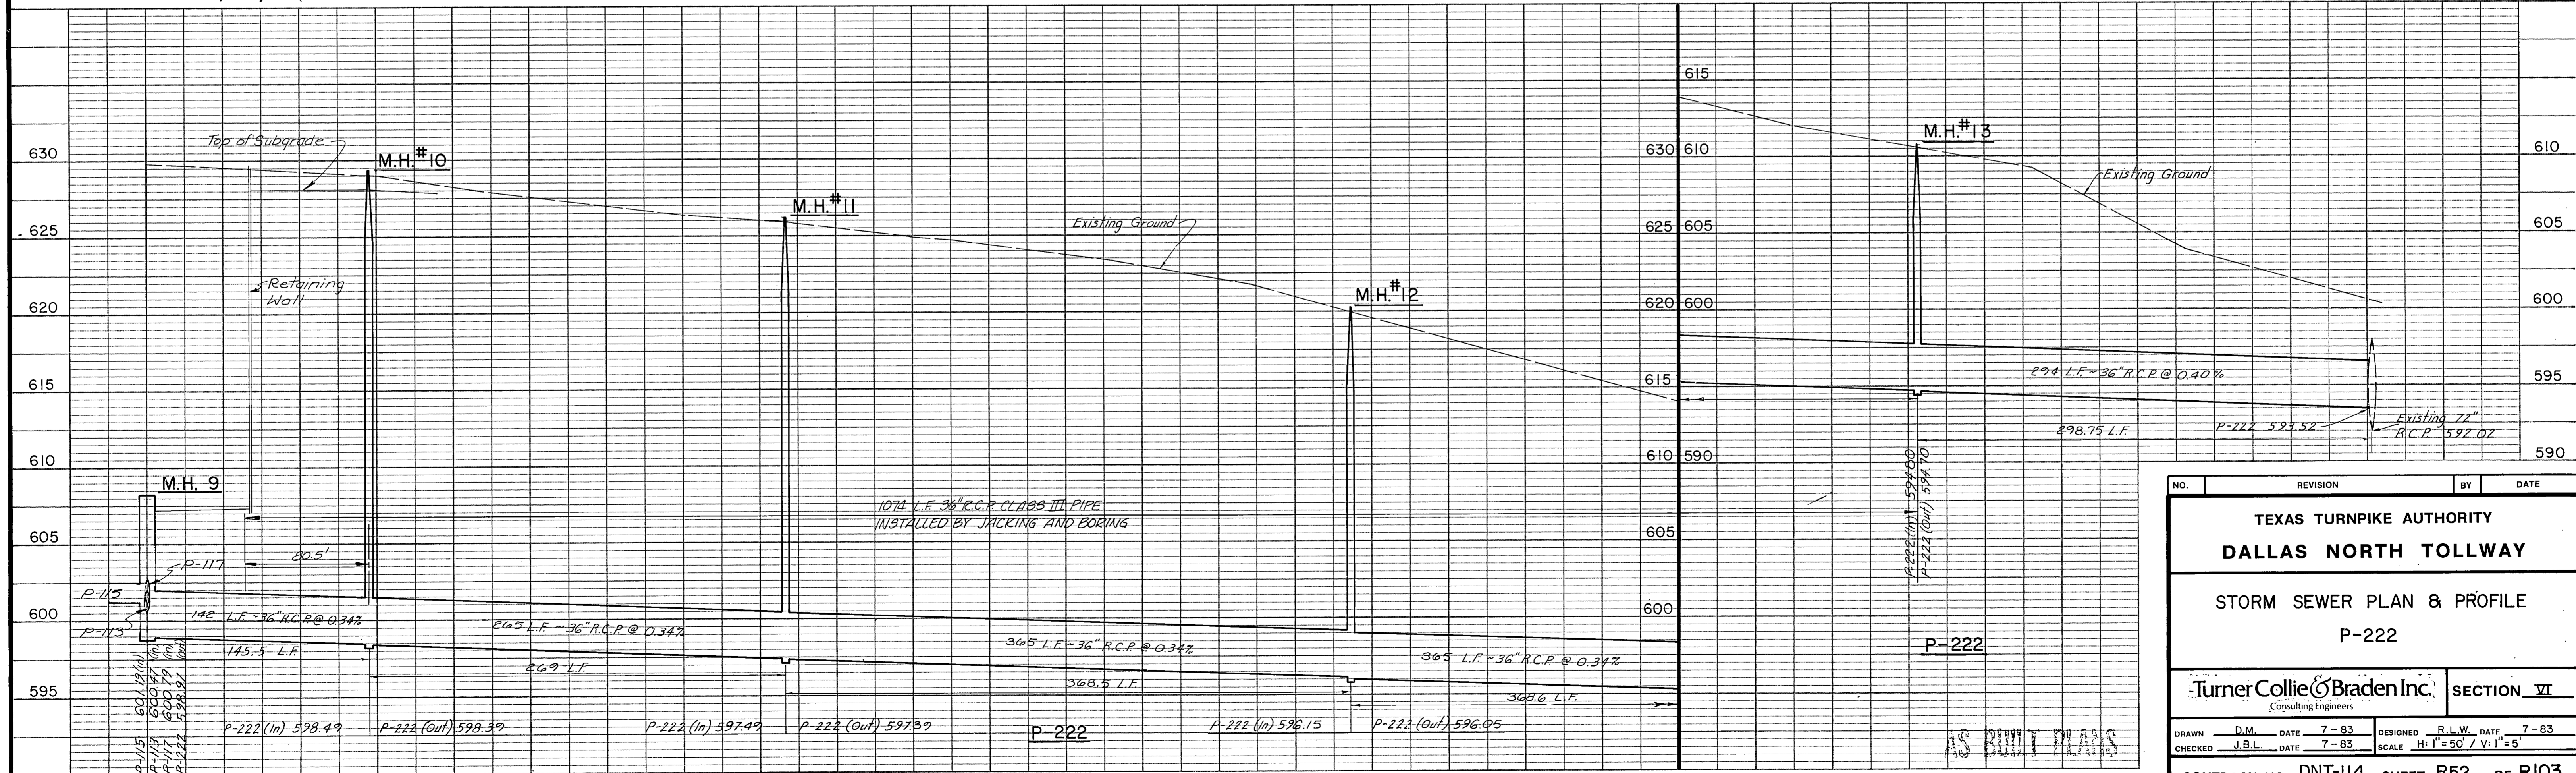

NO.	REVISION	BY	DATE
TEXAS TURNPIKE AUTHORITY DALLAS NORTH TOLLWAY			
STORM SEWER PLAN & PROFILE P-222			
Turner Collie & Braden Inc. Consulting Engineers			SECTION VI
DRAWN	D.M.	DATE	7-83
DESIGNED	R.L.W.	DATE	7-83
CHECKED	J.B.L.	DATE	7-83
SCALE		H: 1" = 50' / V: 1" = 5'	
CONTRACT NO. DNT-114 SHEET R52 OF R103			