


CONTRACT NO. DNT-114 CONTRACT NO. DNT-115 (BY OTHERS)

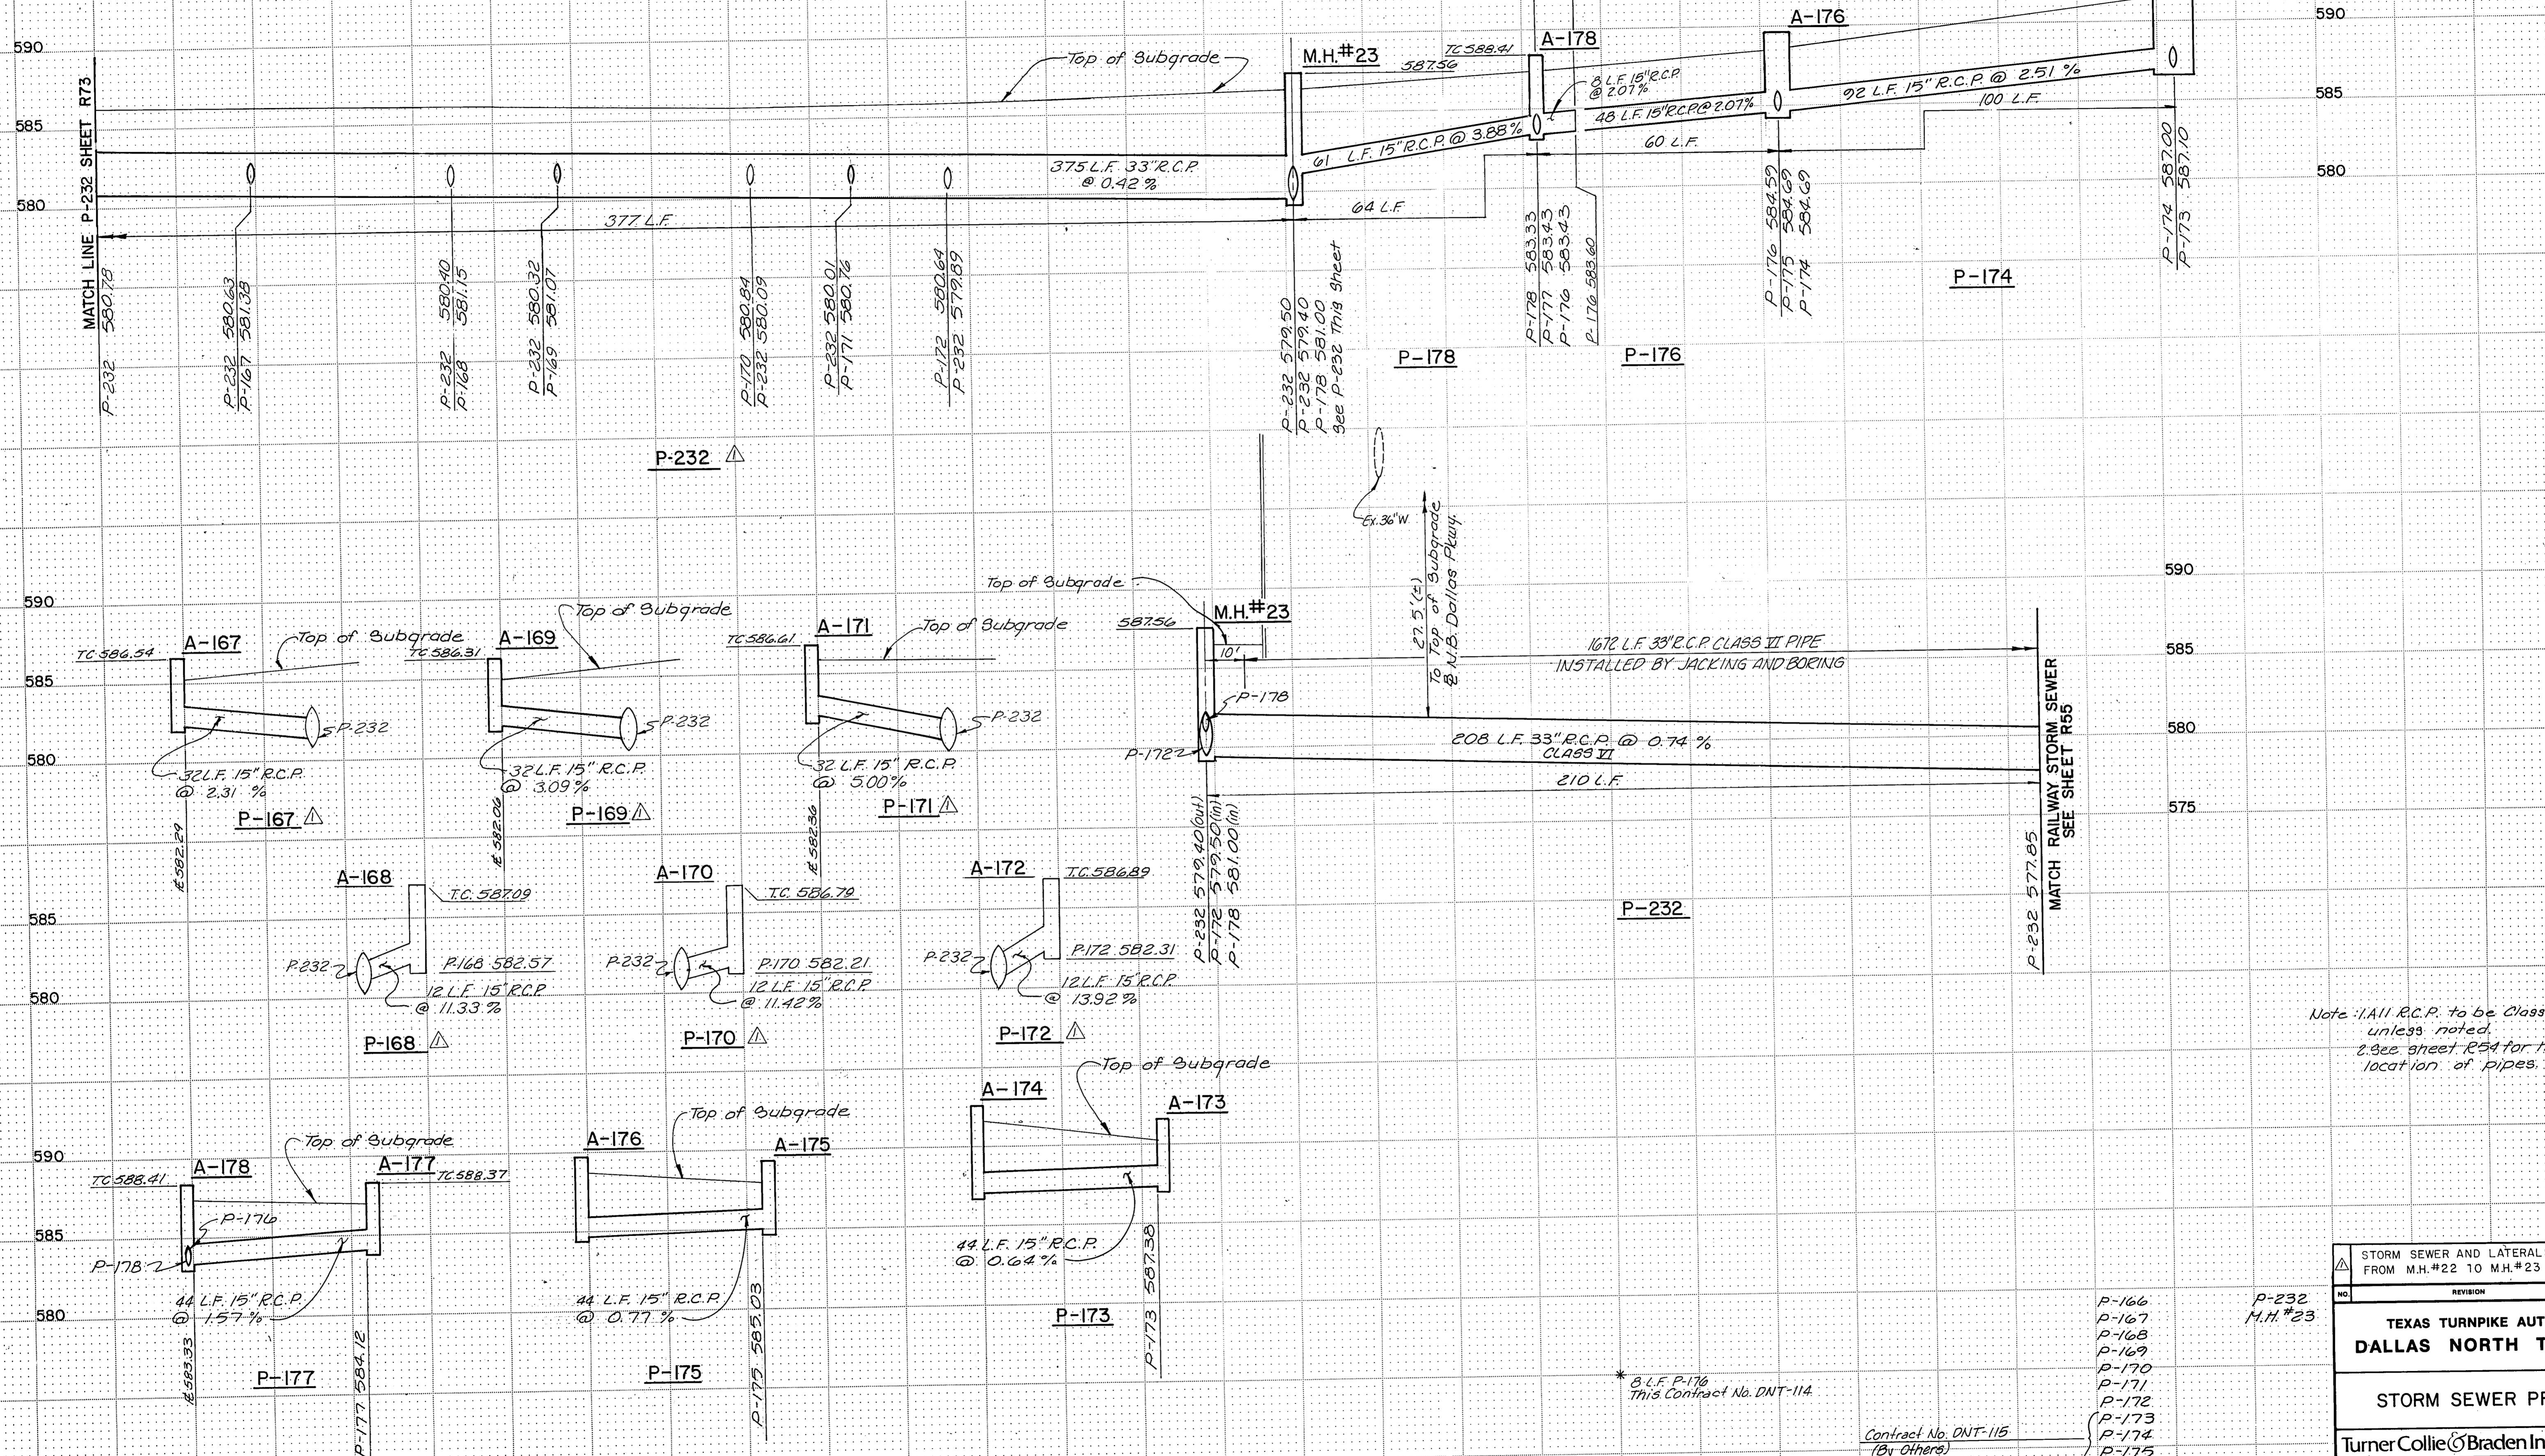

Note: 1. All R.C.P. to be Class III unless noted.
2. See sheet R54 for horizontal location of pipes.

- P-166
 - P-167
 - P-168
 - P-169
 - P-170
 - P-171
 - P-172
 - P-173
 - P-174
 - P-175
 - P-176*
 - P-177
 - P-178
- M.H.#23

Contract No. DNT-115 (By Others)

* 8 L.F. P-176 This Contract No. DNT-114

STORM SEWER AND LATERALS FROM M.H.#22 TO M.H.#23		GG.S.	5-84
TEXAS TURNPIKE AUTHORITY DALLAS NORTH TOLLWAY			
STORM SEWER PROFILE			
Turner Collie & Braden Inc.		SECTION VI	
MADE D.W.G. DATE 7-83	TRACED A.L.A. DATE 7-83		
CHECKED J.B.L. DATE 7-83	SCALE H ₁ " = 20' / V ₁ " = 5'		
CONTRACT NO. DNT-114		SHEET R74 OF R103	