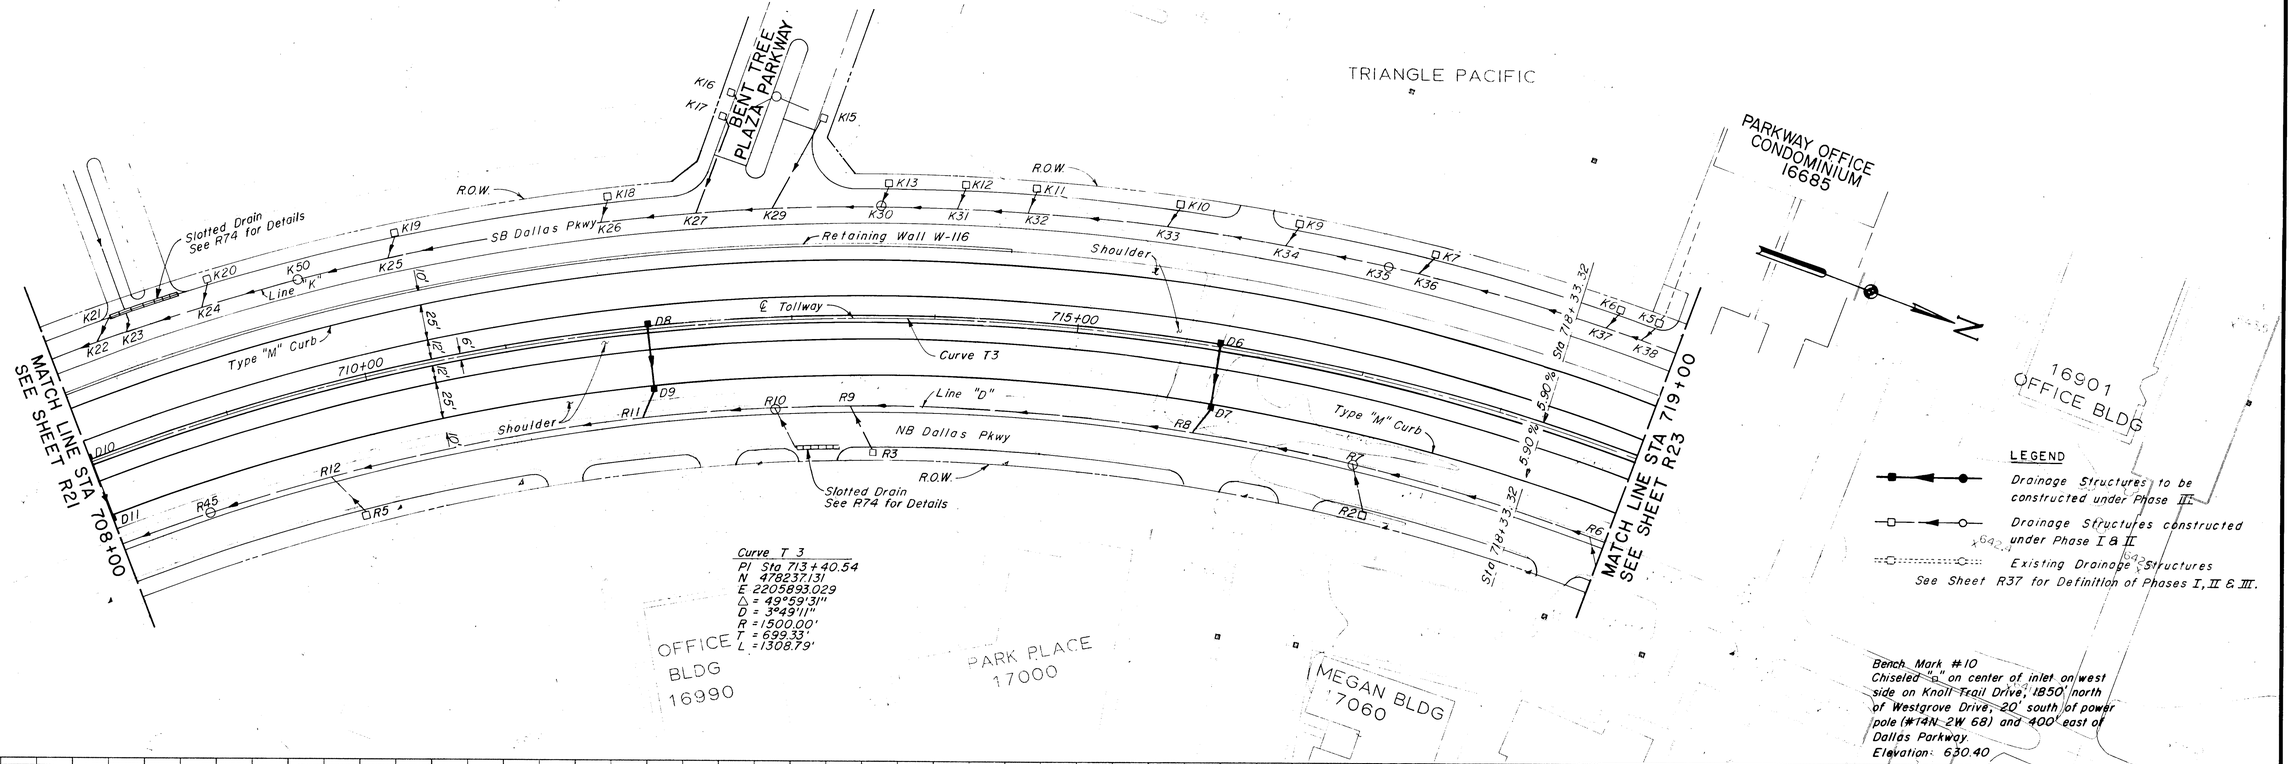

Curve T 3
PI Sta 713+40.54
N 478237.131
E 2205893.029
Δ = 49°59'31"
D = 3°49'11"
R = 1500.00'
T = 699.33'
L = 1308.79'

Bench Mark #10
Chiseled "+" on center of inlet on west side on Knoll Trail Drive, 1850' north of Westgrove Drive, 20' south of power pole (#14N-2W 68) and 400' east of Dallas Parkway
Elevation: 630.40

NOTES
1. See Sheet R12 for Dallas Parkway Plan & Profile for Removals
2. See Sheet W12 for Retaining Wall Details.
3. See Sheet R 62 for Storm Sewer Details.
4. For Shoulder and Median Barrier Details See Typical Sections.

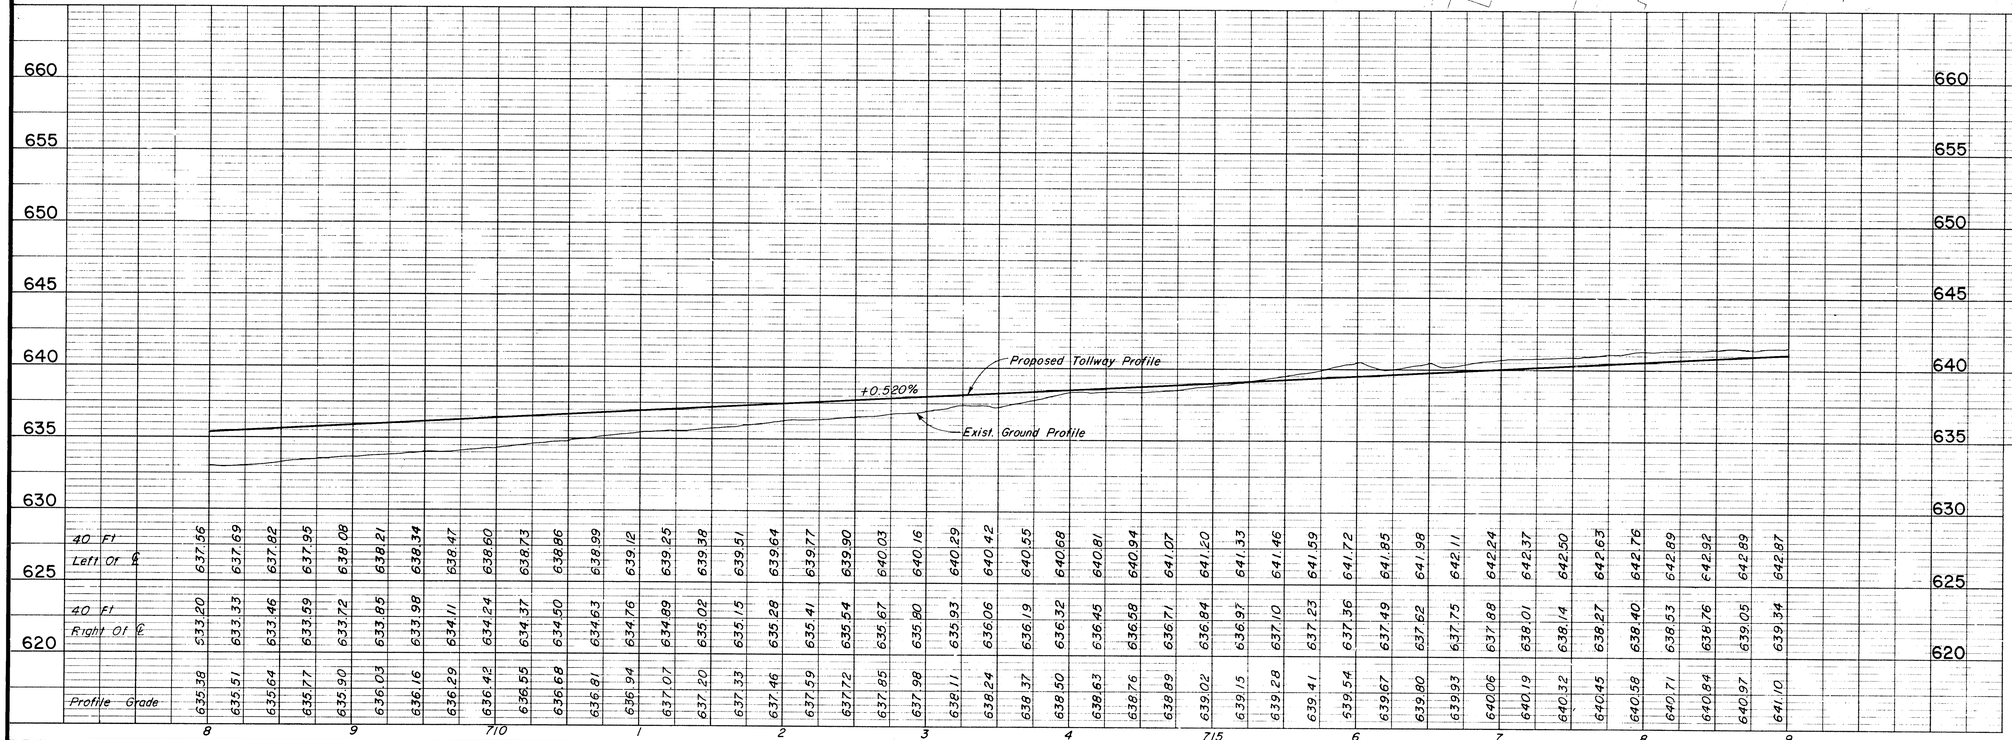

ASBUILT PLANS

NO.	REVISION	BY	DATE

TEXAS TURNPIKE AUTHORITY

DALLAS NORTH TOLLWAY

PAVING AND GRADING

TOLLWAY

STA 708+00 TO STA 719+00

Gibbs & Hill, Inc.
ENGINEERS DESIGNERS CONSTRUCTORS DALLAS

SECTION VII

DRAWN VER DATE 7/8/83 DESIGNED DWC DATE 6/30/83
CHECKED DWC DATE 5/4/84 SCALE 1"=50' Hor 1"=5' Vert

CONTRACT NO. DNT-115 SHEET R22 OF R85