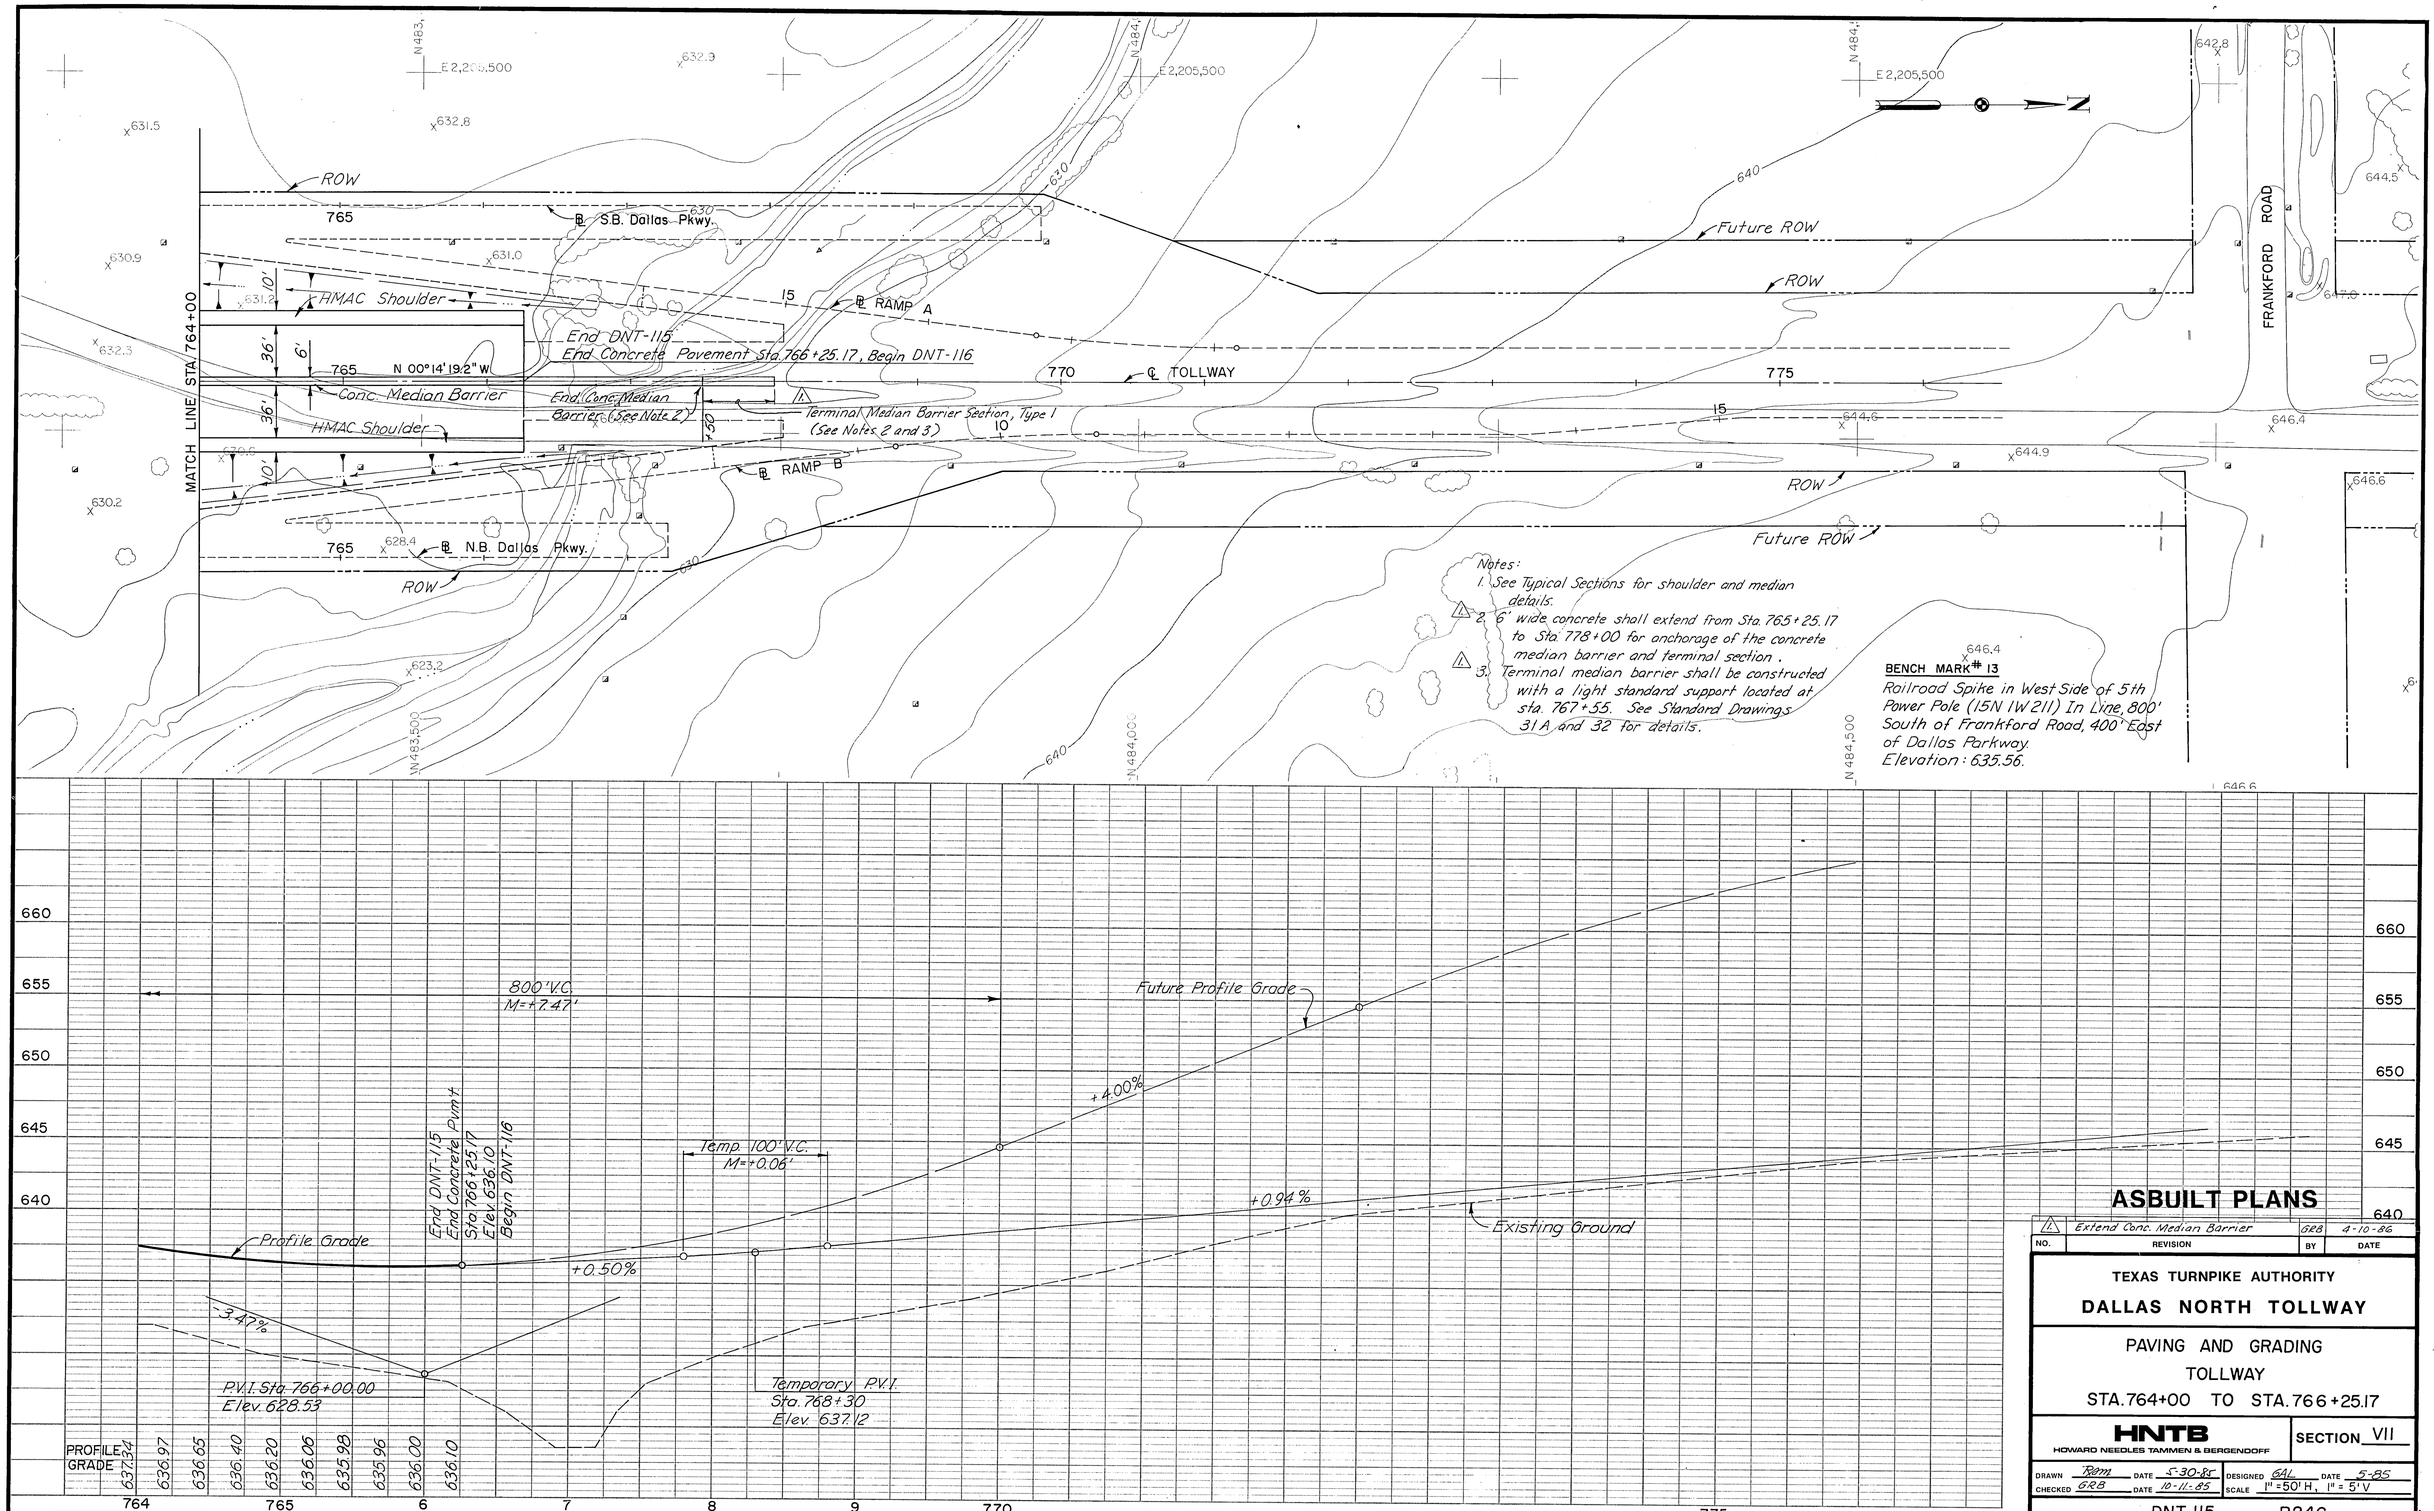

ASBUILT PLANS

NO.	REVISION	BY	DATE
1	Extend Conc. Median Barrier	GRB	4-10-86

TEXAS TURNPIKE AUTHORITY

DALLAS NORTH TOLLWAY

PAVING AND GRADING

TOLLWAY

STA. 764+00 TO STA. 766+25.17

HNTB
HOWARD NEEDLES TAMMEN & BERGENDOFF

SECTION VII

DRAWN RBM DATE 5-30-85 DESIGNED GAL DATE 5-85
CHECKED GRB DATE 10-11-85 SCALE 1" = 50' H, 1" = 5' V

CONTRACT NO. DNT-115 SHEET R24C OF