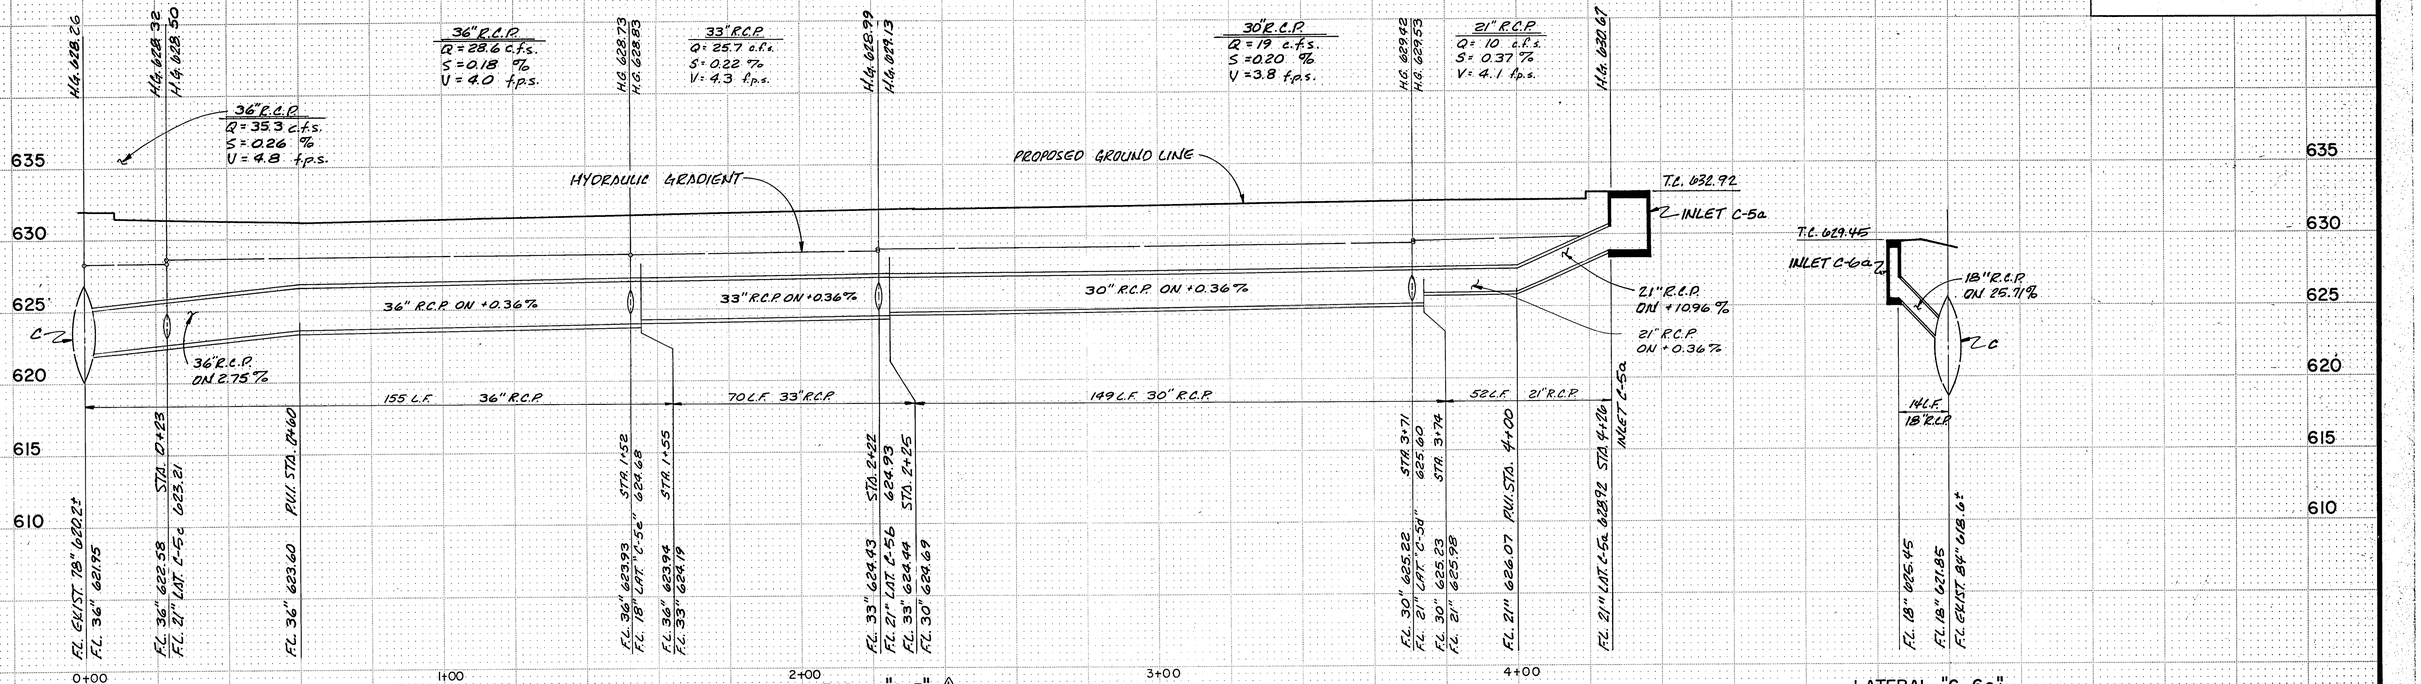

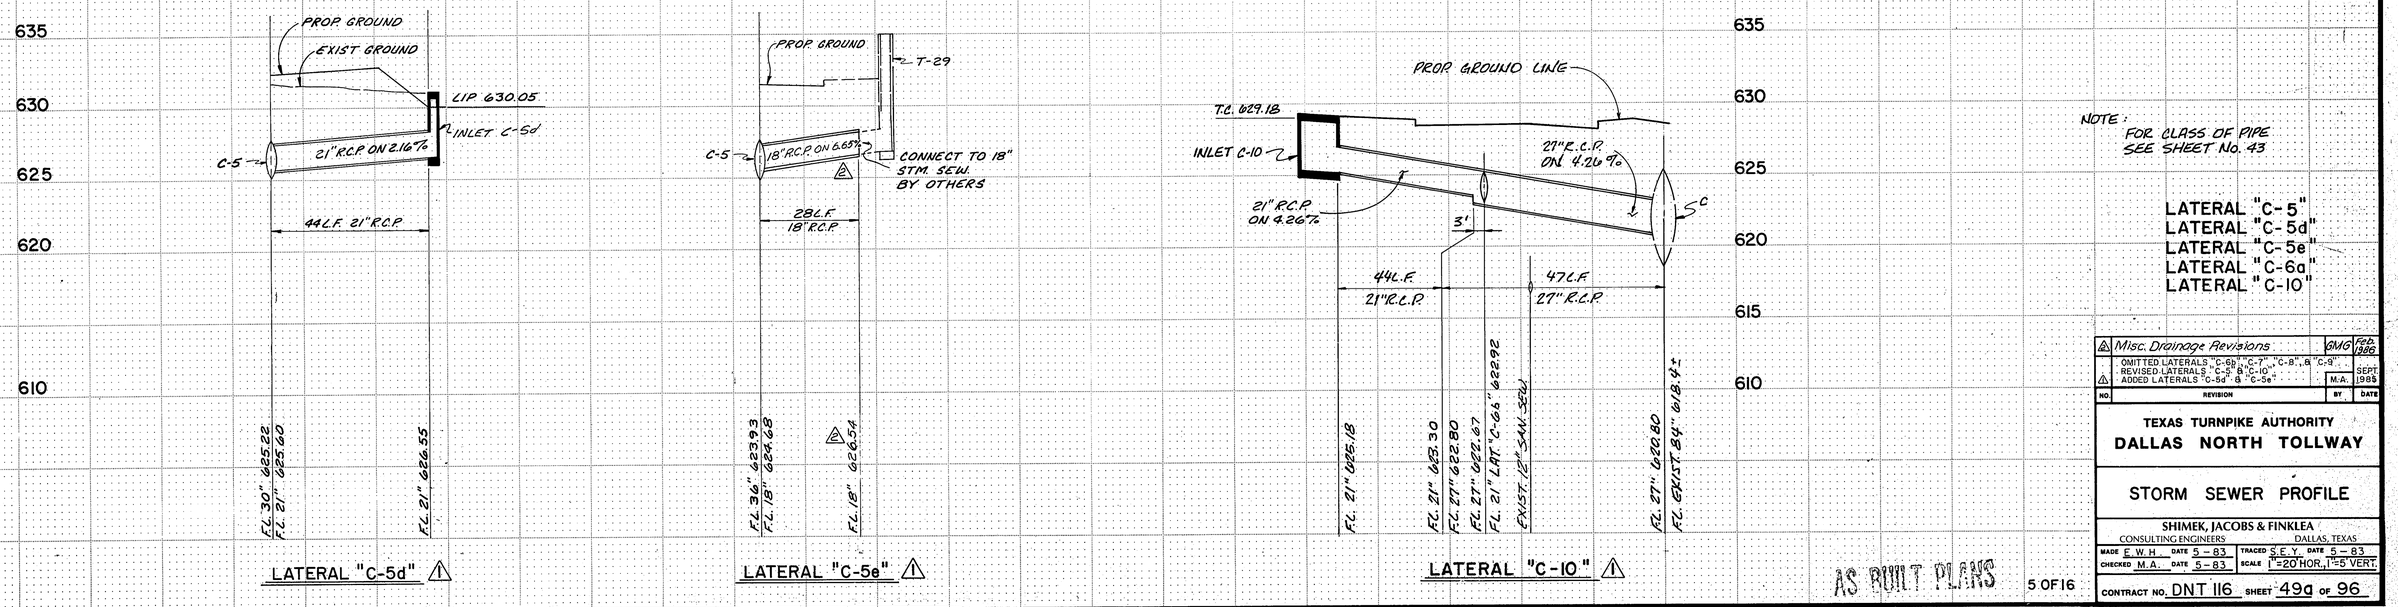

NOTE:
FOR CLASS OF PIPE
SEE SHEET No. 43

LATERAL "C-5"
LATERAL "C-5d"
LATERAL "C-5e"
LATERAL "C-6a"
LATERAL "C-10"

NO.	REVISION	BY	DATE
2	Misc. Drainage Revisions	GMG	Feb. 1986
1	OMITTED LATERALS "C-6b", "C-7", "C-8", & "C-9" REVISED LATERALS "C-5" & "C-10" ADDED LATERALS "C-5d" & "C-5e"	M.A.	SEPT. 1985

TEXAS TURNPIKE AUTHORITY
DALLAS NORTH TOLLWAY

STORM SEWER PROFILE

SHIMEK, JACOBS & FINKLEA
CONSULTING ENGINEERS DALLAS, TEXAS

MADE E.W.H. DATE 5-83 TRACED S.E.Y. DATE 5-83
CHECKED M.A. DATE 5-83 SCALE 1"=20' HOR., 1"=5' VERT.

CONTRACT NO. DNT 116 SHEET 49a OF 96

AS BUILT PLANS

5 OF 16