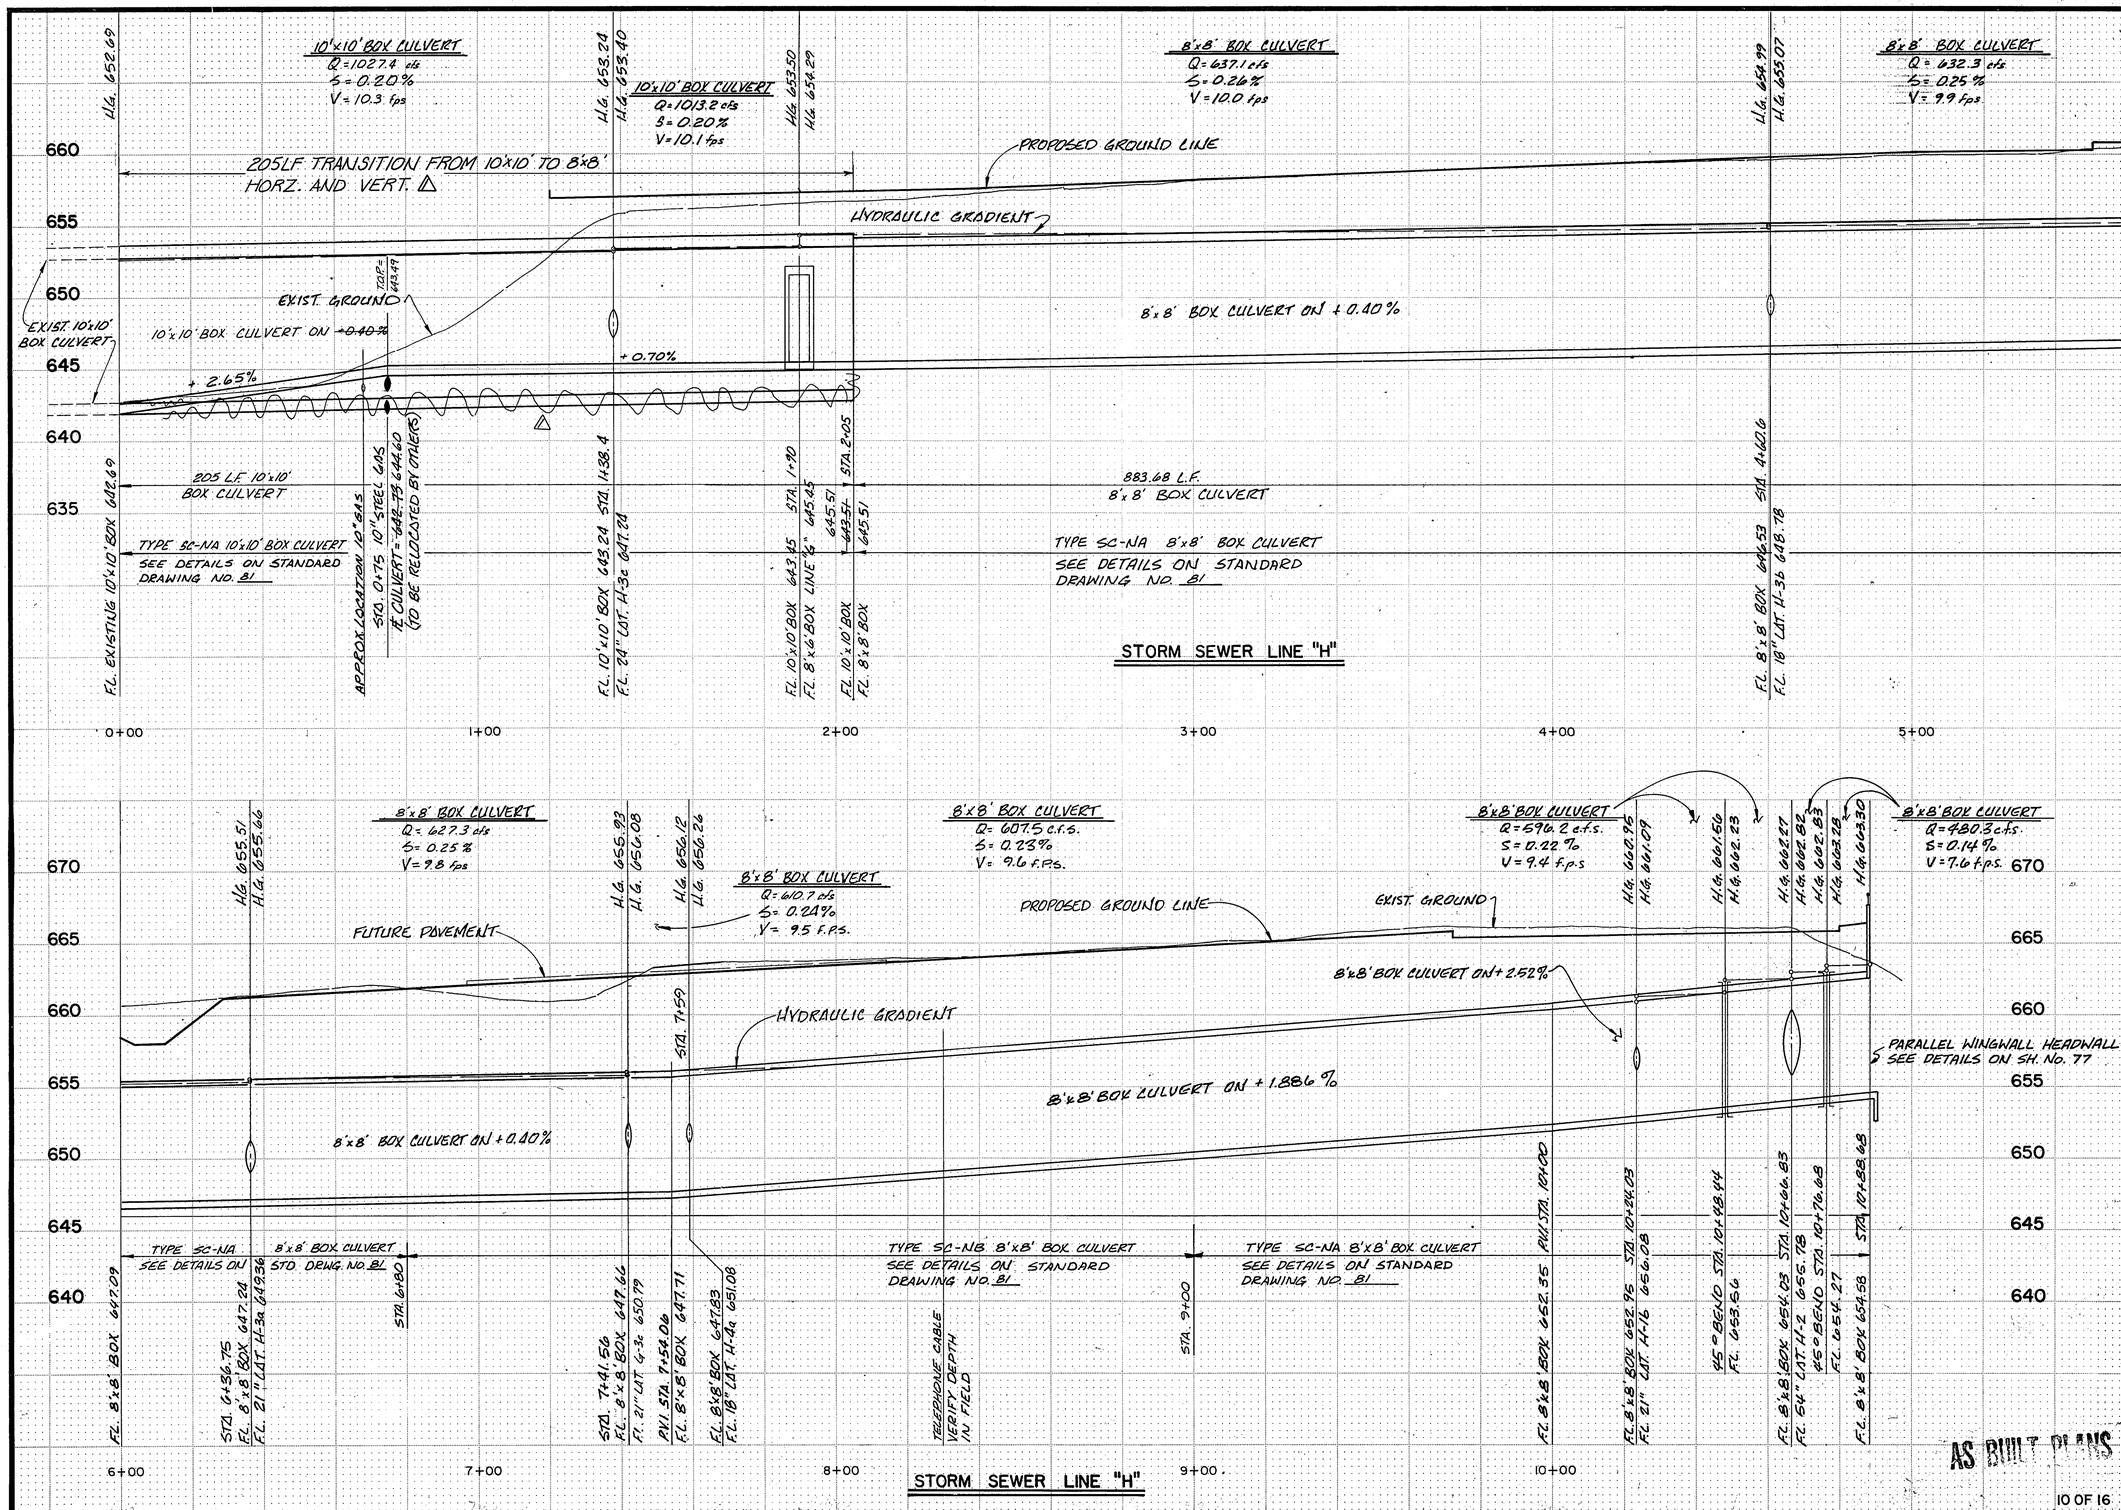

STORM SEWER LINE "H"

NO.	REVISION	BY	DATE
1	Asbuilts	PJ	7-87

TEXAS TURNPIKE AUTHORITY
DALLAS NORTH TOLLWAY

STORM SEWER PROFILE

SHIMEK, JACOBS & FINKLEA
CONSULTING ENGINEERS — DALLAS, TEXAS

MADE D.R.B. DATE 5-83 TRACED S.E.Y. DATE 5-83
CHECKED M.A. DATE 5-83 SCALE 1"=20' HOR., 1"=5' VERT.

AS BUILT PLANS

10 OF 16

CONTRACT NO. DNT 116 SHEET 54 OF 96