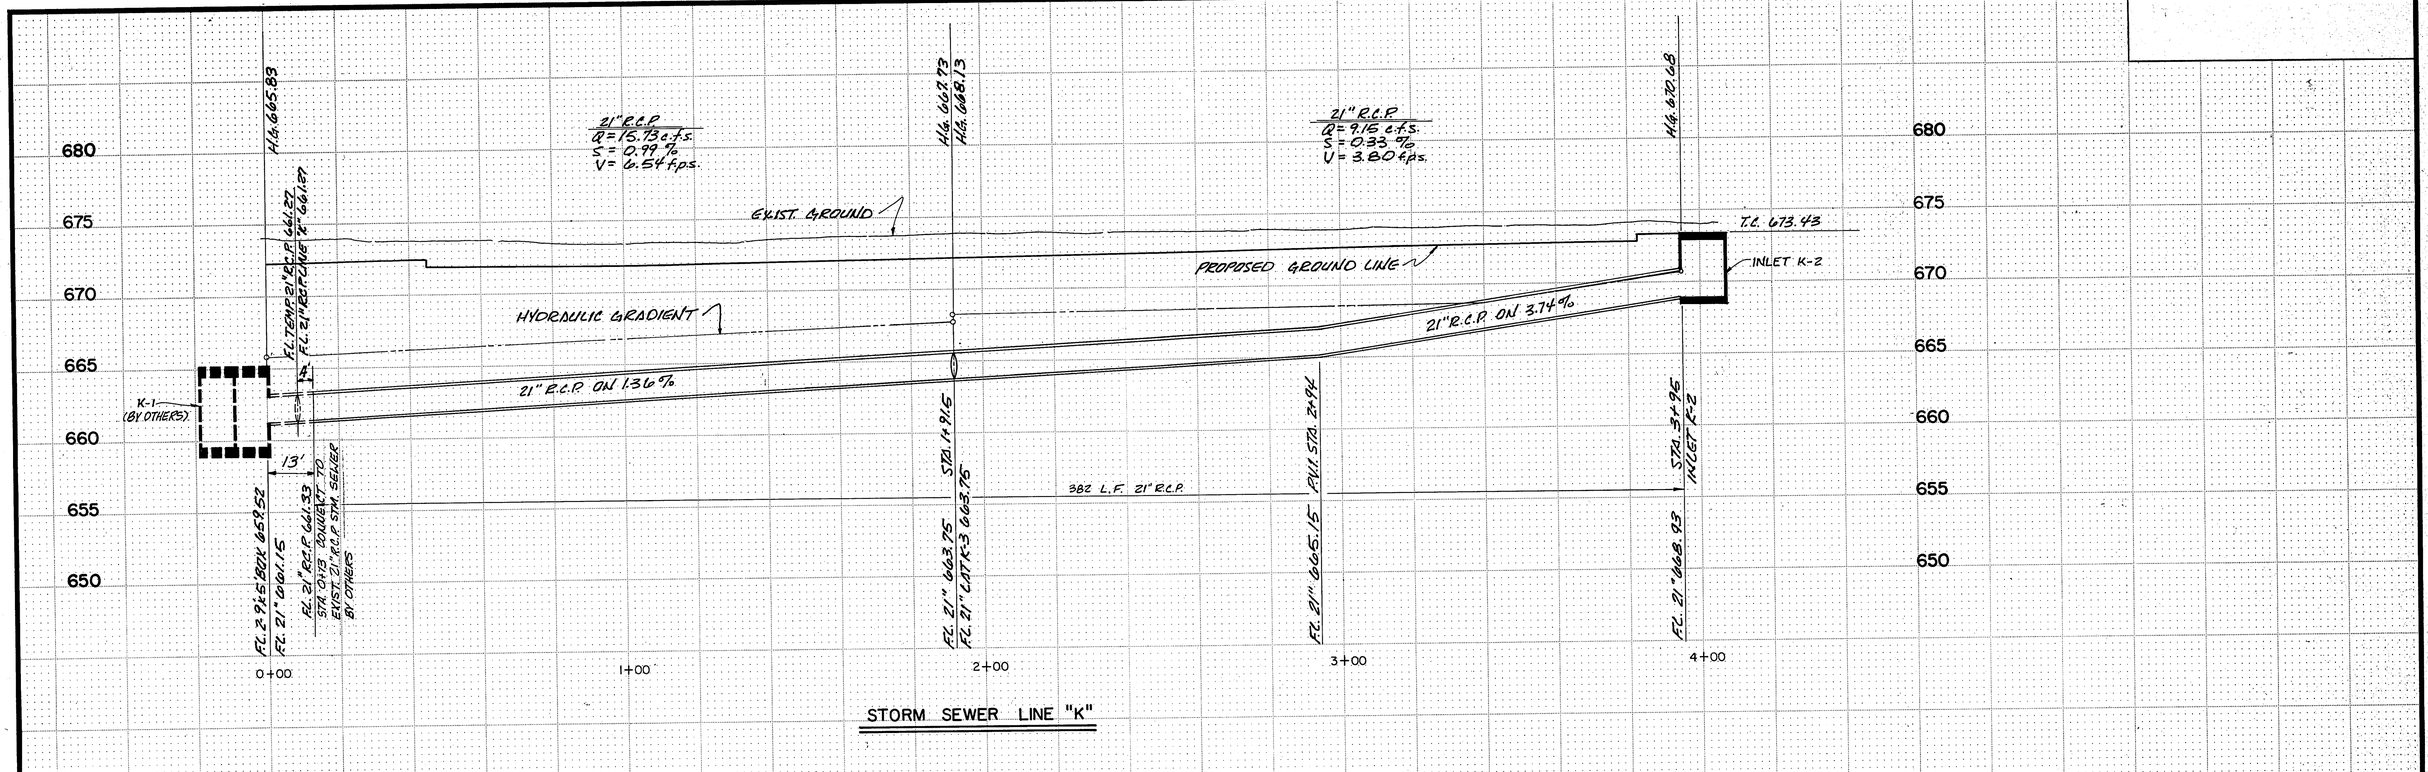

STORM SEWER LINE "K"

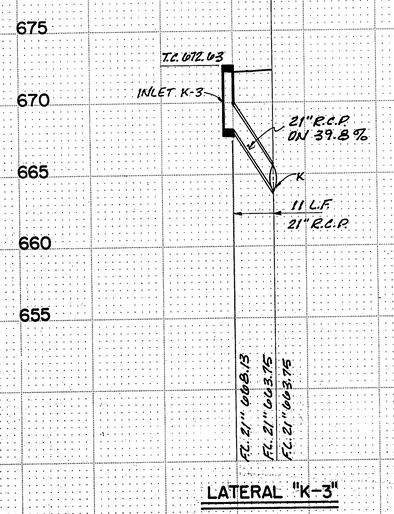

LATERAL "K-3"

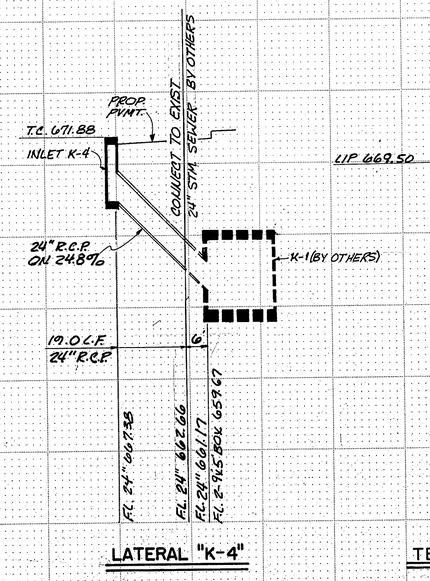

LATERAL "K-4"

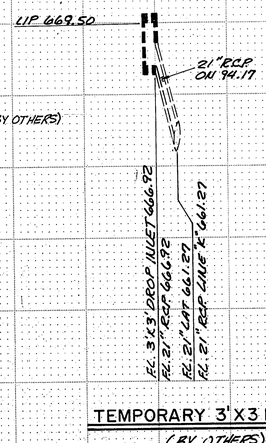

TEMPORARY 3'X3 DROP INLET

(BY OTHERS)*

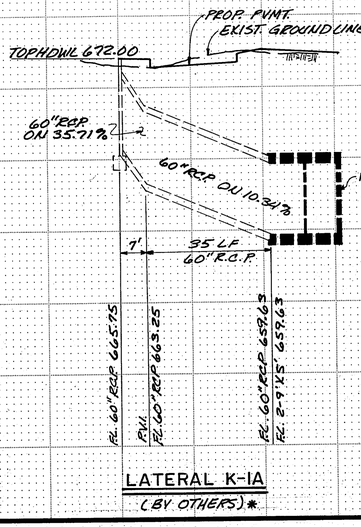

LATERAL K-1A

(BY OTHERS)*

* FOR INFORMATION ONLY. QUANTITIES NOT INCLUDED IN THIS CONTRACT.

NOTE: FOR CLASS OF PIPE SEE SHEET NO. 43

STORM SEWER LINE "K"
LATERAL "K-3"
LATERAL "K-4"

NO.	REVISION	BY	DATE

TEXAS TURNPIKE AUTHORITY
DALLAS NORTH TOLLWAY

STORM SEWER PROFILE

SHIMEK, JACOBS & FINKLEA
CONSULTING ENGINEERS — DALLAS, TEXAS

MADE	M.A.	DATE 7-83	TRACED	S.E.Y.	DATE 7-83
CHECKED	E.W.H.	DATE 7-83	SCALE	1"=20' HOR., 1"=5' VERT.	

CONTRACT NO. DNT 116 SHEET 58 OF 96

AS BUILT PLANS