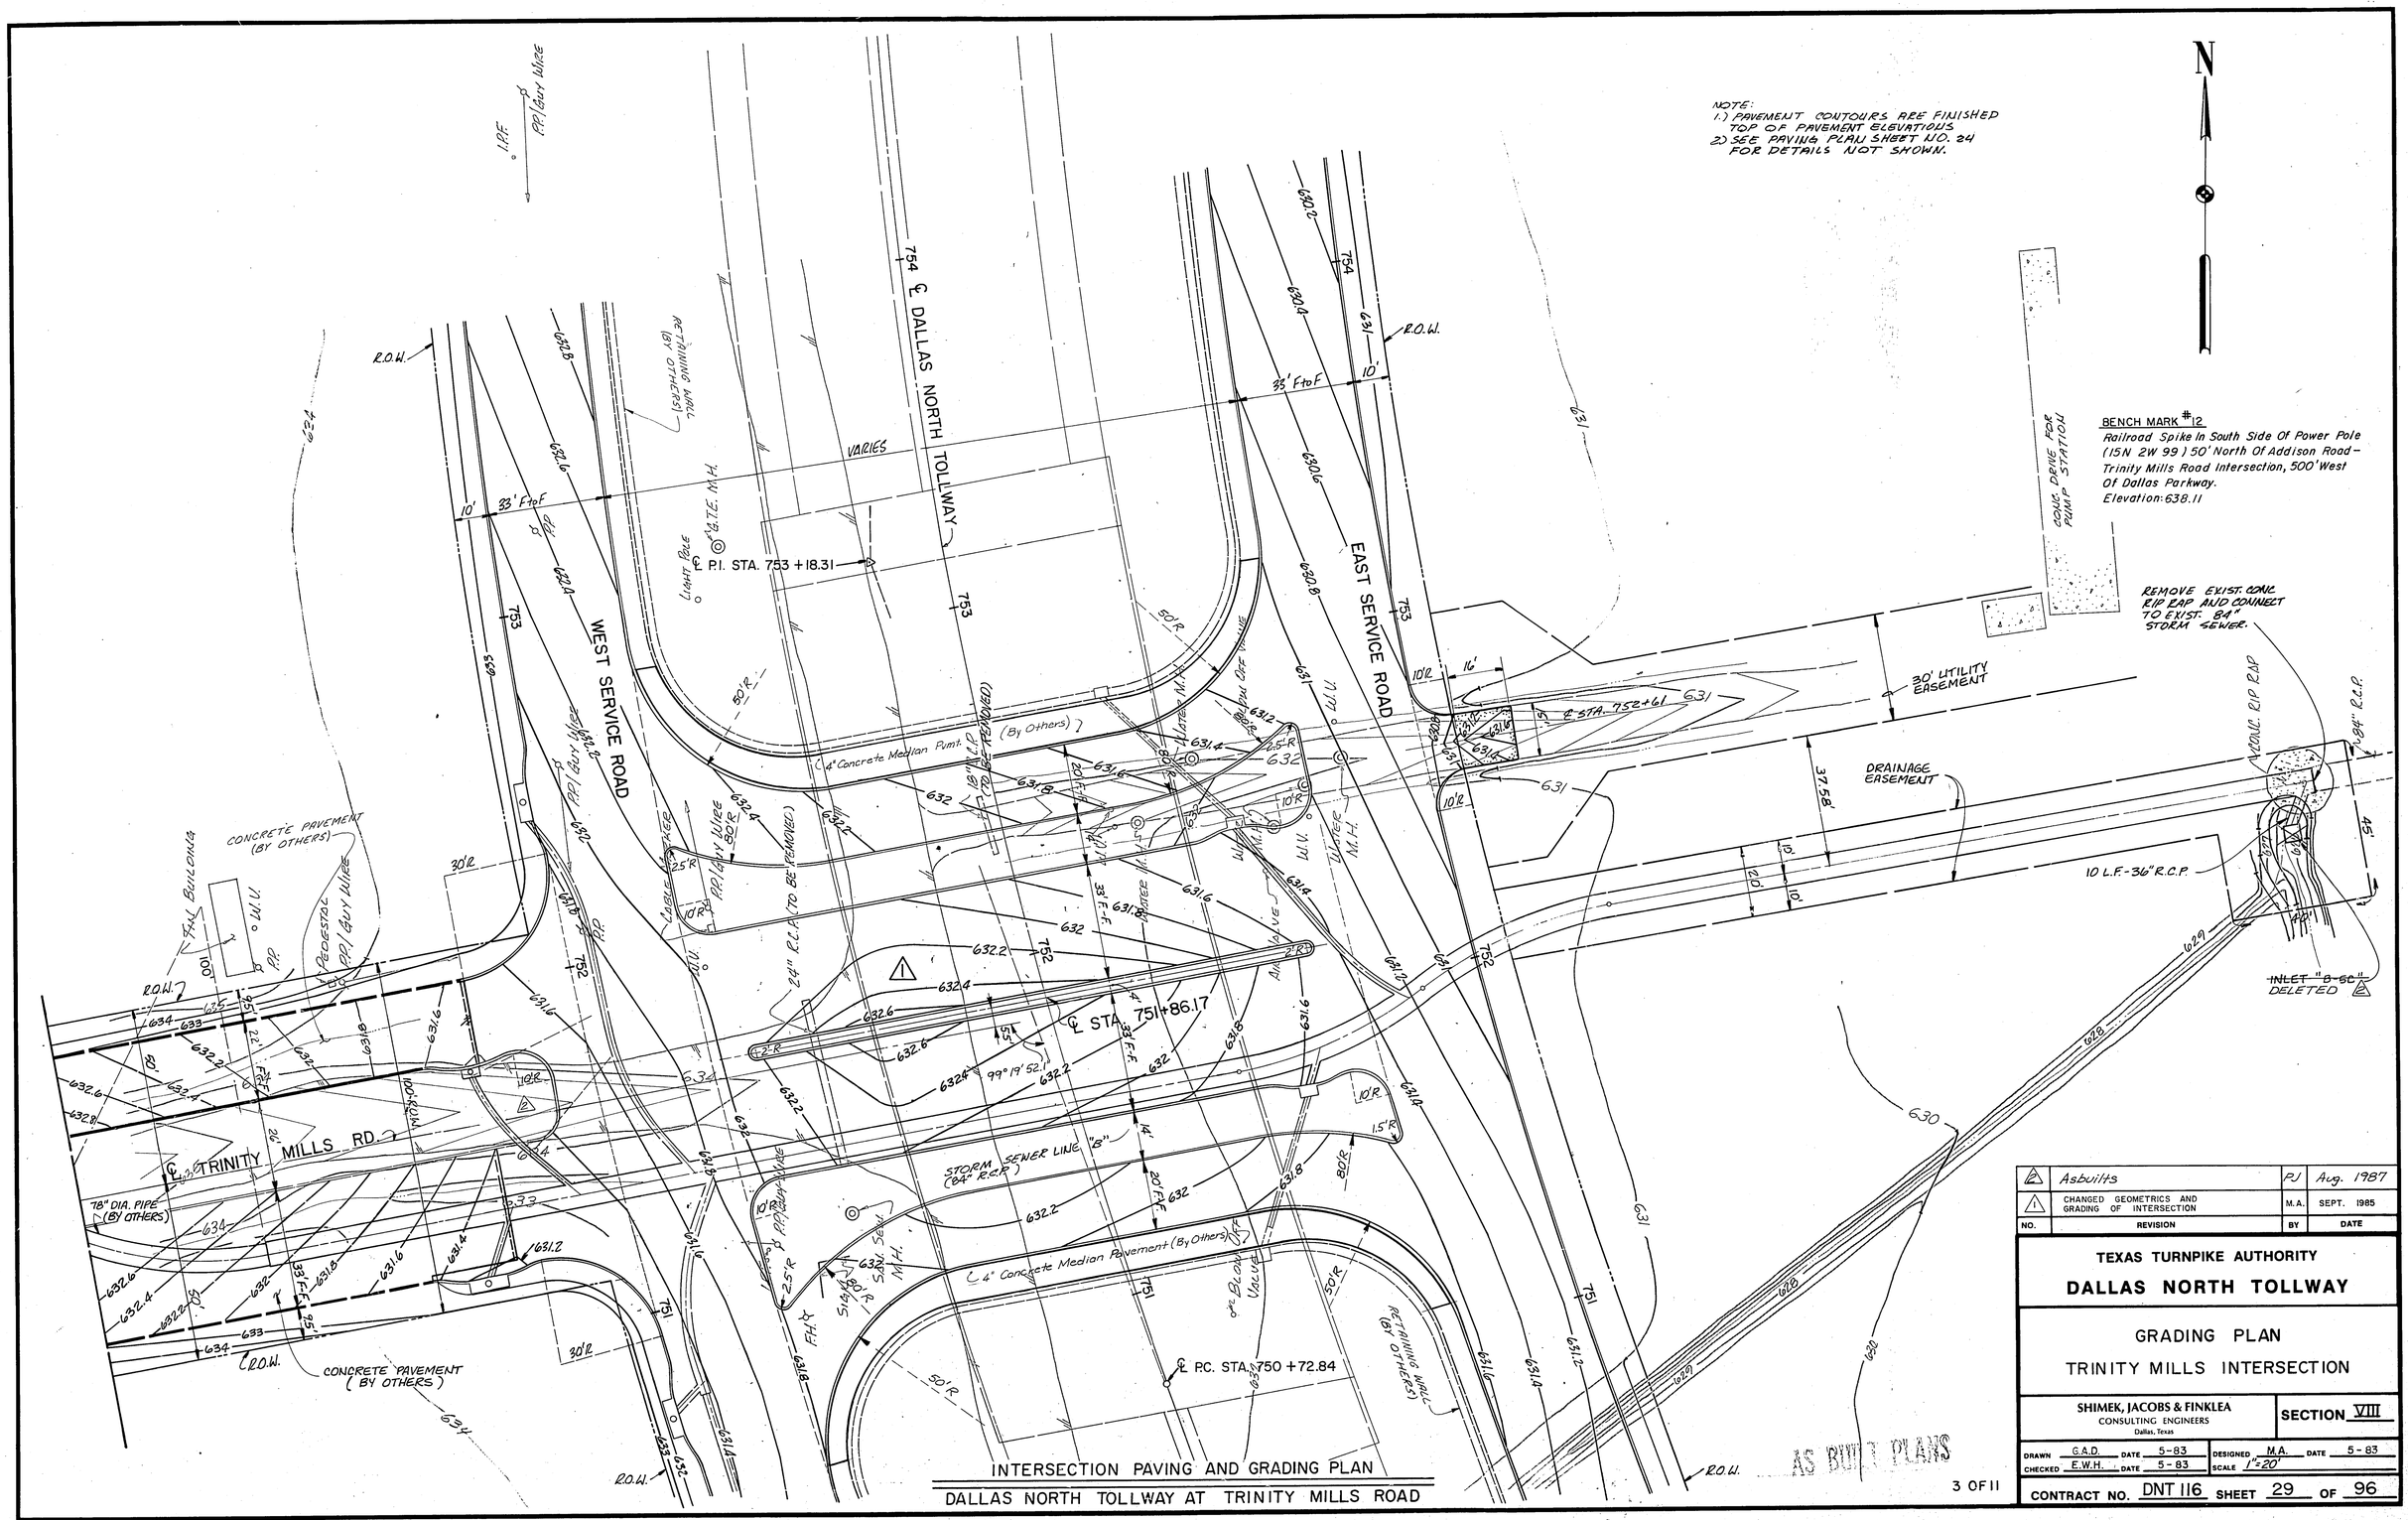

INTERSECTION PAVING AND GRADING PLAN

DALLAS NORTH TOLLWAY AT TRINITY MILLS ROAD

AS BUILT PLANS

3 OF 11

NO.	REVISION	BY	DATE
2	Asbuilts	PJ	Aug. 1987
1	CHANGED GEOMETRICS AND GRADING OF INTERSECTION	M.A.	SEPT. 1985

TEXAS TURNPIKE AUTHORITY

DALLAS NORTH TOLLWAY

GRADING PLAN

TRINITY MILLS INTERSECTION

SHIMEK, JACOBS & FINKLEA
CONSULTING ENGINEERS
Dallas, Texas

SECTION VIII

DRAWN G.A.D. DATE 5-83 DESIGNED M.A. DATE 5-83
CHECKED E.W.H. DATE 5-83 SCALE 1"=20'

CONTRACT NO. DNT 116 SHEET 29 OF 96