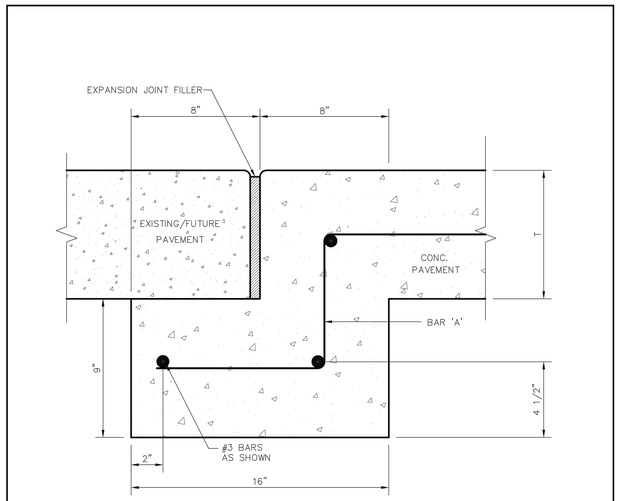

NOTES:

1. PAVEMENT BARS TO BE BENT DOWN INTO HEADER.
2. HEADER AND PAVEMENT TO BE MONOLITHIC.

T=PAVEMENT THICKNESS

STREET HEADER

NTS

Addison! PUBLIC WORKS DEPARTMENT	STREET HEADER	STANDARD CONSTRUCTION DETAILS PAVING	
		DATE: AUGUST, 2010	REV DATE: –	SHEET : SD-P15

Version 4/19/12

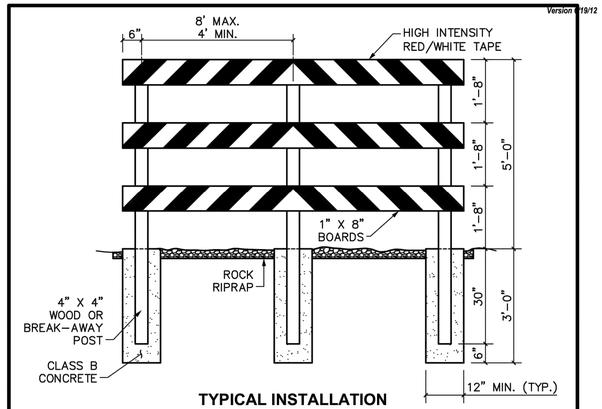

TYPICAL INSTALLATION

NOTES:

1. ALL BARRICADES SHALL BE IN ACCORDANCE WITH THE LATEST REVISION OF THE TEXAS MANUAL ON UNIFORM TRAFFIC CONTROL DEVICES (TMUTCD) AND THE STANDARD HIGHWAY SIGN DESIGNS FOR TEXAS (SHSD).
2. BARRICADE MUST COVER ENTIRE WIDTH OF PAVED ROADWAY OR FIRELANE SURFACE.
3. ALL 1" X 8" AND 4" X 4" WOOD POSTS MUST BE PAINTED WHITE.
4. BARRICADES SHALL BE DESIGNED AND CONSTRUCTED TO THE STANDARDS OF THE COMPLIANT WORK ZONE TRAFFIC CONTROL DEVICE LIST.
5. BARRICADE STRIPING MATERIAL SHALL BE RED AND WHITE HIGH INTENSITY REFLECTIVE SHEETING.
6. DIAGONAL STRIPING SHALL BE PLACED IN A MANNER THAT DIRECTS TRAFFIC IN THE APPROPRIATE DIRECTION OF TRAVEL.
7. PROPOSED BARRICADE STRIPING SHALL BE APPROVED BY THE CITY PRIOR TO PLACEMENT OF BARRICADE.

ROAD CLOSURE BARRICADE

CITY OF DALLAS FILE NO: 311T-9310

Stantec
TBPE # F-6324
TBPLS # 10194229
12222 Merit Drive, Suite 400
Dallas TX
www.stantec.com

The Contractor shall verify and be responsible for all dimensions. DO NOT scale the drawing - any errors or omissions shall be reported to Stantec without delay.
The Copyrights to all designs and drawings are the property of Stantec. Reproduction or use for any purpose other than that authorized by Stantec is forbidden.

Revision	By	Appd.	YY.MM.DD
1 LANDMARK EXTENSION	JDB	JAM	18.02.08
1 RFI 033	JDB	JAM	17.08.01
1 SANITARY SEWER REVISIONS	JDB	JAM	17.07.27
1 WCPR #03 - HUB CITY RESPONSES	JDB	JAM	17.06.29
1 WCPR #02 - GARAGE UPDATES	JDB	JAM	17.06.28

Issued

PROJECT RECORD

To the best of North Texas Contracting, Inc. belief and knowledge the as-built conditions shown on this drawing constitute an accurate and complete depiction of the manner in which this portion of the work was actually installed.

North Texas Contracting, Inc.
7/16/18
Carson Collier, Project Manager

Client/Project
CAWLEY PARTNERS

Cowley - Fourteen555
14555 DALLAS PARKWAY
TOWN OF ADDISON, DALLAS COUNTY, TEXAS

Title
TOWN OF ADDISON PUBLIC STREET DETAILS

Permit-Seal

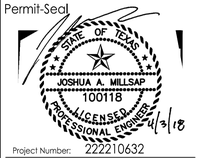

Project Number: 222210632
File Name: 10632pvp.dwg

Dwn.	Chkd.	Dsgn.	YY.MM.DD
JDB	JAM	JAM	18.03.19

Drawing No. C6.3

Revision	Sheet
----	C6.3

V:\2222\active\222210632\civil\dwg\sheet\10632PVP.dwg
2018.04.16 8:24 AM By: Bacon, Jeff

ORIGINAL SHEET - ANSI D