DISCLAIMER:
The use of this standard is governed by the "Texas Engineering Practice Act". No warranty of any kind is made by TxDOT for any purpose whatsoever. TxDOT assumes no responsibility for the conversion of this standard to other formats or for incorrect results or damages resulting from its use.

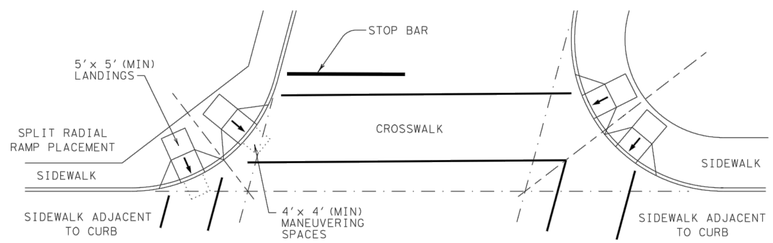

SKEWED INTERSECTION WITH "LARGE" RADIUS

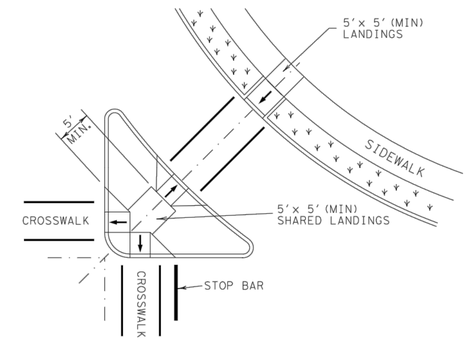

AT INTERSECTION
W/FREE RIGHT TURN & ISLAND

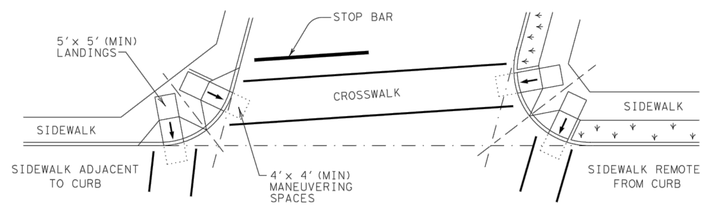

SKEWED INTERSECTION WITH "SMALL" RADIUS

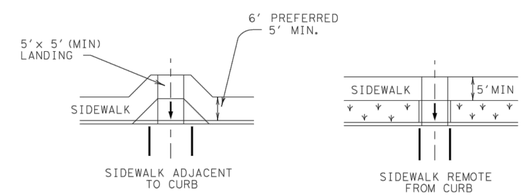

MID-BLOCK PLACEMENT
PERPENDICULAR RAMPS

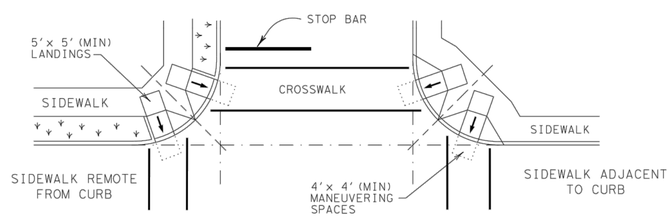

NORMAL INTERSECTION WITH "SMALL" RADIUS

TYPICAL CROSSING LAYOUTS

SHEET 4 OF 4

Texas Department of Transportation — Design Division Standard

PEDESTRIAN FACILITIES CURB RAMPS

PED-12A

FILE: ped12a.dgn	DN: TxDOT	CK: RM	DW: TxDOT	CK: VP	
© TxDOT March 2002	CONT	SECT	JOB	HIGHWAY	
REVISIONS					
VP June 13, 2012	DIST		COUNTY		SHEET NO.

DATE:
FILE:

CITY OF DALLAS FILE NO: 311T-9310

V:\2222\active\222210632\civil\cad\sheet\10632PVP.dwg
2018/04/16 8:24 AM By: Bacon, Jeff

ORIGINAL SHEET - ANSI D

Stantec

TBPE # F-6324
TBPLS # 10194229

12222 Merit Drive, Suite 400
Dallas TX
www.stantec.com

The Contractor shall verify and be responsible for all dimensions. DO NOT scale the drawing - any errors or omissions shall be reported to Stantec without delay.
The Copyrights to all designs and drawings are the property of Stantec. Reproduction or use for any purpose other than that authorized by Stantec is forbidden.

Revision	By	Appd.	YY.MM.DD
1 LANDMARK EXTENSION	JDB	JAM	18.02.08
2 RFI 033	JDB	JAM	17.08.01
3 SANITARY SEWER REVISIONS	JDB	JAM	17.07.27
4 W/CR# #03 - HUB CITY RESPONSES	JDB	JAM	17.06.29
5 W/CR# #02 - GARAGE UPDATES	JDB	JAM	17.06.28

Issued

PROJECT RECORD

To the best of North Texas Contracting, Inc. belief and knowledge the as-built conditions shown on this drawing constitute an accurate and complete depiction of the manner in which this portion of the work was actually installed.

North Texas Contracting, Inc.
7/16/18
Carson Collier, Project Manager

Client/Project
CAWLEY PARTNERS
Cowley - Fourteen555
14555 DALLAS PARKWAY
TOWN OF ADDISON, DALLAS COUNTY, TEXAS

Title
PED12-A (4)

Permit-Seal
STATE OF TEXAS
JOSHUA A. MILLSAP
100118
LICENSED
PROFESSIONAL ENGINEER
4/3/18

Project Number: 222210632
File Name: 10632pvp.dwg

JDB	JAM	JAM	18.03.19
Dwn.	Chkd.	Dsgn.	YY.MM.DD

Drawing No. C6.7

Revision	Sheet
----	C6.7