


mk	revisions	date
1	GENERAL REVISION	2-2-80
2	REVISED ST. SEW. SIZE	6-20-80

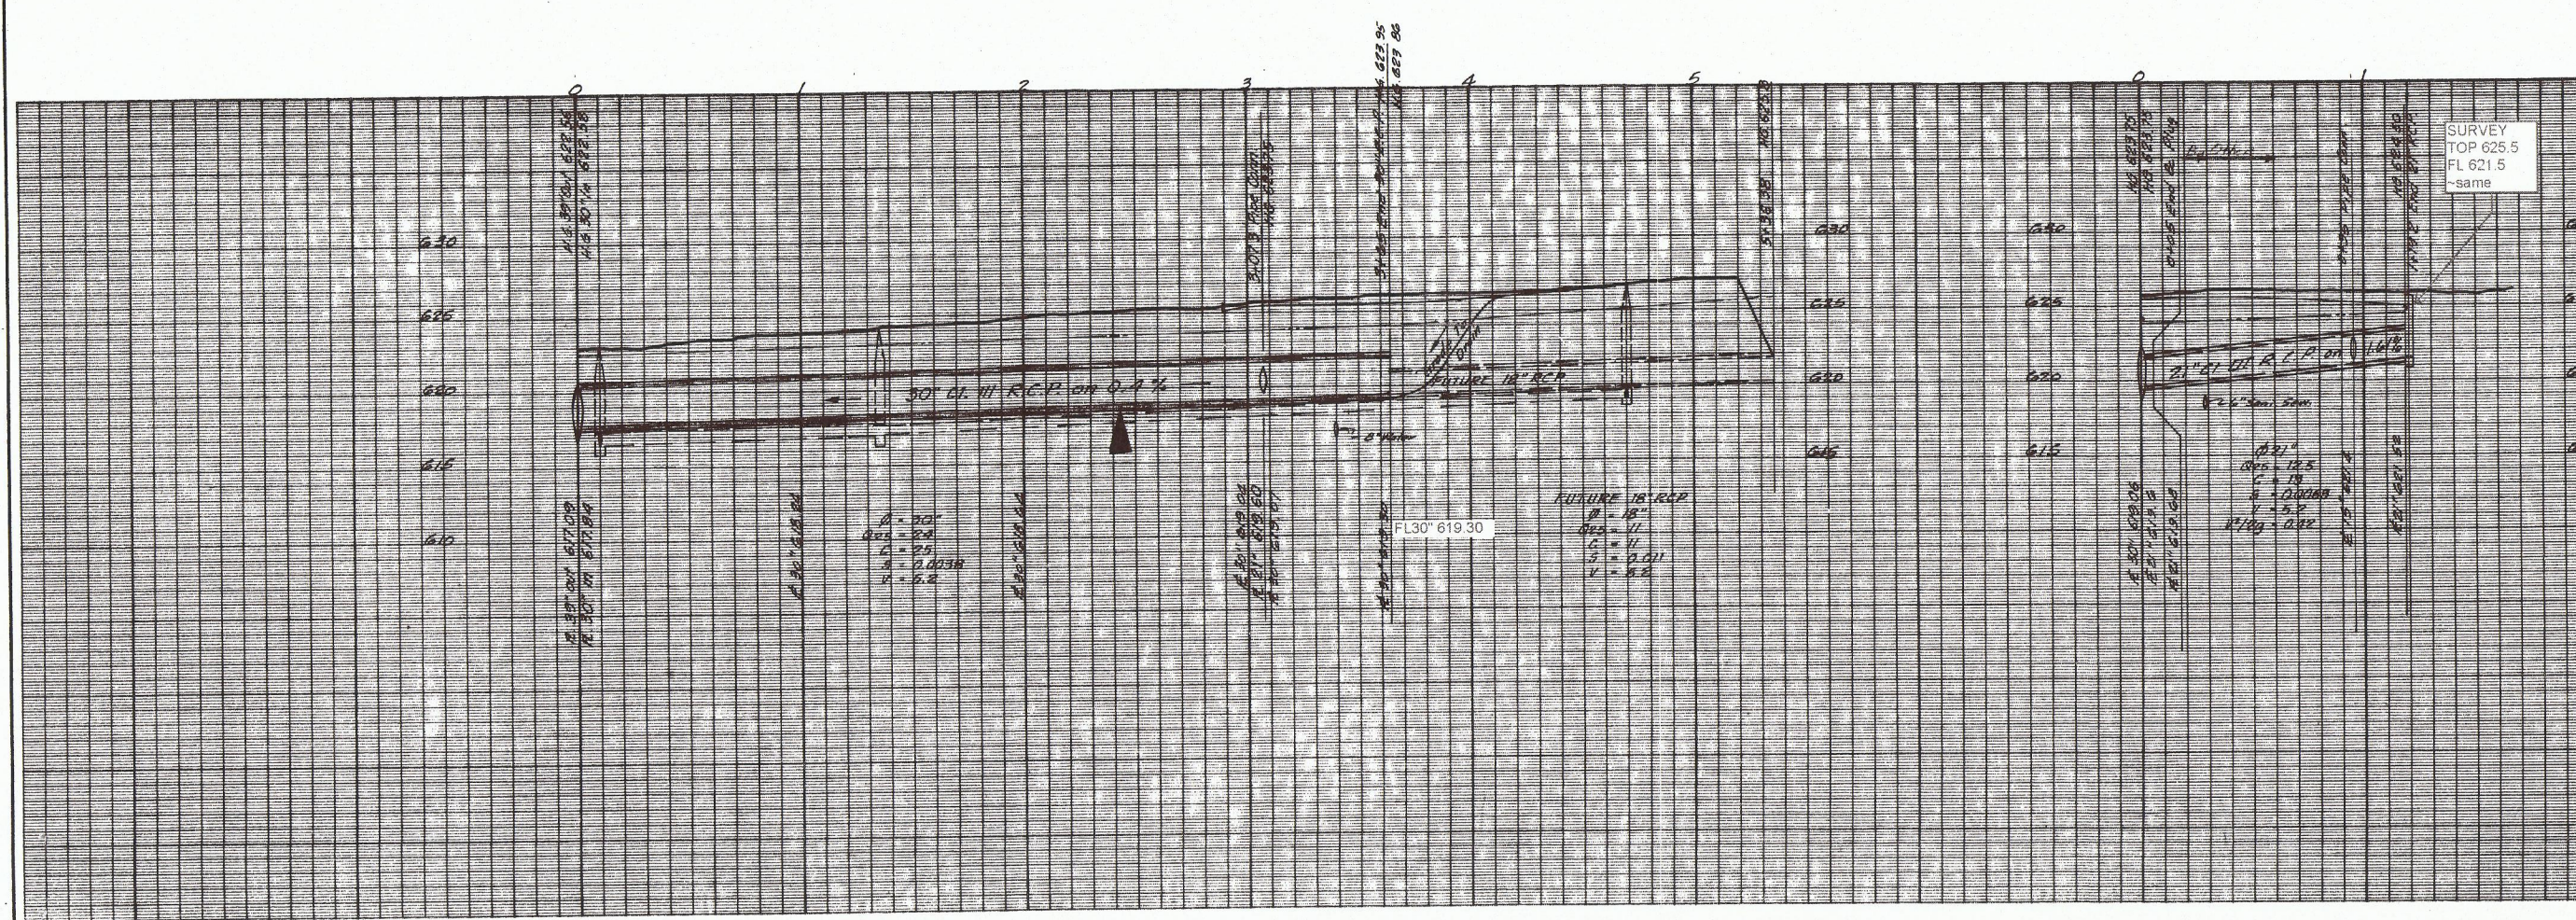

SURVEY  
 TOP 625.5  
 FL 621.5  
 -same




PLAN - PROFILE

**STORM SEWER**

**CRESTVIEW SQUARE**

**VANTAGE COMPANIES**

ALBERT H. HALFF ASSOCIATES, INC. - ENGINEERS


DESIGN	DRAWN	DATE	SCALE	NOTES	FILE	NO.
J.I.N.	VEENON	Nov 79	H: 1/8" = 1'-0" V: 1/4" = 1'-0"	6514	VW-1	55-3