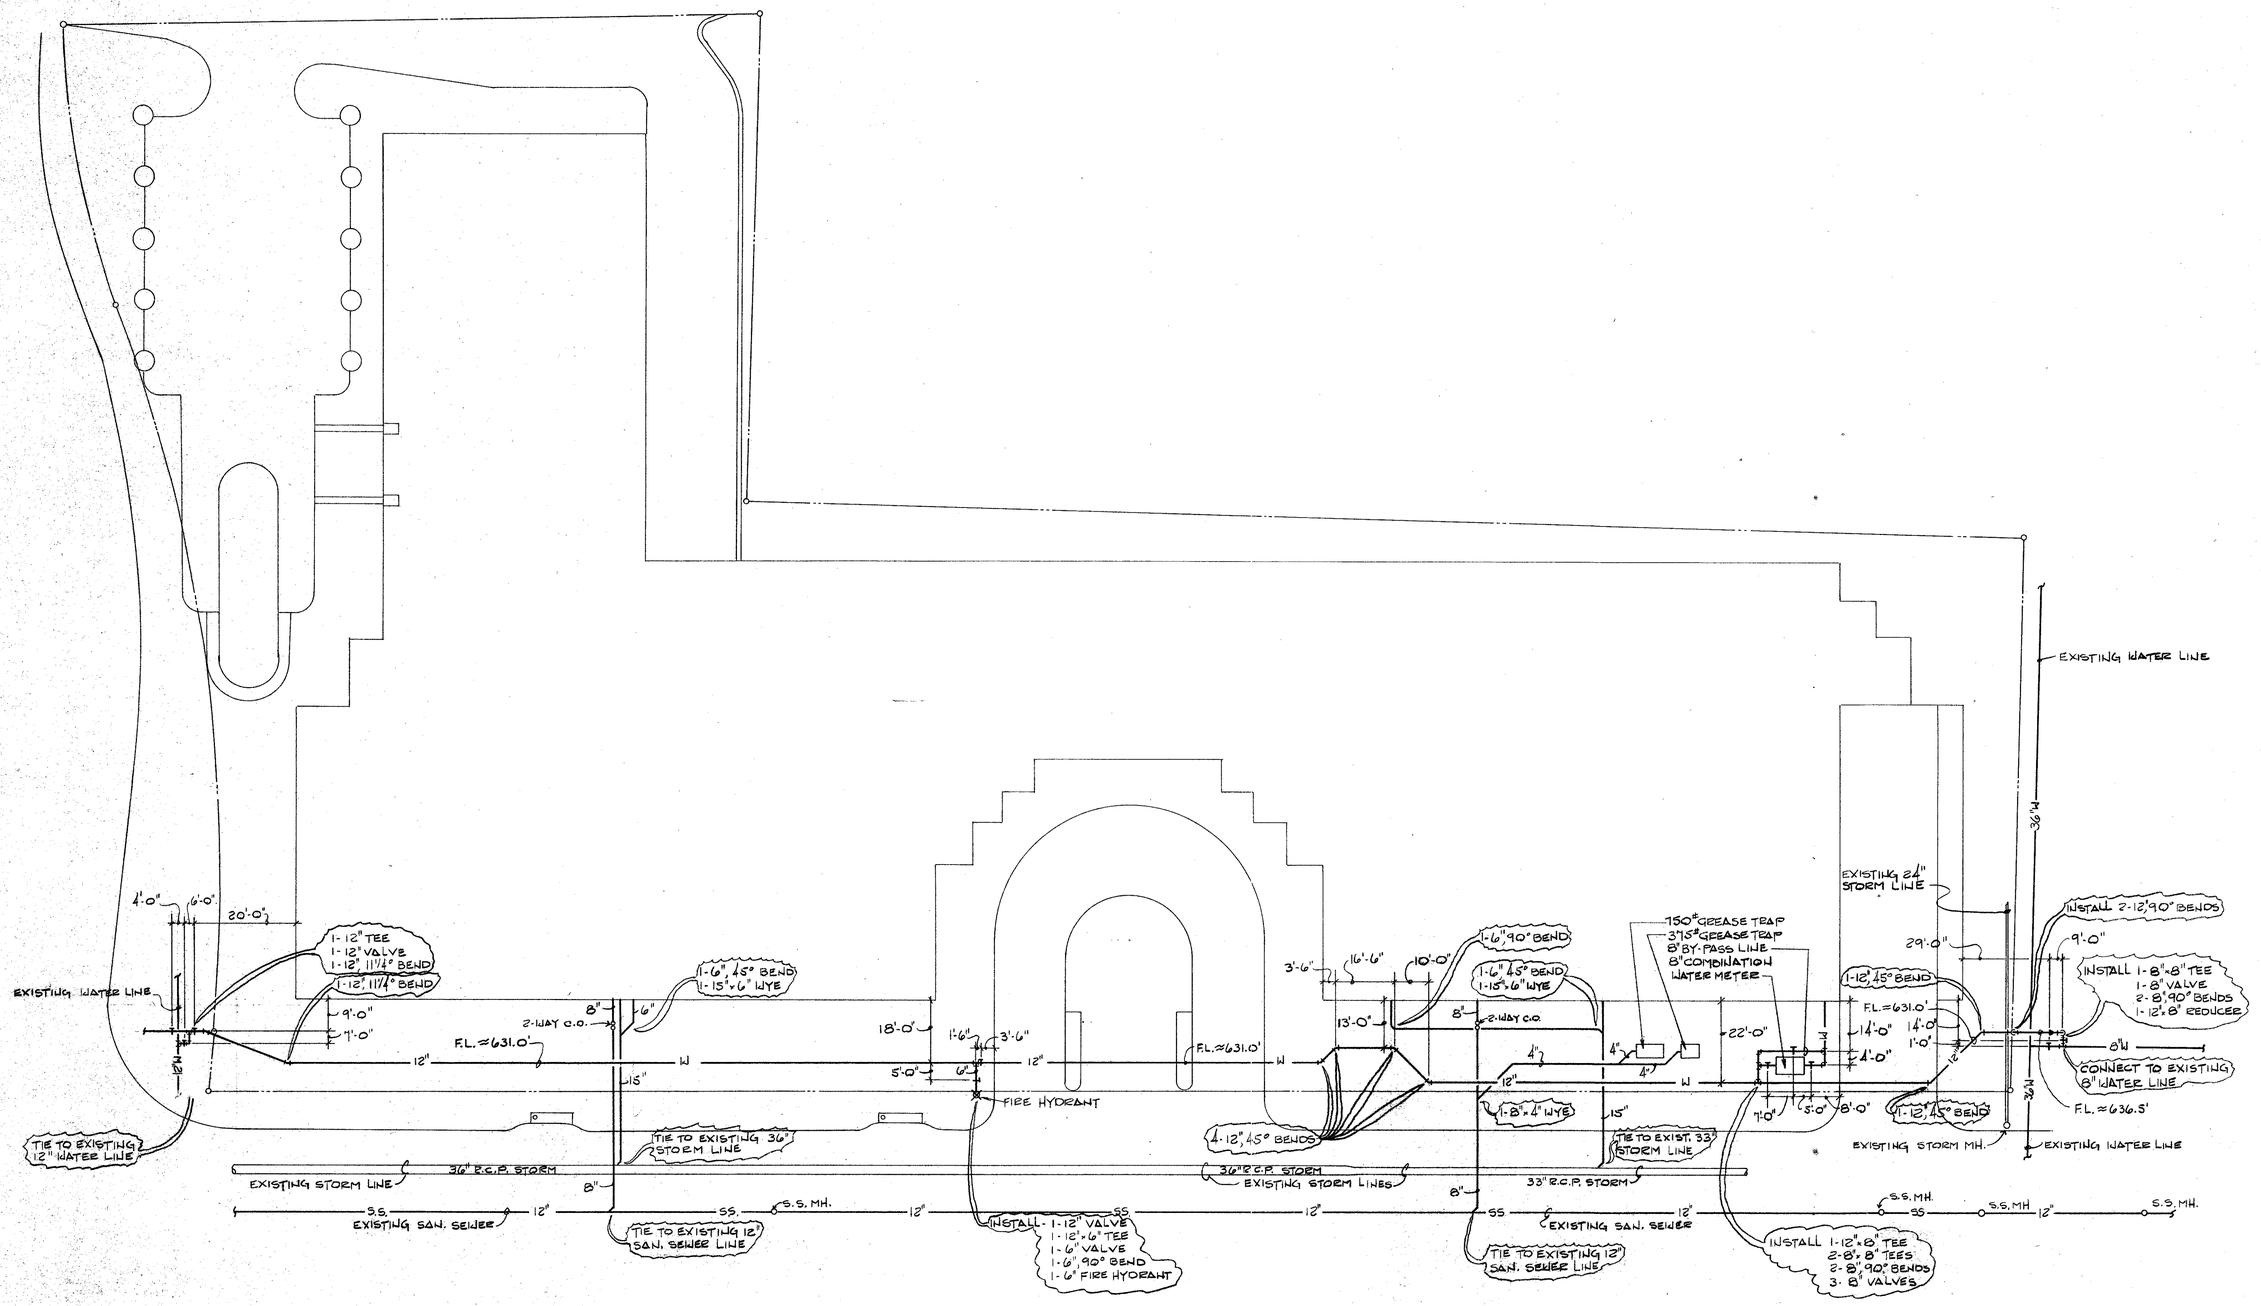

SITE PLAN

SCALE: 1"=20'-0"

No.	Date	By	Revision

No.	Date	By	Issue

SITE AS-BUILT PLAN

ABERDEEN

TEXAS

MILTON B. LEVY & SON PLUMBING, INC.

11024 Indian Trail Dallas, Tx. (214) 241-8503 ADDISON

Designer

Drafter

Approved

Scale 1"=20'-0"

Date 4-7-86

Rev. No.

Sheet 1 of 1

C-1