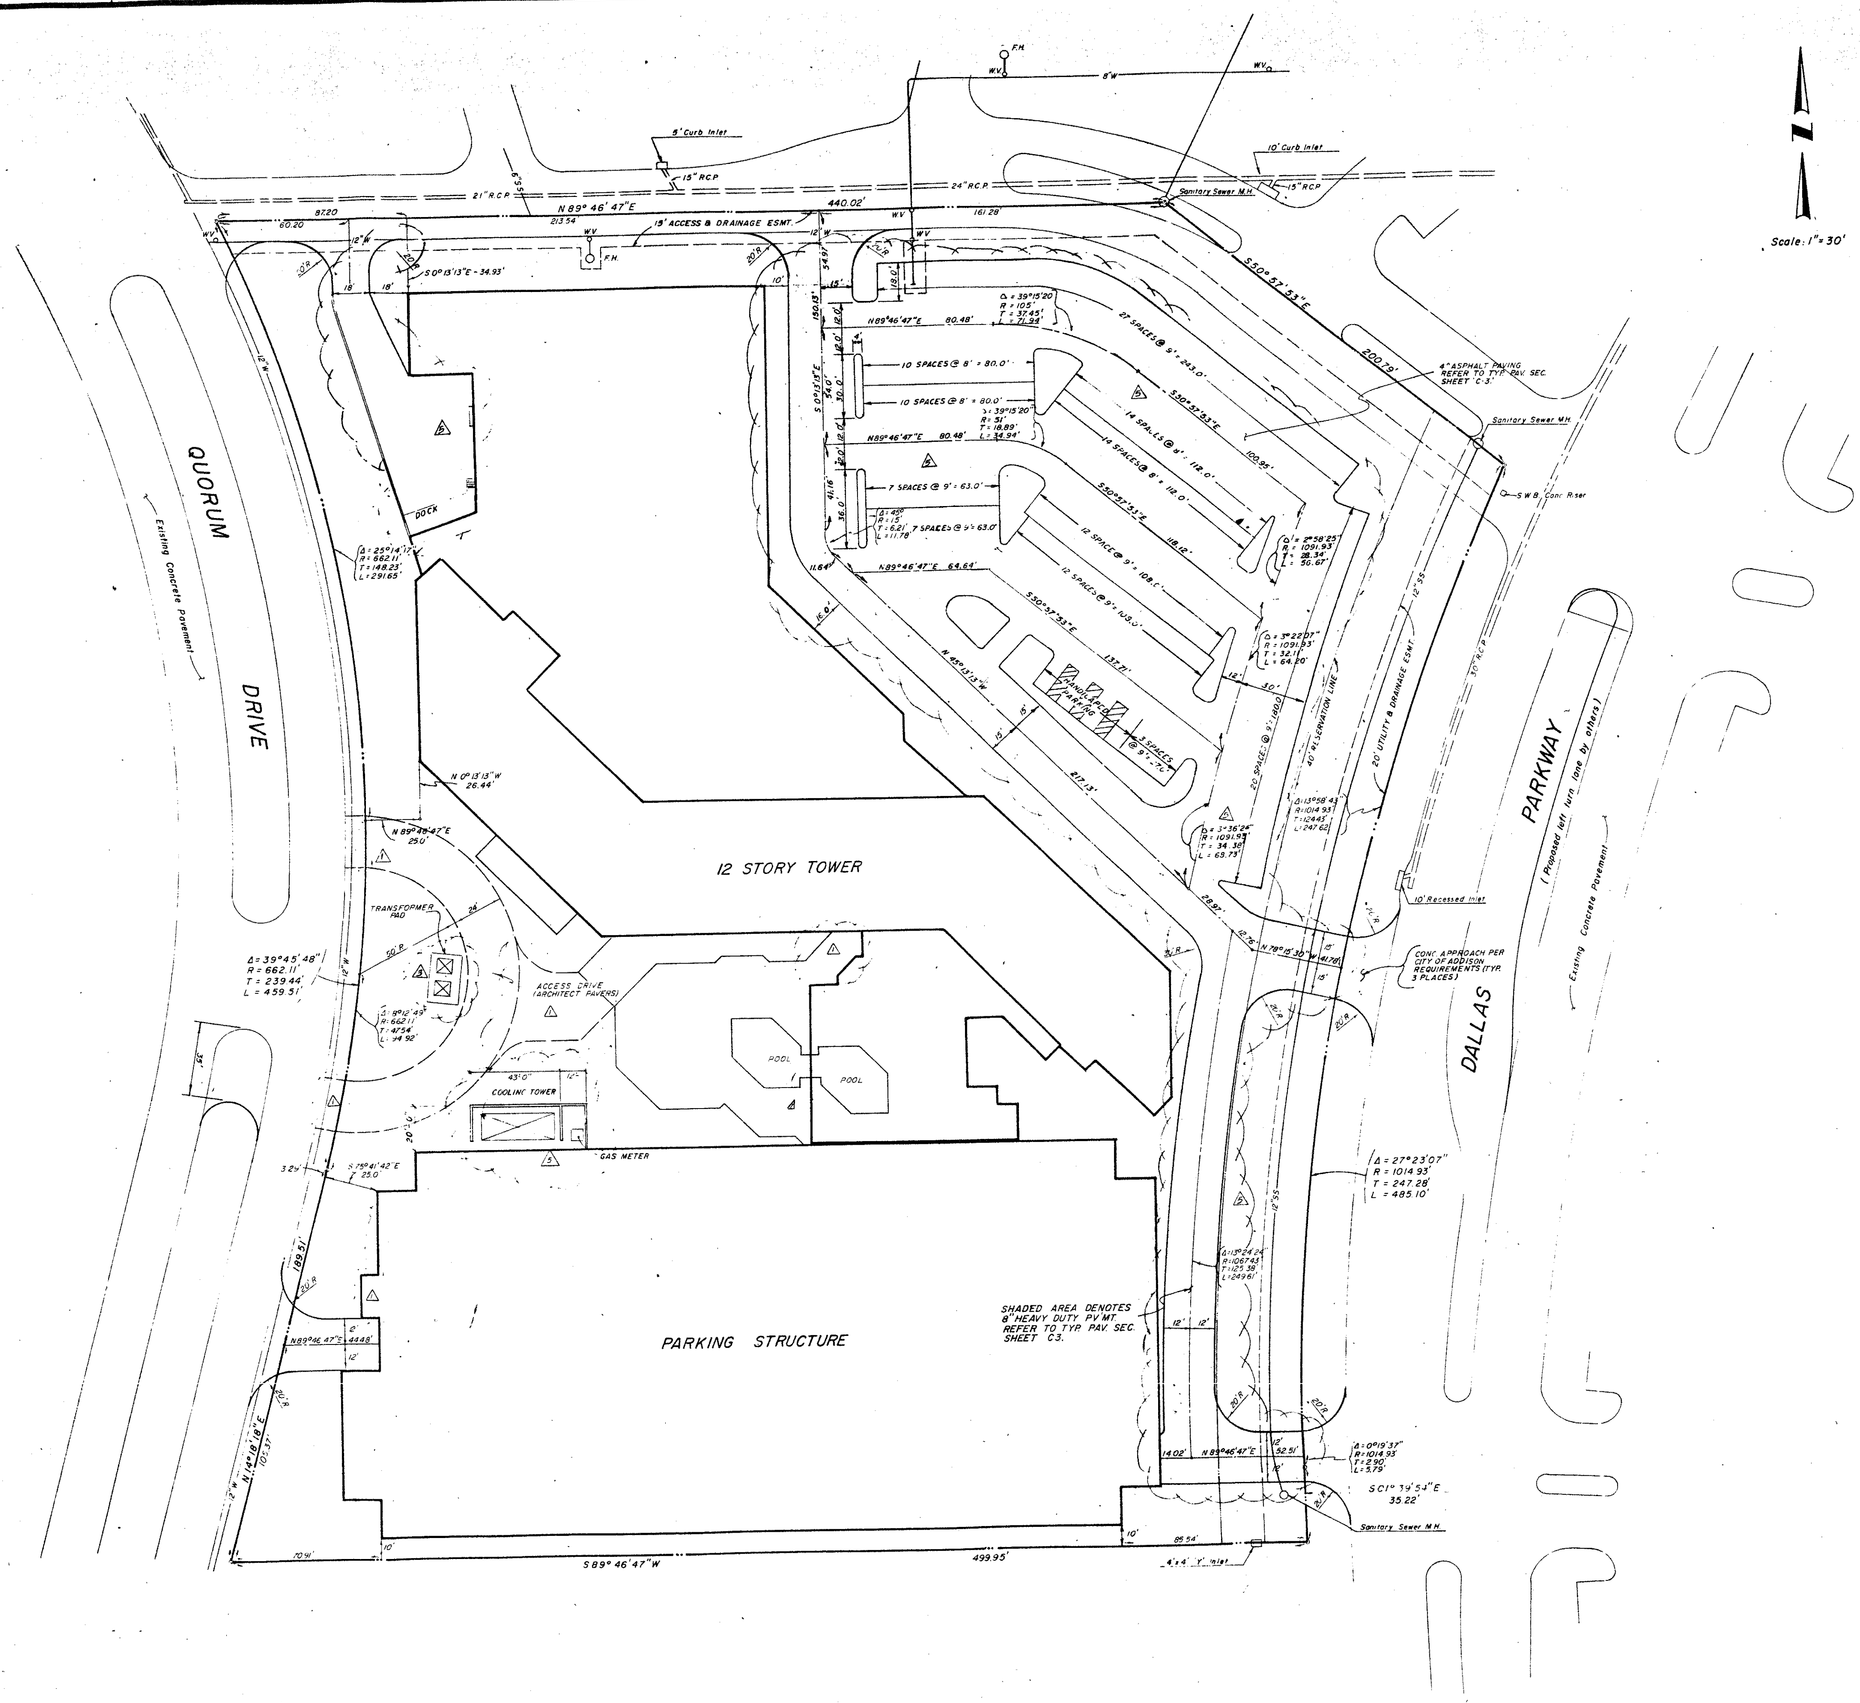

Bogard Haldeman Miller

Bogard Haldeman Miller, Inc.
Architects and
Planning Consultants
5710 L.B.J. Fwy.
Suite 130
Dallas, Texas 75240
214-233-7232.

Project: Marriott QUORUM V788 ADDISON, TEXAS

Title: HORIZONTAL CONTROL

Job Number:

Drawn By:

Checked By:

Revisions:

1	General Revisions 12/28/81
2	ALL Transformer Pad 8/4/81
3	General Revisions 10/19/81

Sheet C2 of sheets

Date: 8-4-81

BDD BROCKETTE / DAVIS / DRAKE, INC.
CONSULTING ENGINEERS
CIVIL STRUCTURAL SURVEYING
2828 ANNEX STREET DALLAS, TEXAS 75204