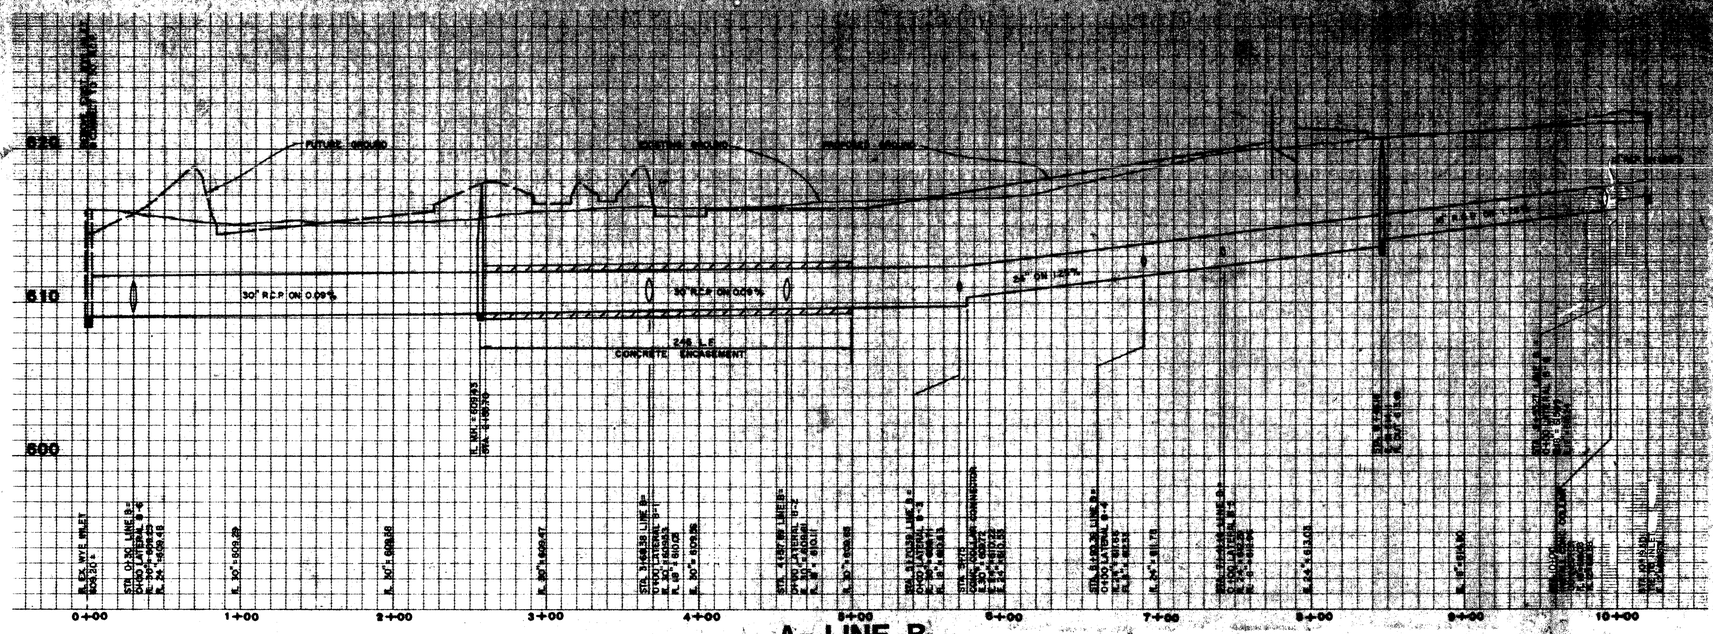

A- LINE B

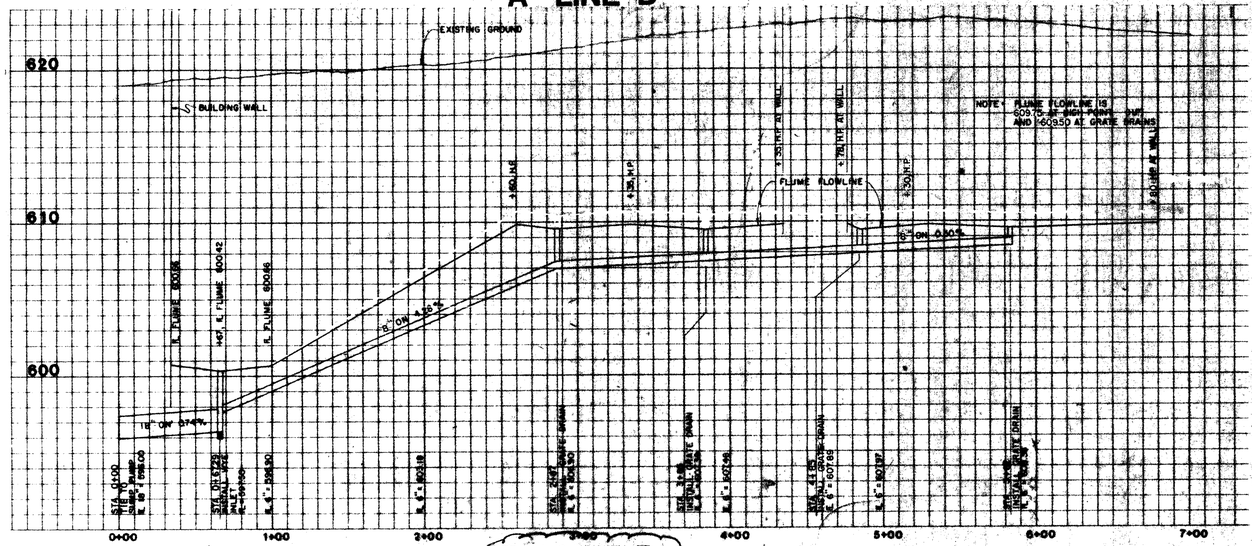

B - LINE E

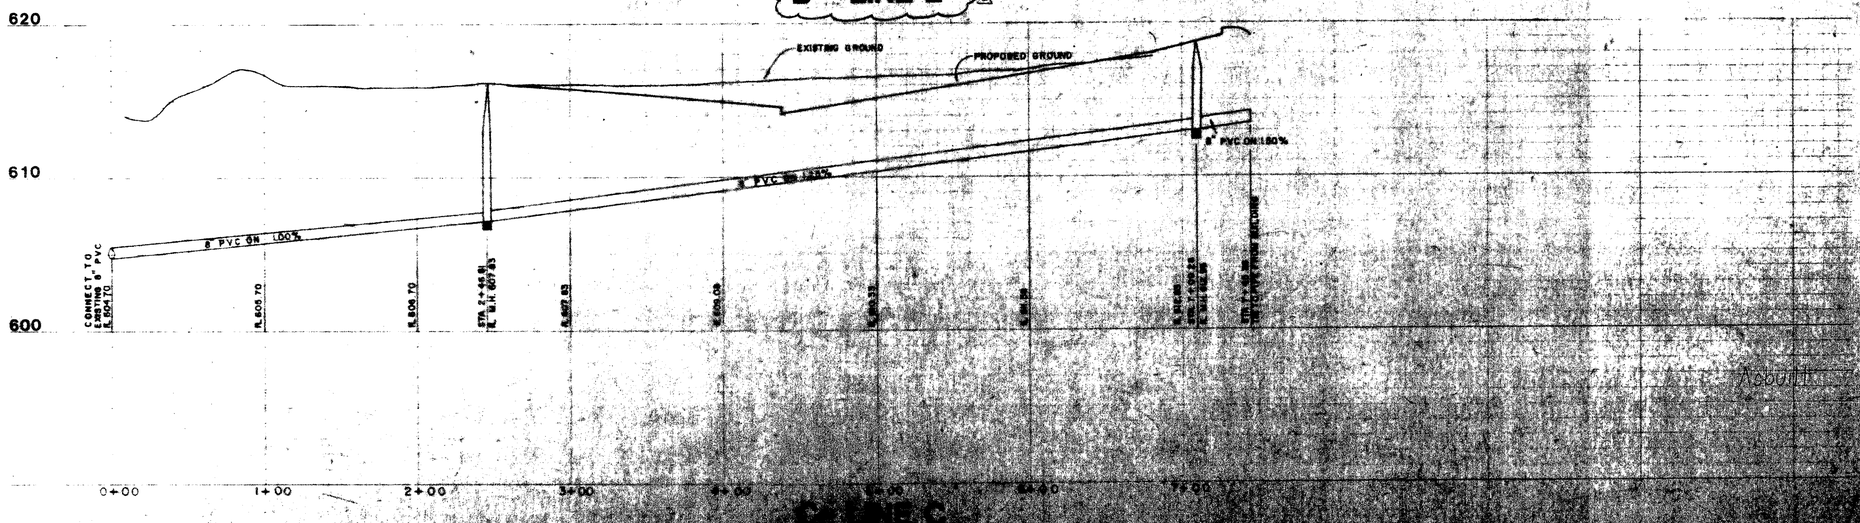

C- LINE C

Haldeman
Miller
Bregman
Hamann

project: M.E.P.C. QUORUM NORTH OFFICES
Phase One
Addison, Texas

title: UTILITY PROFILES

job no:
revisions