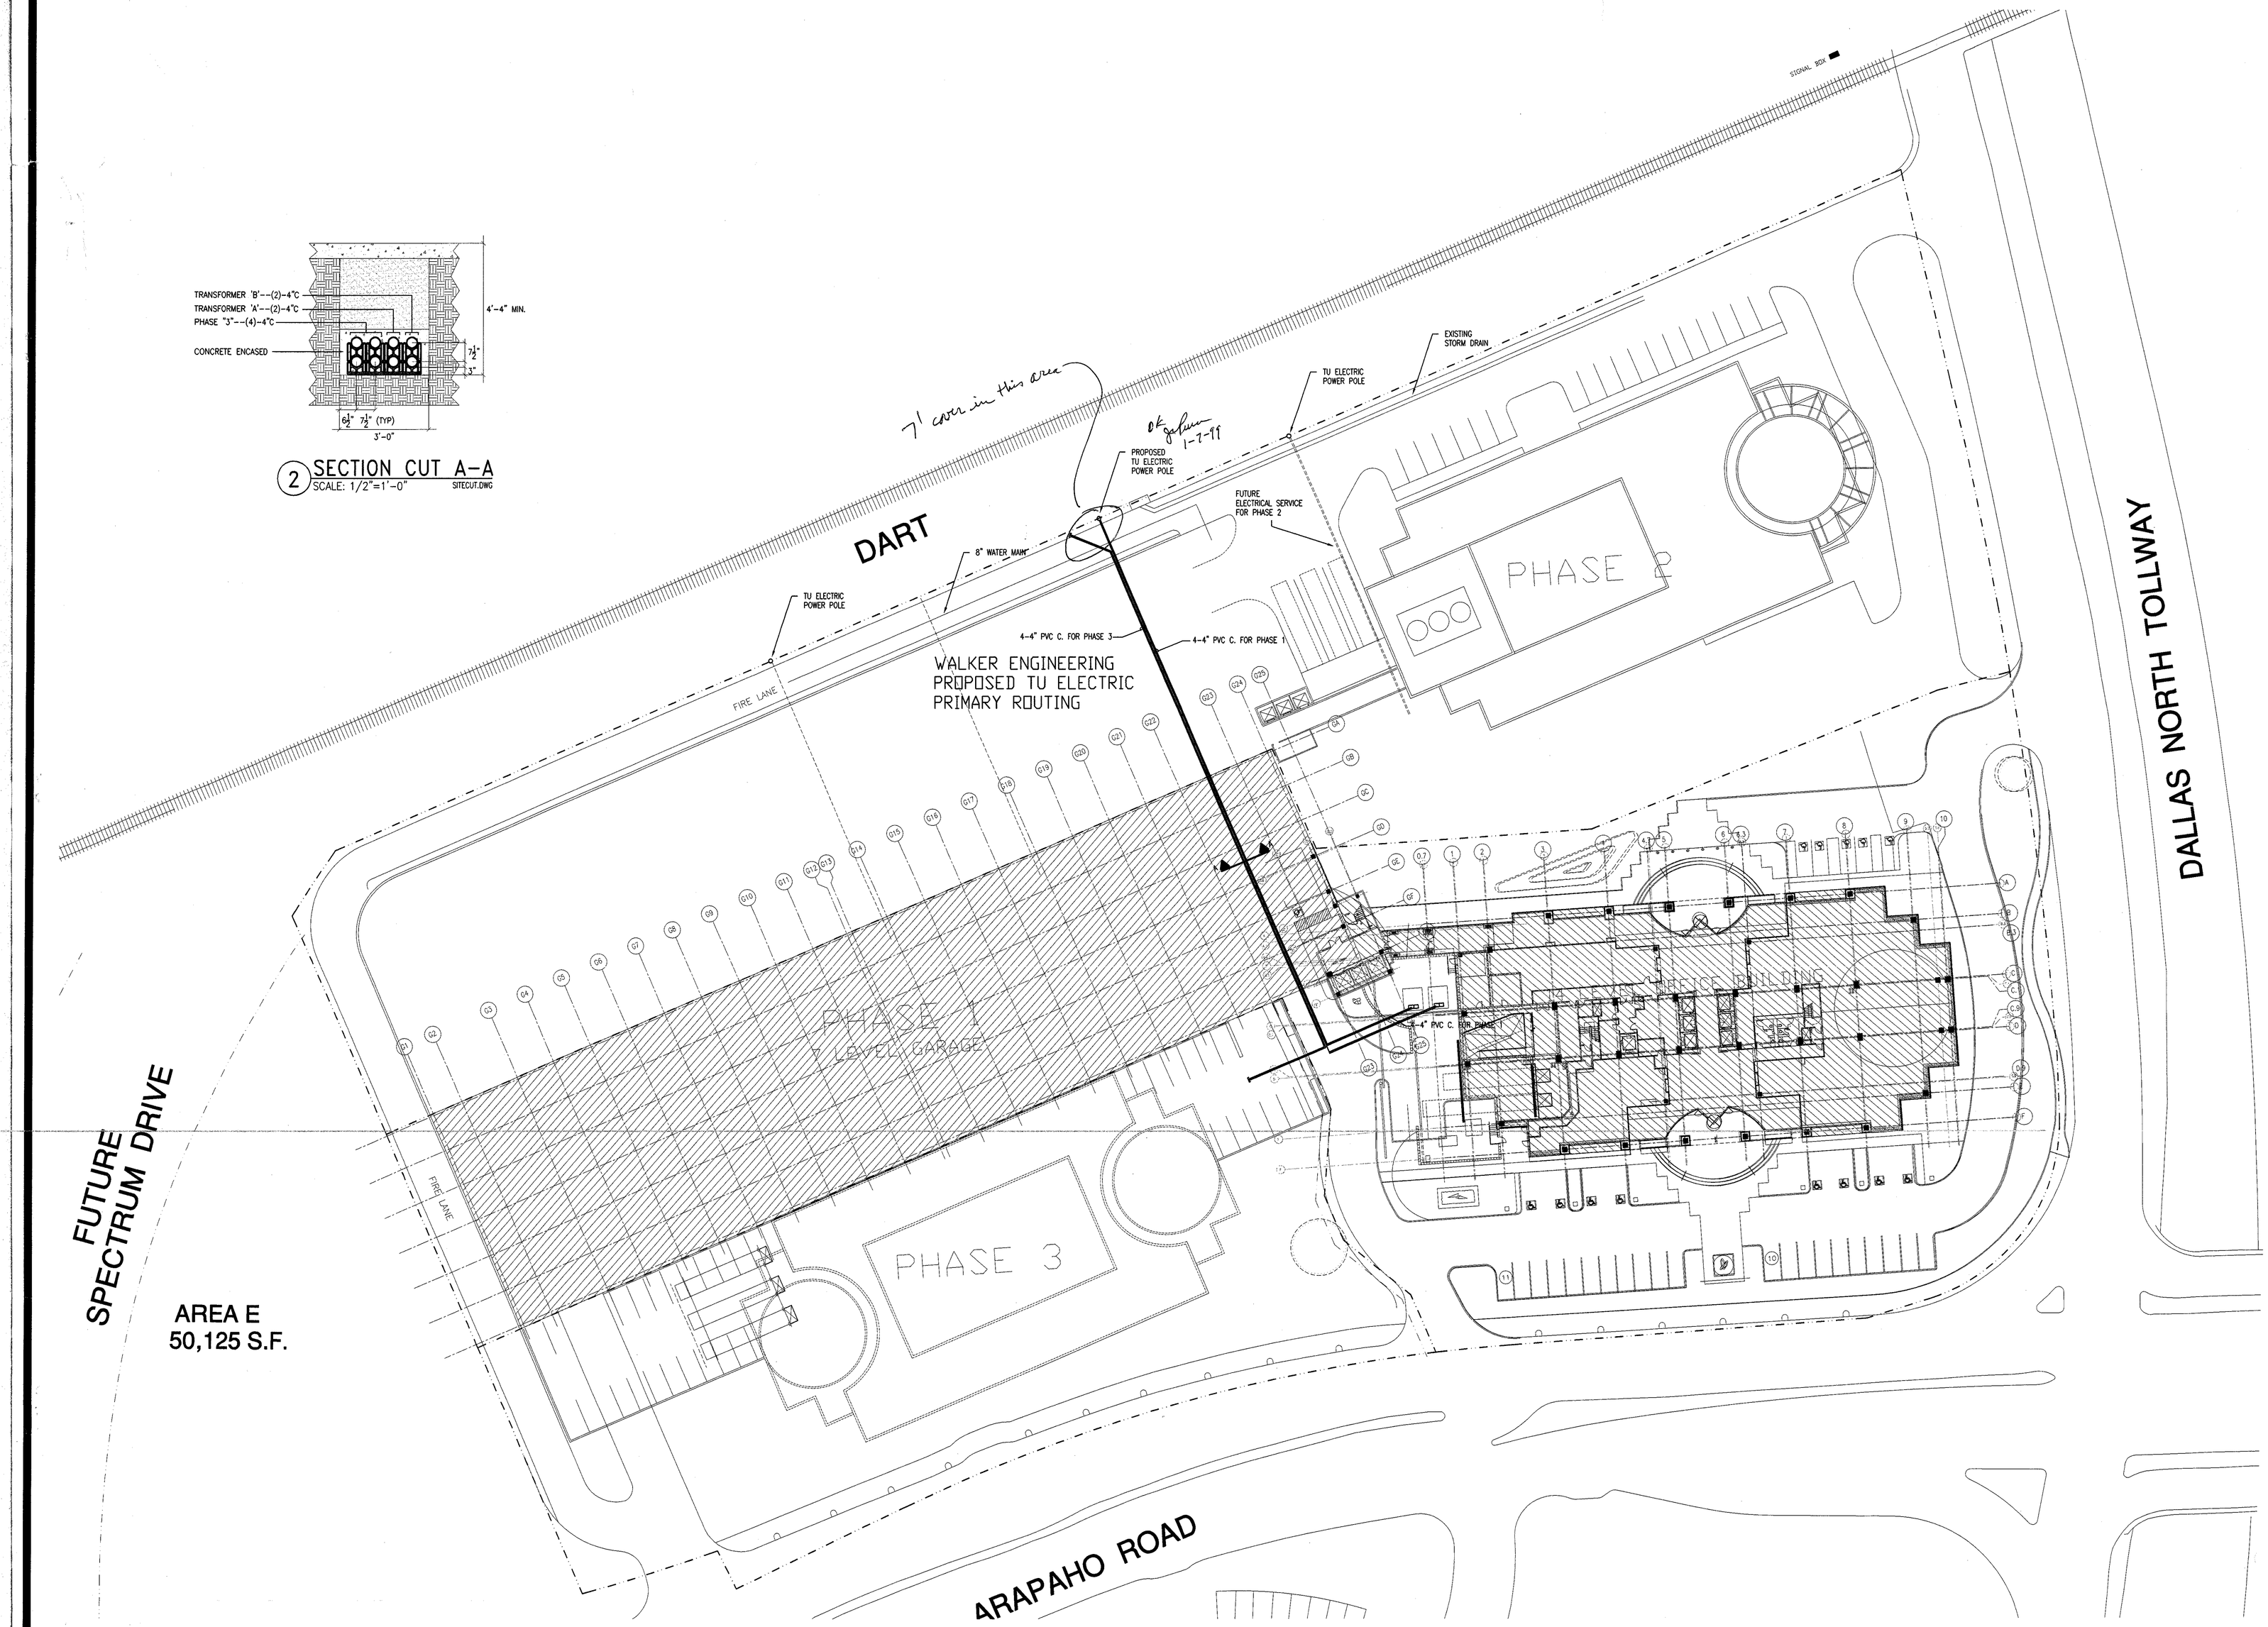

2 SECTION CUT A-A
SCALE: 1/2"=1'-0" SITECUT.DWG

1 ELECTRICAL SITE PLAN
SCALE: 1"=30' MILEPN02.DWG

The information contained on this drawing is the property and trade secret of Walker Engineering, Inc. and may not be reproduced without the express written permission of Walker Engineering, Inc. © Walker Engineering, Inc. 1999

B18-1

WALKER ENGINEERING, INC.
ELECTRICAL CONTRACTORS
DALLAS - FT. WORTH - AUSTIN - SAN ANTONIO - HOUSTON

MILLENNIUM

REVISIONS		
1	ADD POWER POLE	1/7/99

SHEET TITLE
SITE PLAN AND DETAILS ELECTRICAL

DRAWN BY	
CHECKED BY	GBB
FILE NAME	AS NOTED
JOB NO.	8814
DATE	1/6/99
SCALE	AS NOTED
SHEET NO.	WE2.01

B18-1