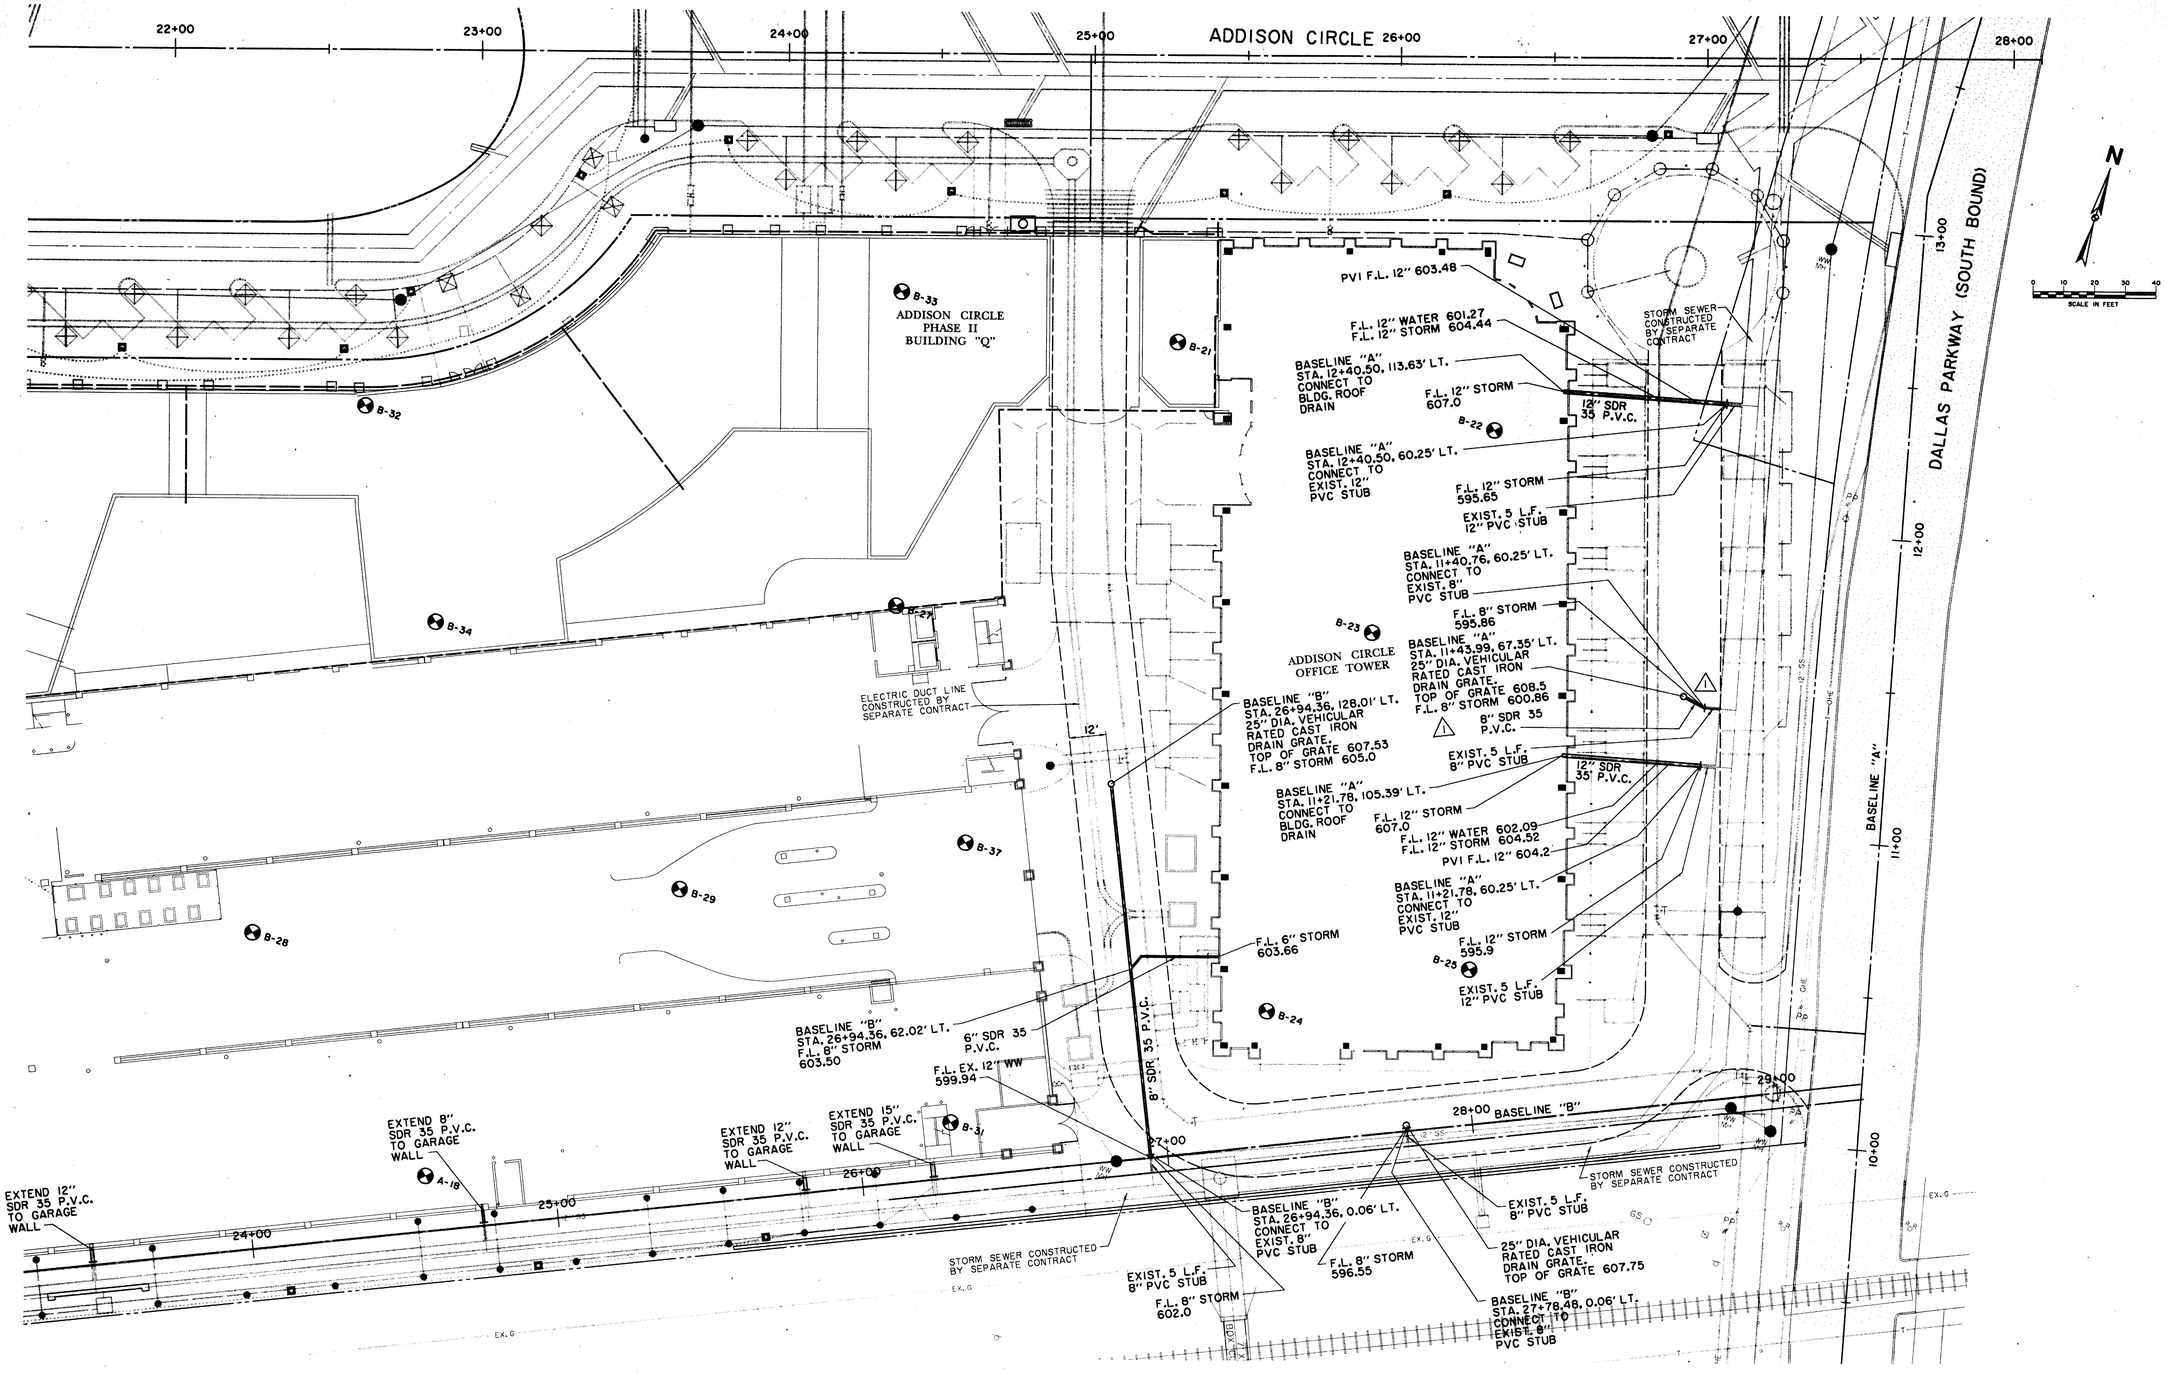

BENCHMARKS:

BM#5
"□" CUT AT NORTHWEST CORNER OF NORTH HDWL. OF 7'X7' BOX CULVERT UNDER RAILROAD, 180' WEST OF DALLAS PARKWAY SOUTHBOUND.
ELEV. 610.49

BM#6
"□" CUT AT CENTER FRONT OF 18' REC. INLET, SECOND INLET NORTH OF RAILROAD TRACKS ON THE WEST SIDE OF DALLAS PARKWAY SOUTHBOUND.
ELEV. 605.67

THE SEAL APPEARING ON THIS DOCUMENT WAS AUTHORIZED BY DAVID E. MEYERS, P.E. 81512 ON JAN. 16, 1998.

STATE OF TEXAS
DAVID E. MEYERS
81512
REGISTERED
PROFESSIONAL ENGINEER

1/16/98

CHAMPION
REAL ESTATE STRATEGY AND IMPLEMENTATION
CHAMPION PARTNERS
5430 LBJ Freeway Suite 1565 Dallas, Texas 75240
(972) 490-5600 Fax (972) 490-5292

ADDISON CIRCLE OFFICE BUILDING
TEXAS
ADDISON

CROCKETT DAVIS SHAKE, Inc.
Consulting engineers
Civil & Structural Engineering Surveying
4144 N. Central Expressway, Suite 1100 Dallas, Texas 75204
(214)824-0847 Fax (214)824-2266

JAMES JOHNSTON & ASSOCIATES, INC.
Engineers Surveyors
2711 North Haskell Avenue
Suite 2400, Lb 22
Dallas, TX 75204
Tel: (214) 823-8181, Fax (214) 823-2483

HUITT-ZOLLARS, INC.
3131 McKinney Ave., Suite 600
Dallas, TX 75204 214-871-3311

HKS

HKS Inc. Architects-Engineers-Planners
700 N. Pearl, Suite 1100, LB 307
Dallas, Texas 75201-7485 (214) 969-5599

Job No: 5494

ISSUED FOR CONSTRUCTION

15 OCT. 1997

1 SHIFTED INLET LOCATION 1/16/98

Revision:

Date:

Sheet Title:
DRAINAGE PLAN

Sheet No:
C6

© 1997 HKS Inc.

File:

1	2	3	4	5

5494-1-TB

Plot date:
20 JUN 97

3002-IB-14828-IFP-STLS