

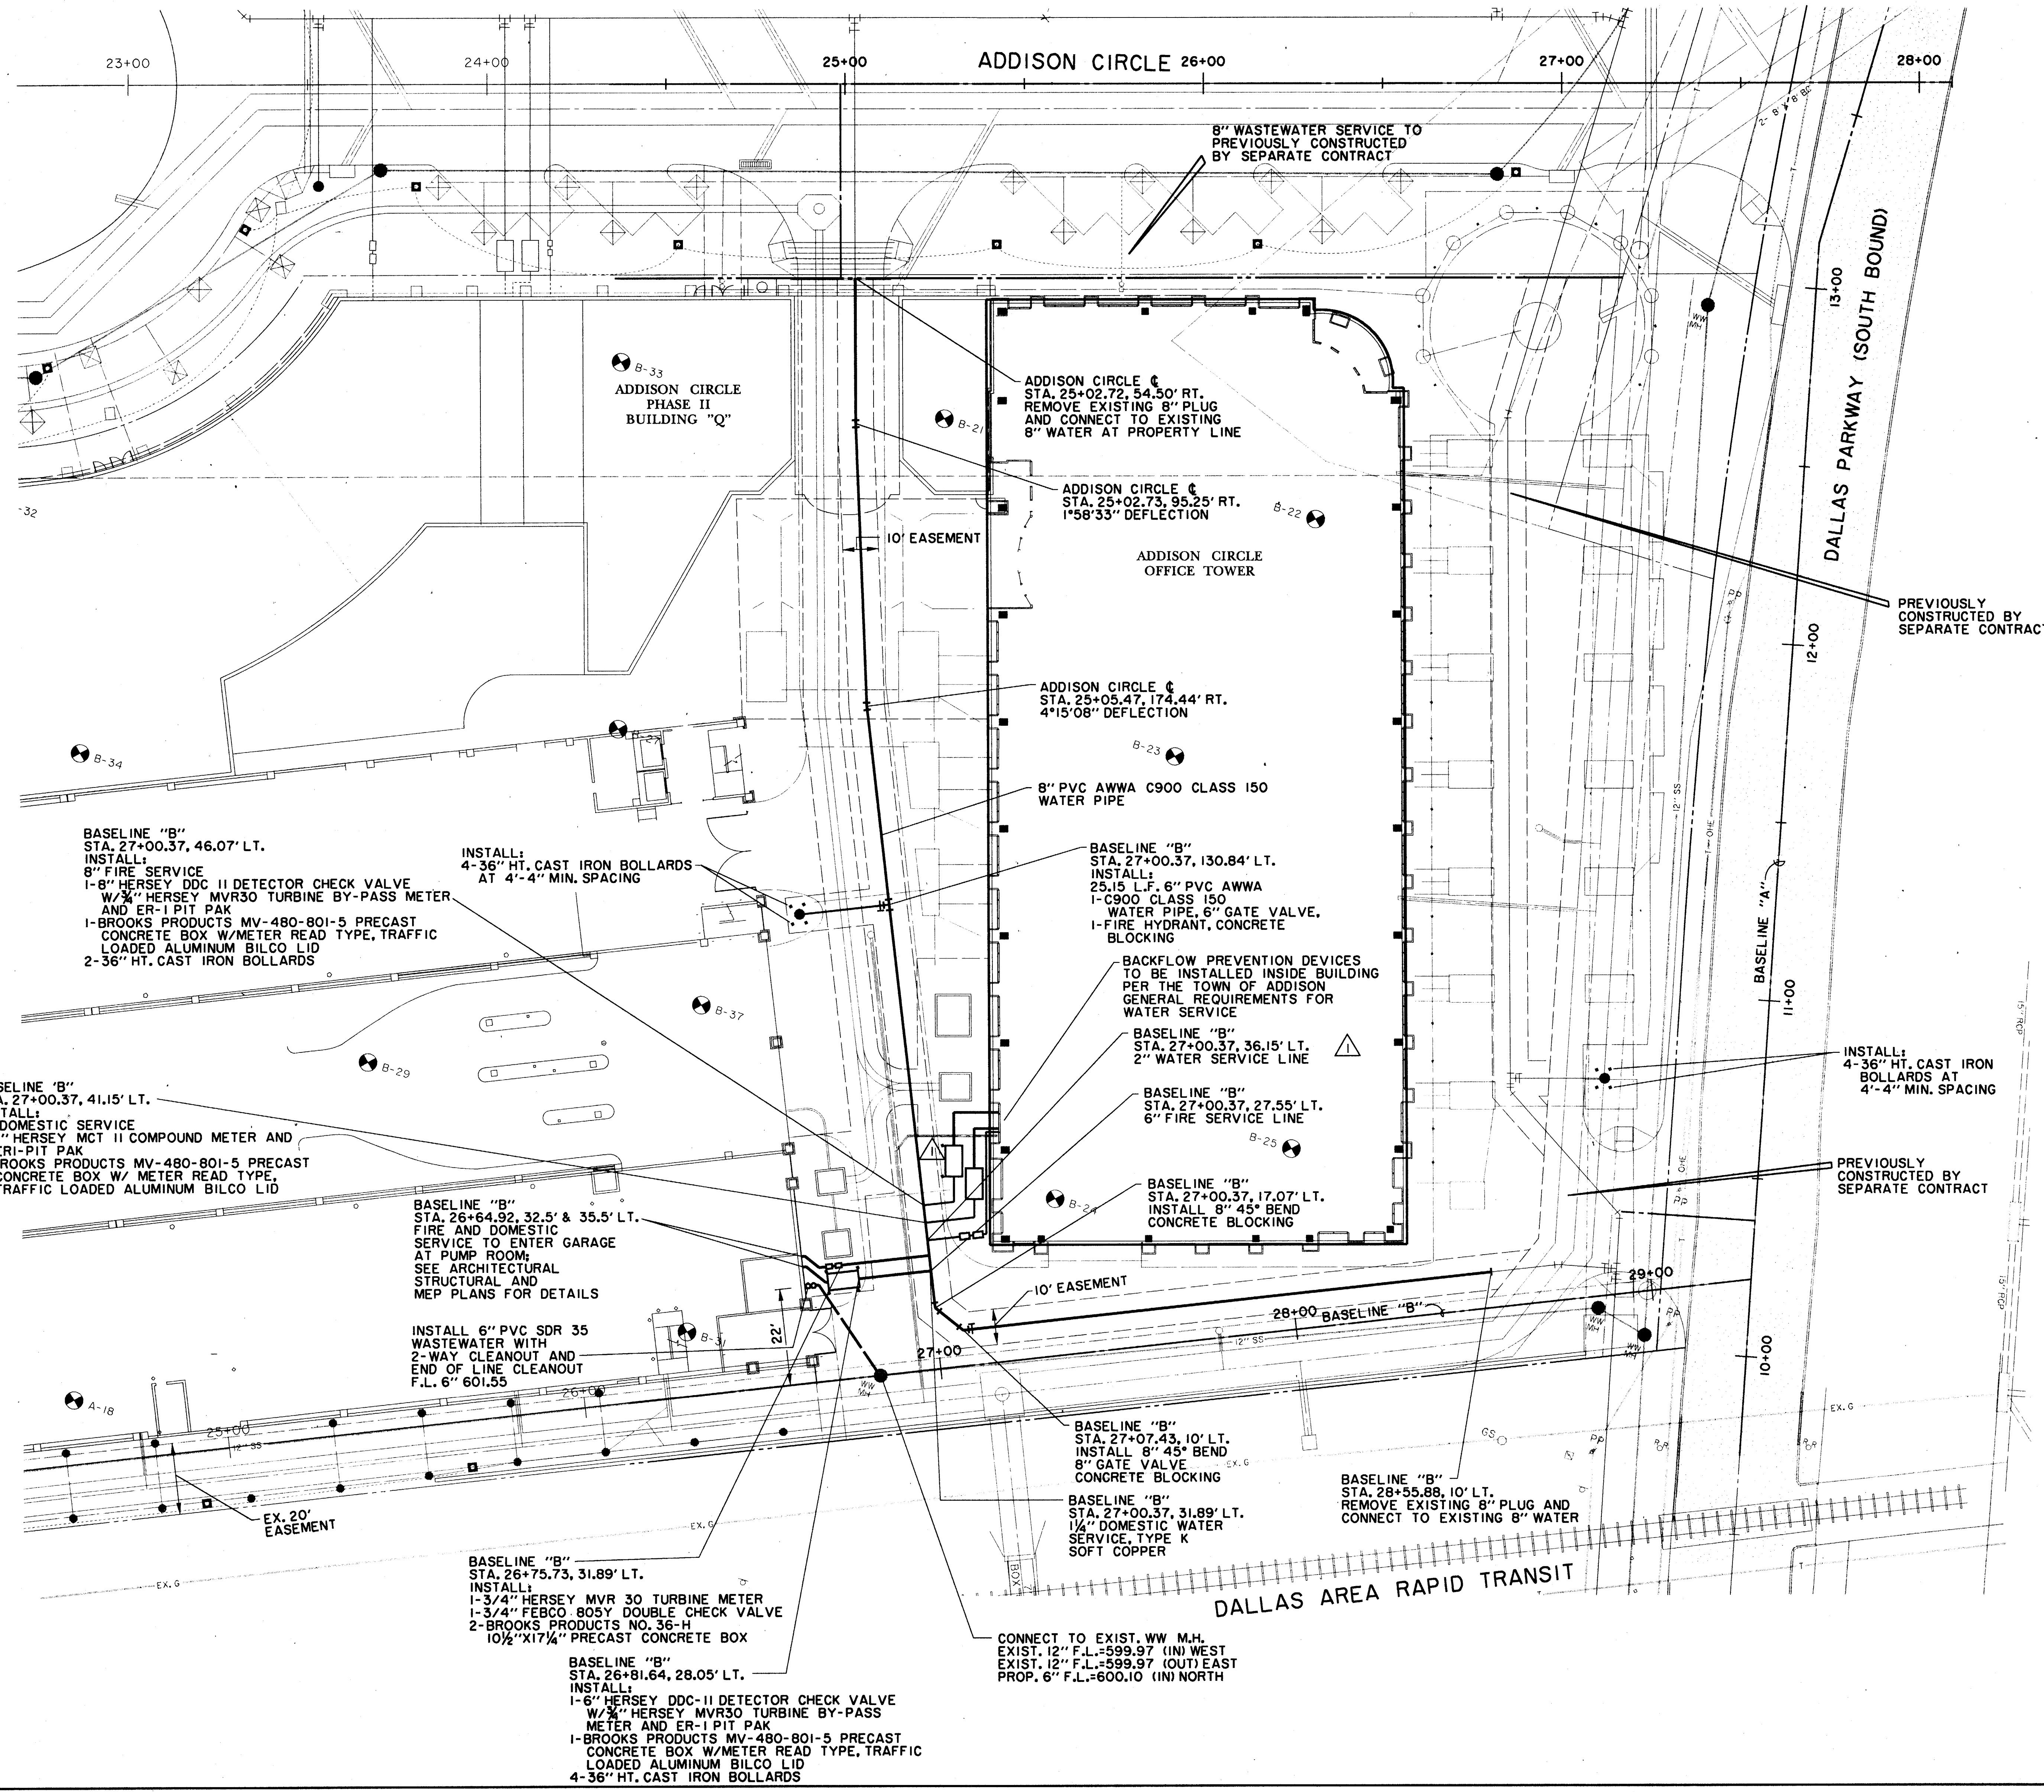


ADDISON CIRCLE OFFICE BUILDING

ADDISON TEXAS

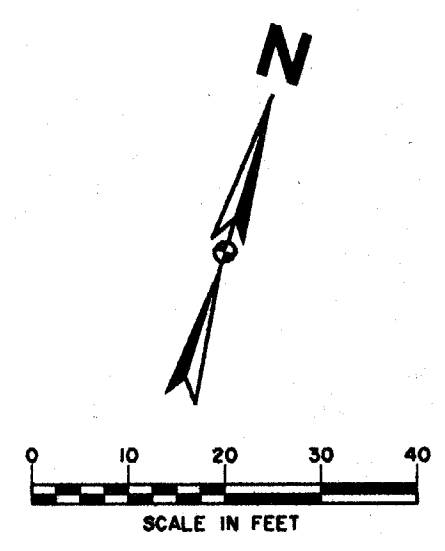

PROPERTY OWNER: HUITT-ZOLLARS, INC.
 3101 McKinney Ave., Suite 600
 Dallas, TX 75204-7485 (214) 949-5599

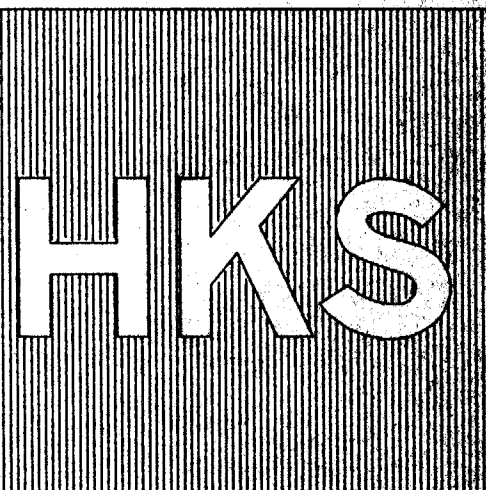


HKS Inc. Architects-Engineers-Planners
 700 N. Pearl, Suite 1100, LB 307
 Dallas, Texas 75201-7485 (214) 949-5599

Job No: 5494
 ISSUED FOR CONSTRUCTION

15 OCT. 1997

ADDED COOLING TOWER SERVICE LINE; SHIFTED VAULTS & BOLLARDS
 1/16/98

Revisions:
 Date:
 Sheet Title: WATER & WASTEWATER PLAN
 Sheet No: C7

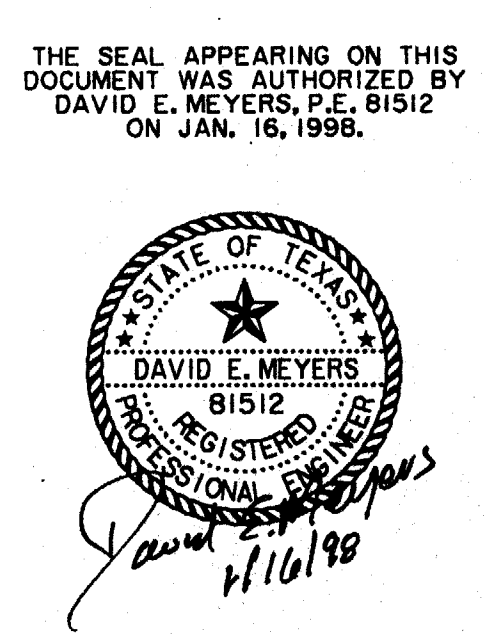

BENCHMARKS:
 BM#5 'C' CUT AT NORTHWEST CORNER OF NORTH HDWL. OF 7'X7' BOX CULVERT UNDER RAILROAD, 150' WEST OF DALLAS PARKWAY SOUTHBOUND. ELEV. 610.49
 BM#6 'C' CUT AT CENTER FRONT OF 10' REG. INLET, SECOND INLET NORTH OF RAILROAD TRACKS ON THE WEST SIDE OF DALLAS PARKWAY SOUTHBOUND. ELEV. 605.67

PLANNING & DESIGN
 CIVIL ENGINEERING
 10/19/97

PLANNING & DESIGN
 CIVIL ENGINEERING
 10/19/97

10/19/97

1	2	3	4	5

20 JUN 97