


9-619

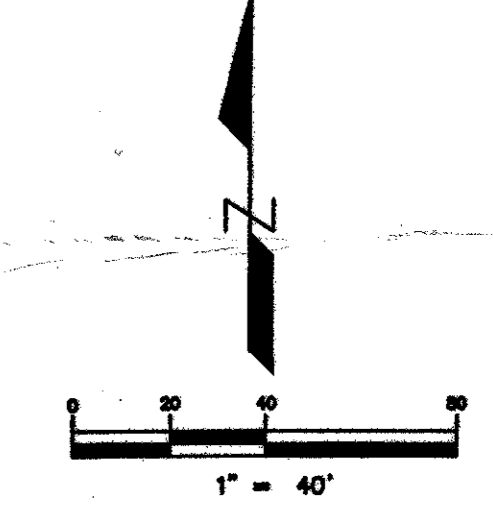

CORGAN

ISSUES

2.0 ISSUE FOR CONSTRUCTION
9/23/02
3.0 FIRELANE/ TOWN COMMENTS
11/12/02

REVISIONS

ADDENDUM NO. 1
SERVICE YARD/WEST ENTRY 9/10/02
ADDENDUM NO. 3

RECEIVED
 11/13/02
 WHITE - JRN
 DALLAS OFFICE


THE SEAL APPEARING ON THIS DOCUMENT WAS AUTHORIZED BY THOMAS P. JONES, P.E. 26887, ON 12/03/01

MBNA
 AMERICASM
 16001 DALLAS PARKWAY
 HALLMARK CENTER SITE HARDENING

TOMDEN ENGINEERING
 12655 N. CENTRAL #1016
 DALLAS, TEXAS 75243
 (972) 386-6446 FAX: (972) 386-6409
 EMAIL: tomden@atmalnet
 JOB No. 100.29

OVERALL PLAN

JOB 02143.00
 DATE 12 NOV 02
 SHEET
C1.0 B19-6

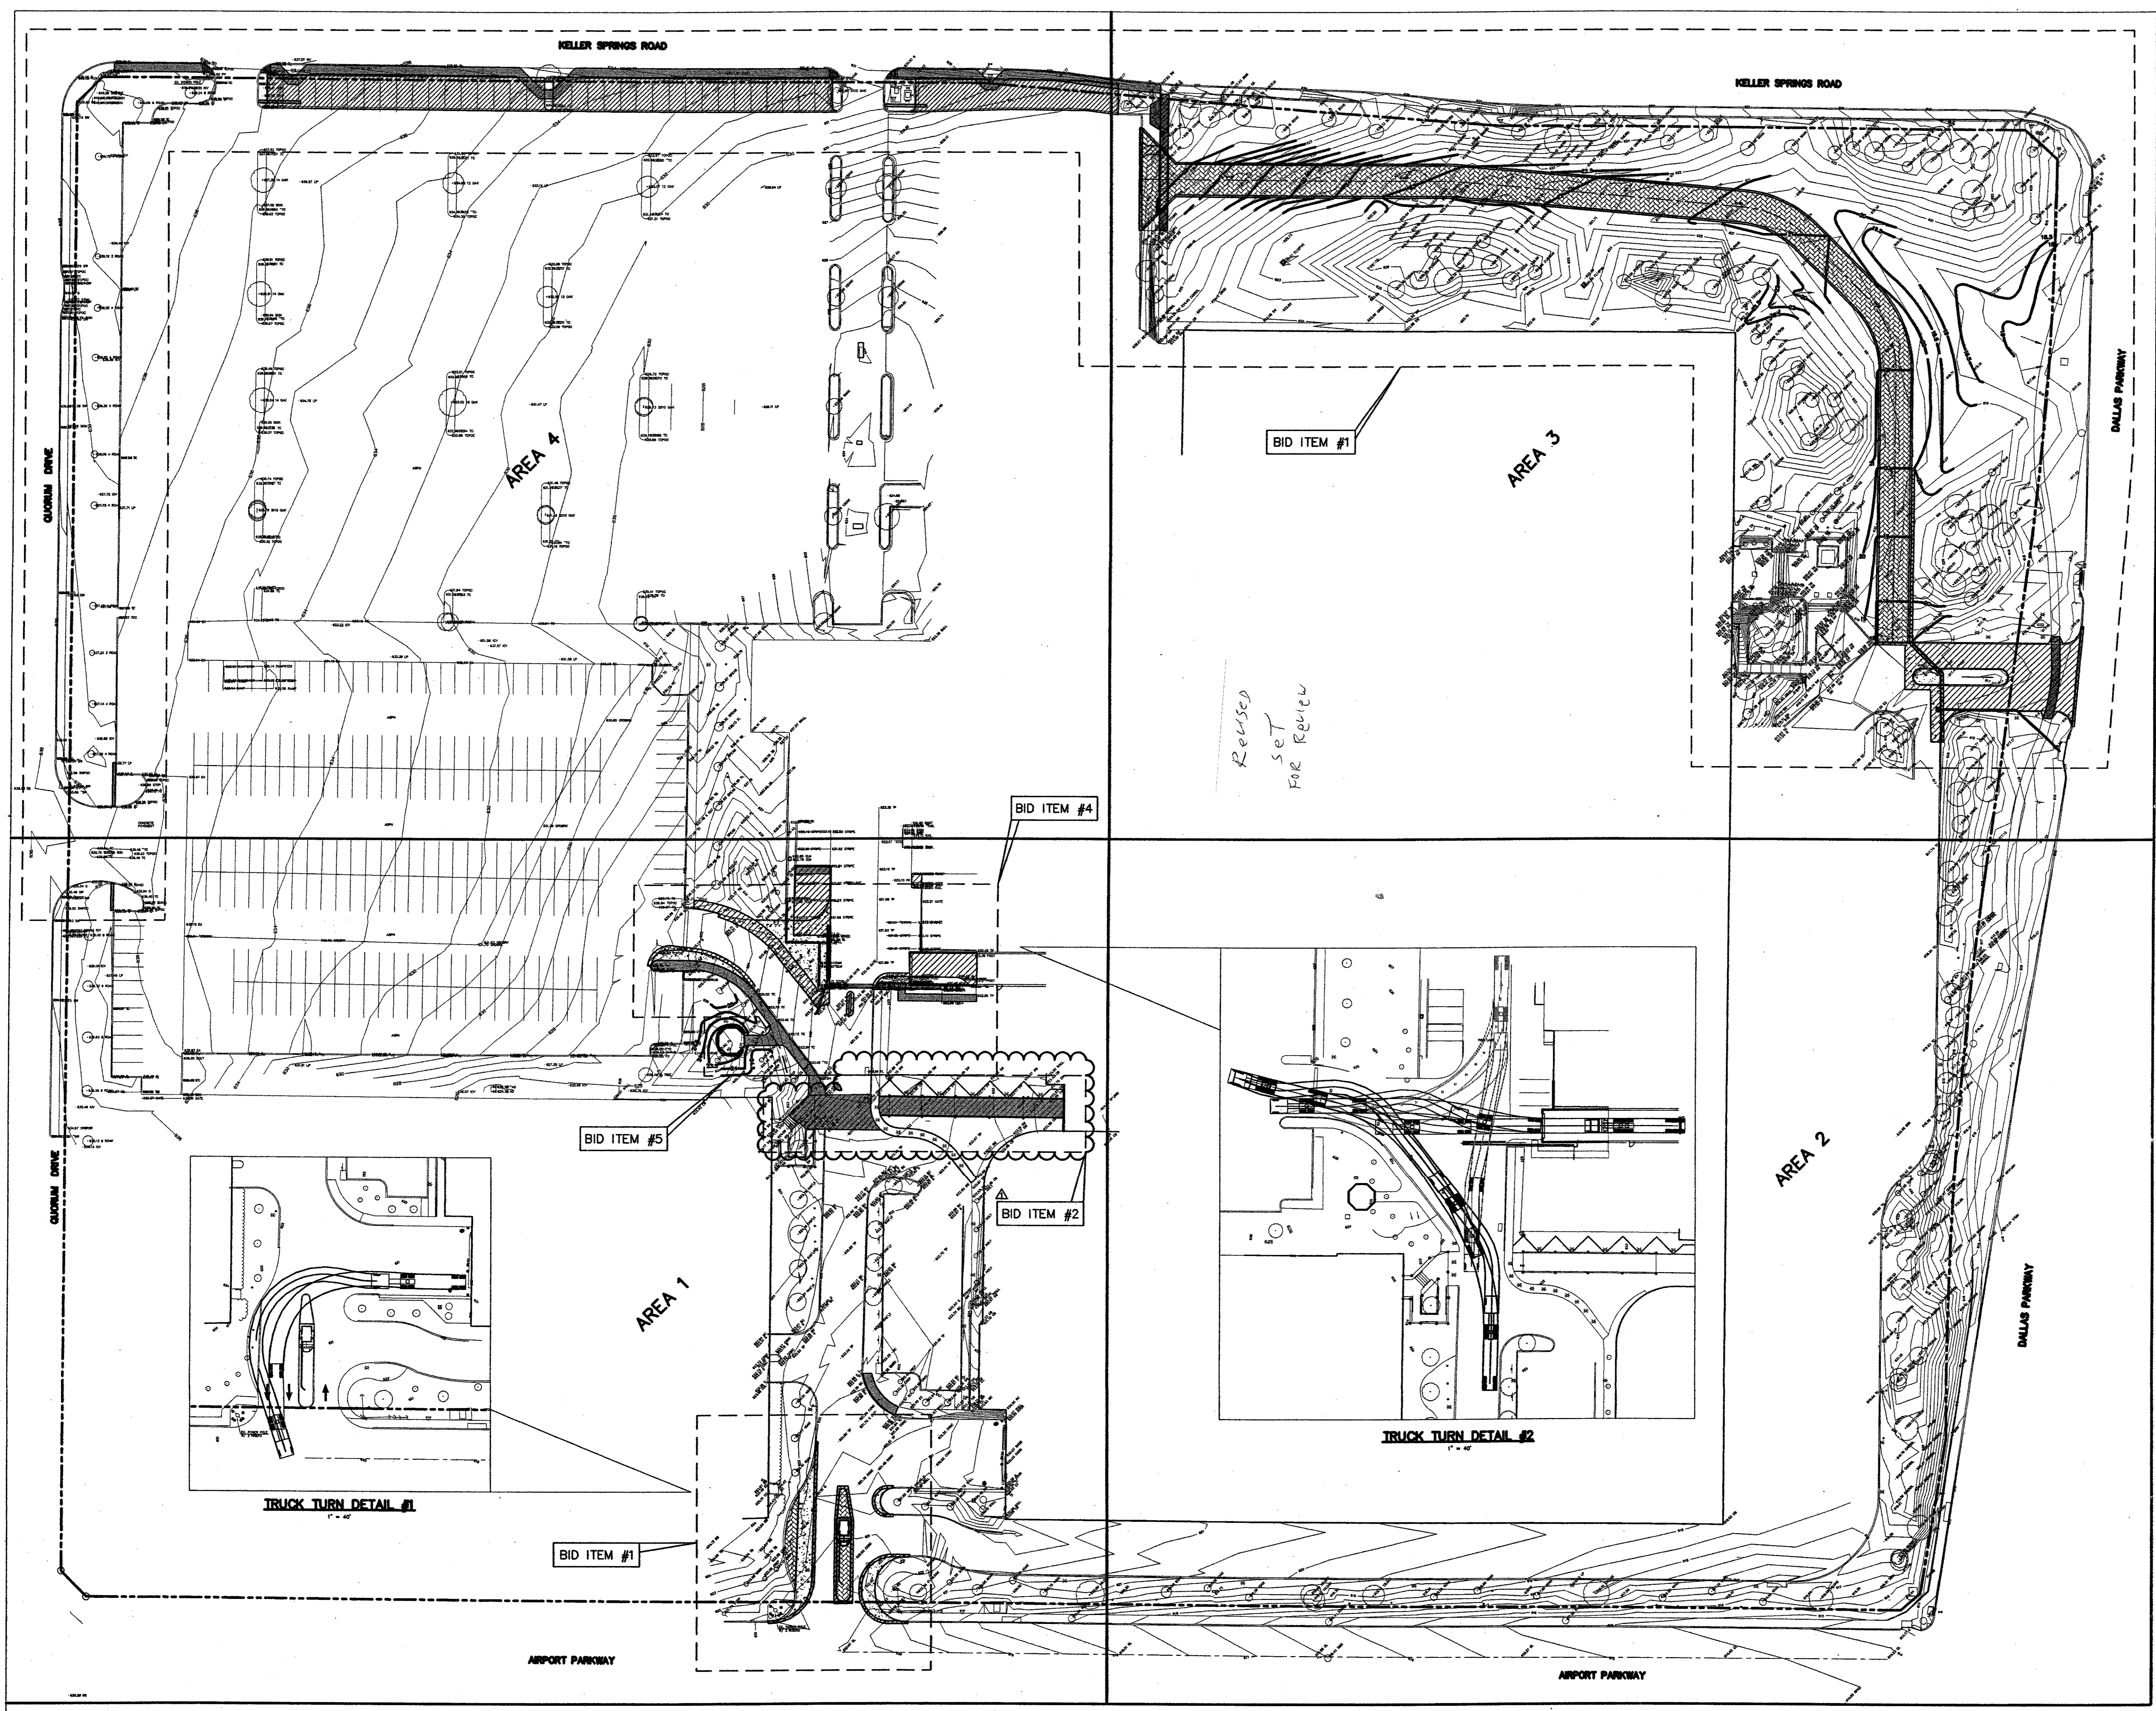

11/12/02 15:26 C:\cond Projects\100-29\dwg\01SITE.dwg 11/12/2002 03:26:43 PM PM CST