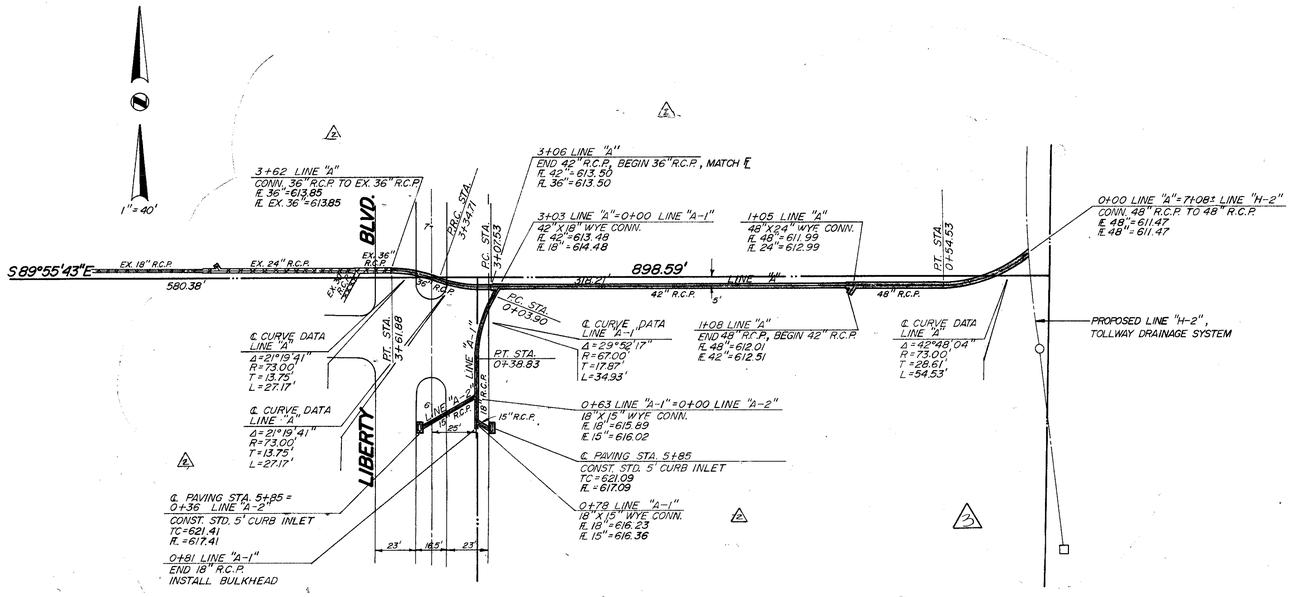

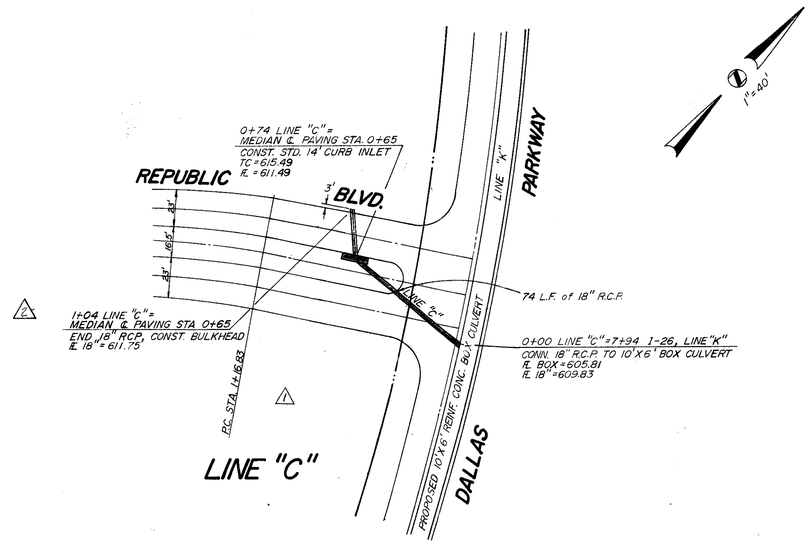

△3 2-5-85 REVISE GRADES LINE "A"
△2 1-30-85 REVISE PAVING AND STORM SEWER
△1 11-19-84 REVISE FLOW DATA

BM No. 1
Square cut on top of curb at the radius return of an island located near the northeast corner of Liberty Plaza 1, approximately 639 feet north of the southeast property corner.
Elevation 622.14

BM No. 2
Chisled square on the end of the curb radius located on the driveway on the north side of Keller Springs Road, approximately 500 feet west of Dallas Parkway.
Elevation 626.24

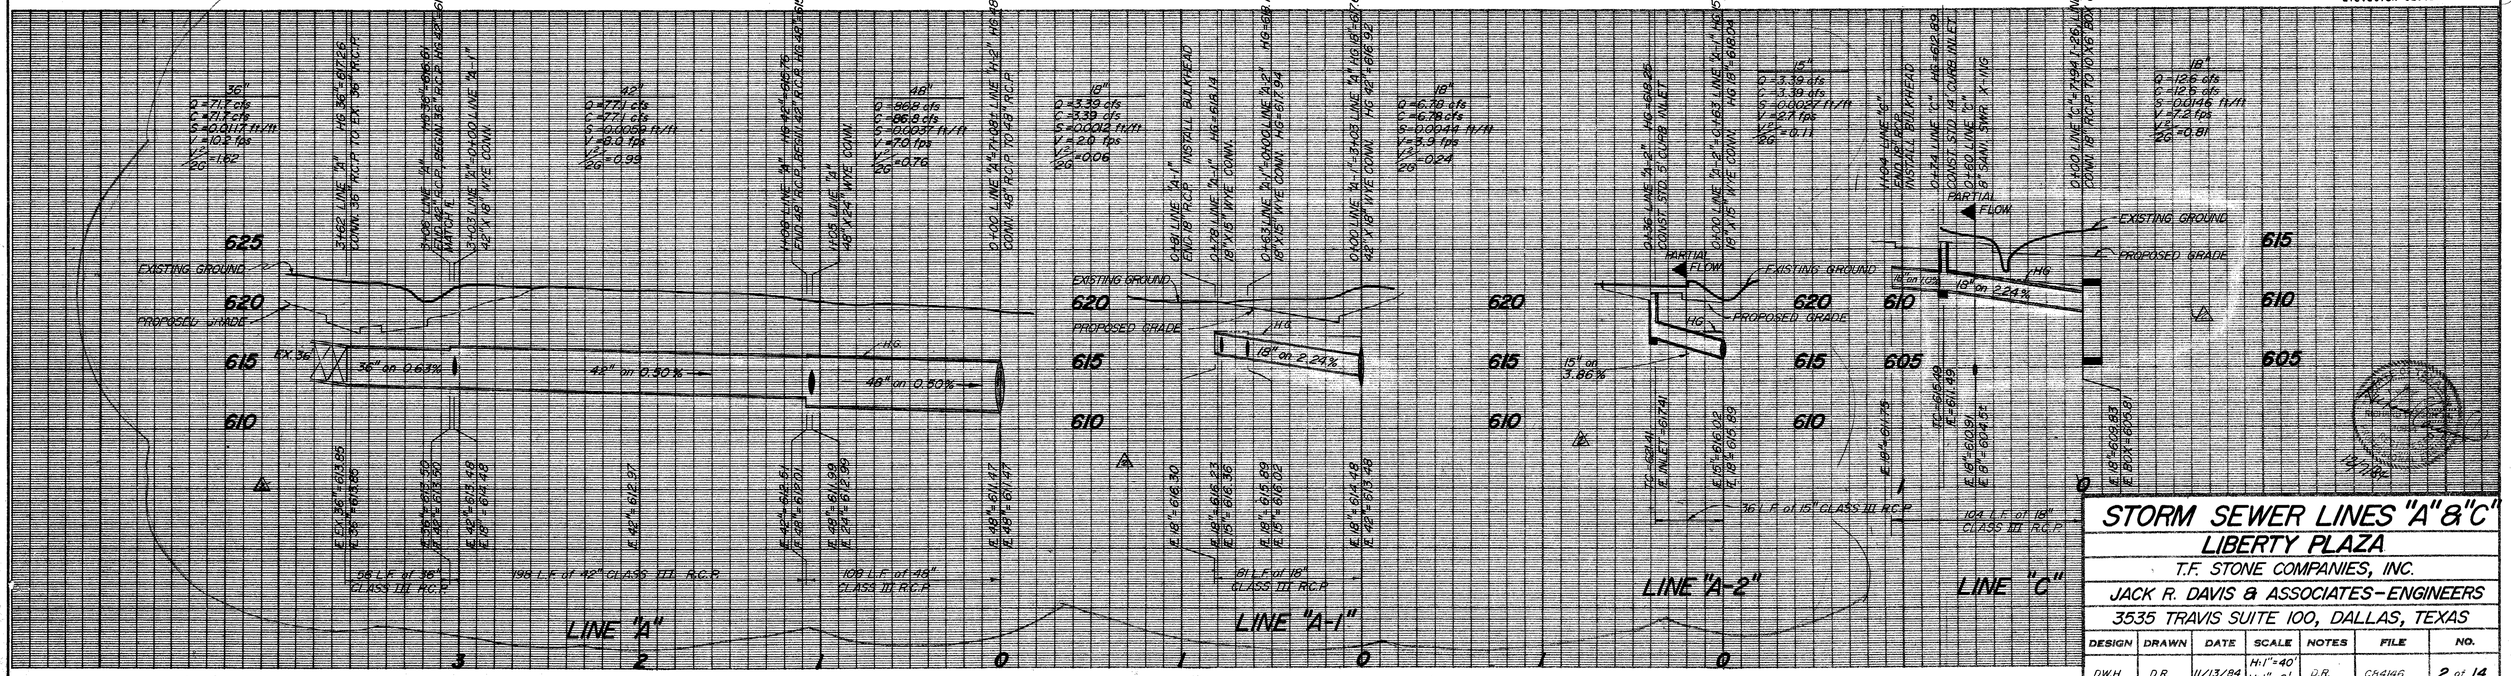

STORM SEWER LINES "A" & "C"

LIBERTY PLAZA

T.F. STONE COMPANIES, INC.

JACK R. DAVIS & ASSOCIATES-ENGINEERS

3535 TRAVIS SUITE 100, DALLAS, TEXAS

DESIGN	DRAWN	DATE	SCALE	NOTES	FILE	NO.
D.W.H.	D.R.	11/13/84	H:1"=40' V:1"=6'	D.R.	C84146	2 of 14