


REVISION LINE "B"
 3-11-86

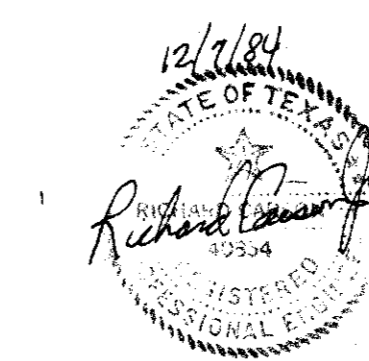

BM No. 1
 Square cut on top of curb at the radius return
 of an island located near the northeast corner of
 Liberty Plaza 1, approximately 639 feet north of
 the southeast property corner.
 Elevation 622.14

BM No. 2
 Chisled square on the end of the curb radius
 located on the driveway on the north side of
 Keller Springs Road, approximately 500 feet west
 of Dallas Parkway.
 Elevation 626.24

SANITARY SEWER PROFILES
LIBERTY PLAZA
 JACK R. DAVIS & ASSOCIATES - ENGINEERS
 3535 TRAVIS SUITE 100, DALLAS, TEXAS

DJR H1"=40' DR C84146 13 of 16
 V1"=6"